



813

PRINCIPAL DIMENSIONS:
 LENGTH BETW. P.P. [FORE PART OF STEM TO AFTER PART OF STERN POST]-- 184'-0"
 BREADTH MOULDED. 30'-0"
 DEPTH. 14'-11"
 LENGTH OF ERECTIONS: FORECASTLE 29'-6", BRIDGE 53'-2", POOP 17'-0"
 HIGHT BETWEEN DECKS OF ERECTIONS 7'-0"

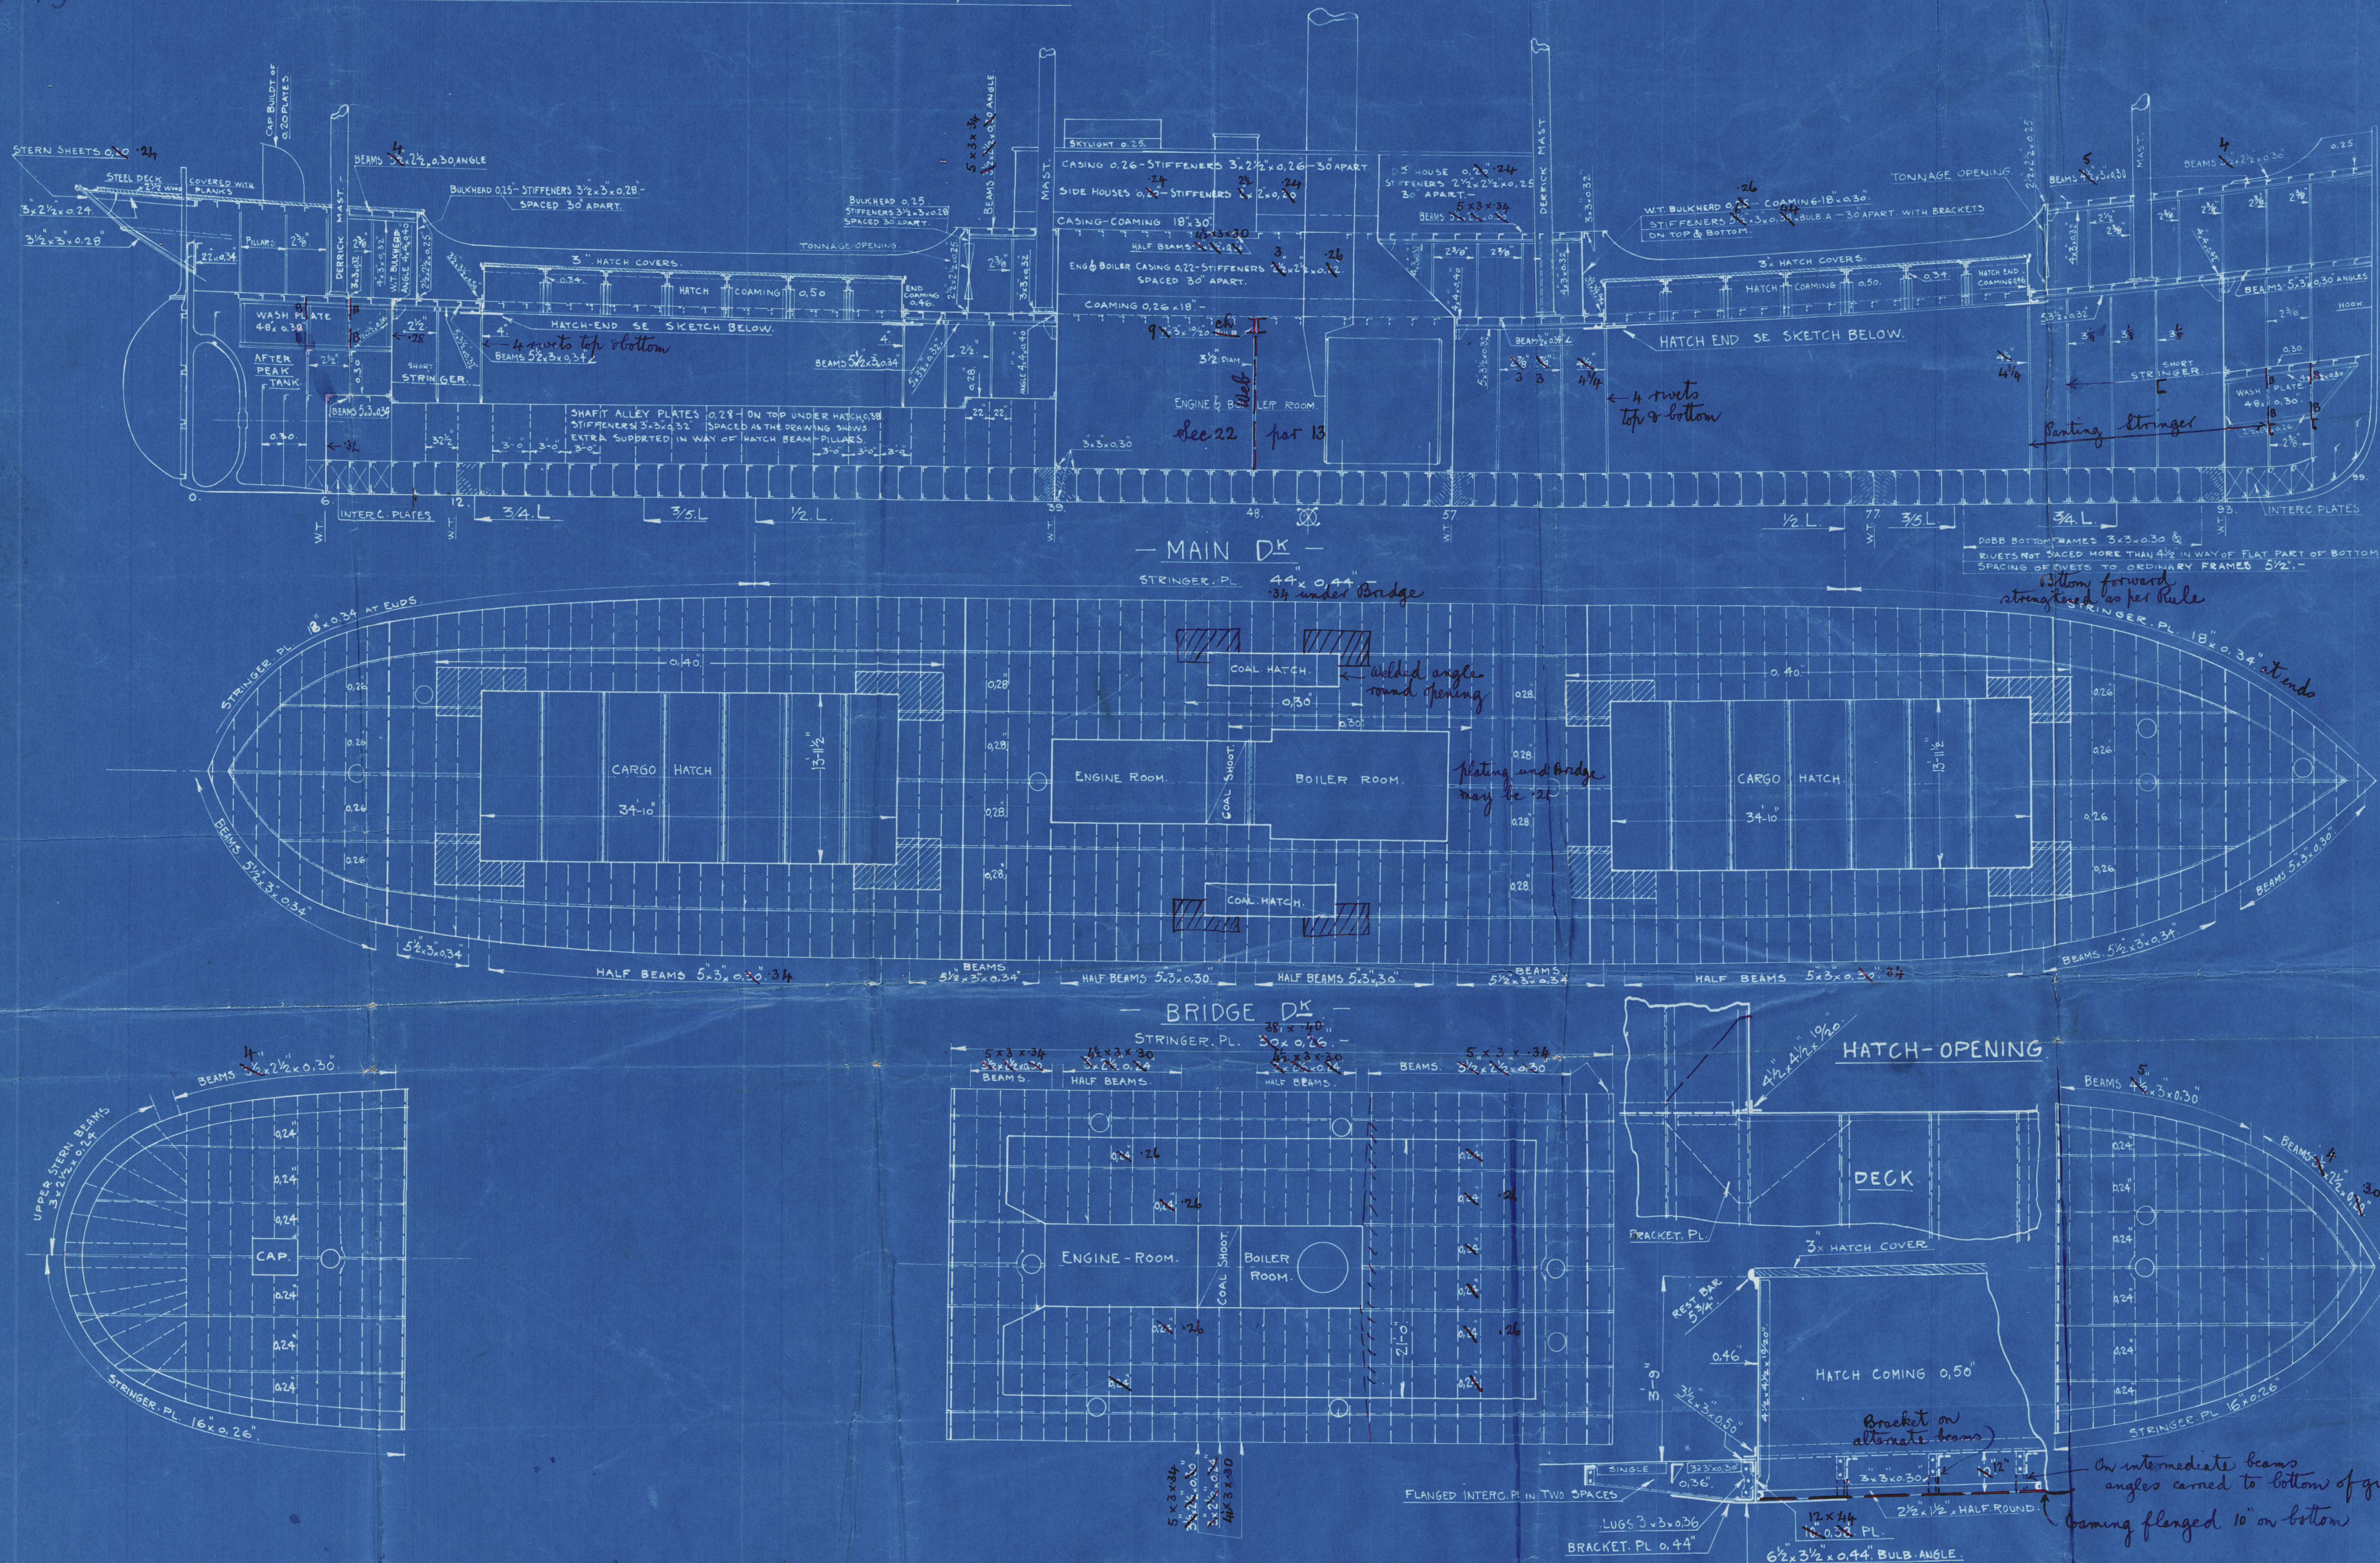

PROFILE - DECK PLANS
 CLASS. 100A. LLOYD'S.
 SCALE 1/8" = 1 FOOT
 SPROG NO. 4. 911. DATTUM
 TEGNET AV 4. 911. TRACED AV 4. 911.
 GJENNEMSEET AV
 TEKNECHET
 APPROBERT AV
 ORDRE NO.

S/S
 S/S No 91.

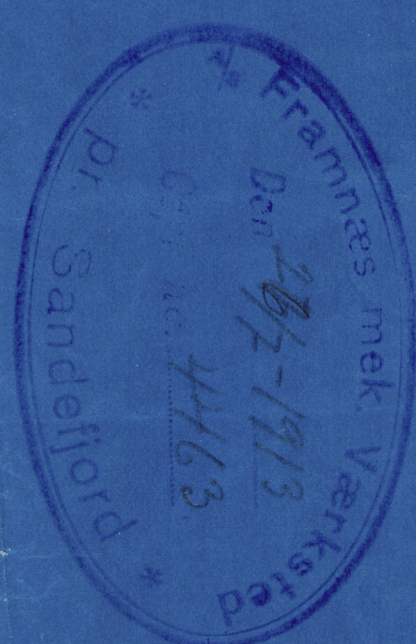

TRACING No. 2175.
 HYLYE No. 73.

ALTERATIONS.		DATE	BY
1.			
2.			
3.			
4.			
5.			
6.			
7.			
8.			
9.			
10.			

TRACING No. 2175.
 HYLYE No. 73.

Profile & Deck plan.

Sl. " Othem "

$$\begin{array}{r} 220 \\ 12 \overline{) 264} \\ \underline{240} \\ 24 \\ \underline{24} \\ 0 \end{array}$$

002269-002278-0068