

20.1.20.

# PROFILE & DECK.



## STEEL SCREW STEAMER

Nº 747.

DIMS 152'-0" B.P. x 25'-0" MLD x 12'-0" MLD.

SCALE 1/4" INCH.

PLAN No. 3903  
FOR ENCLOSURE TO  
Messrs Lloyd's Surveyors  
Hull FROM  
COCHRANE & SONS, LTD.  
SHIPBUILDERS, SELBY.  
DATE 18/1/20

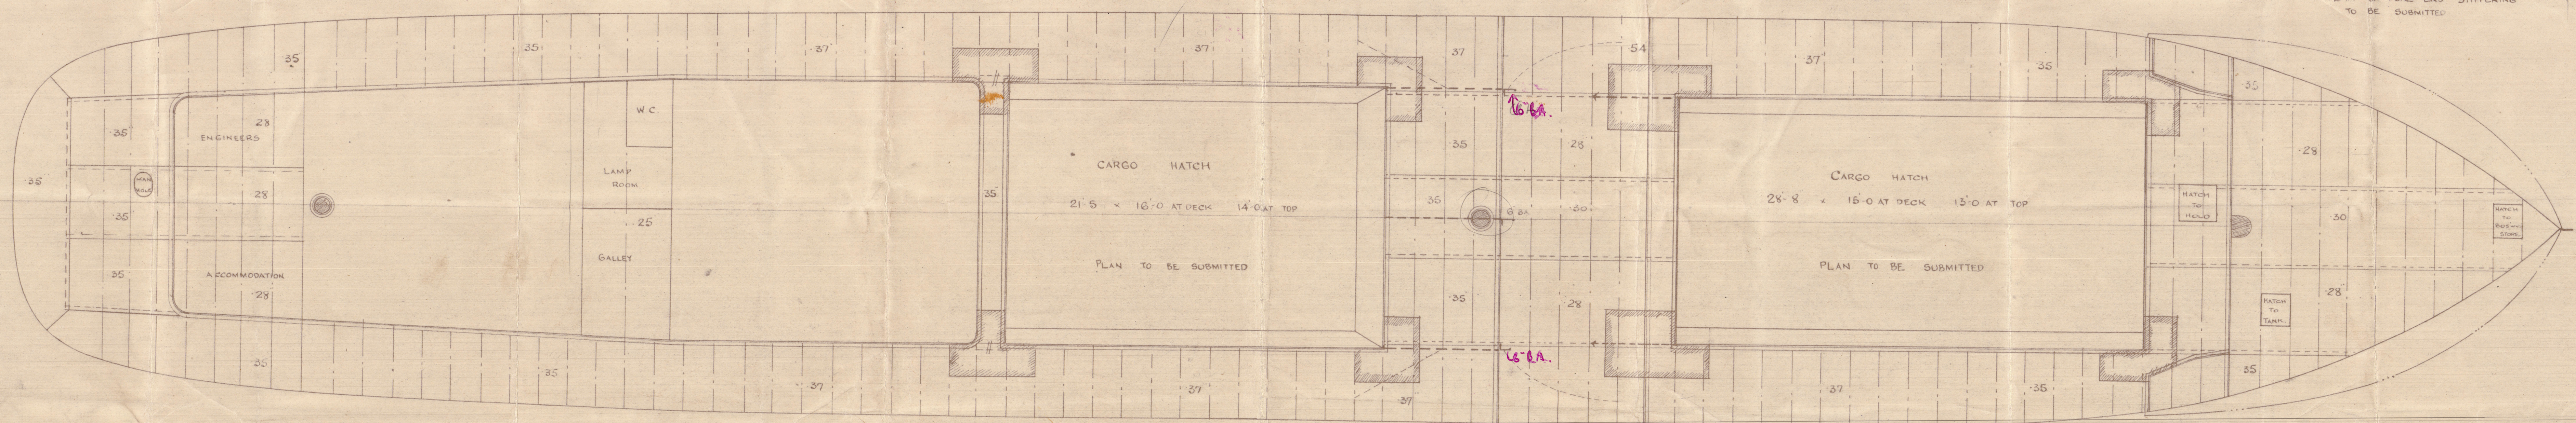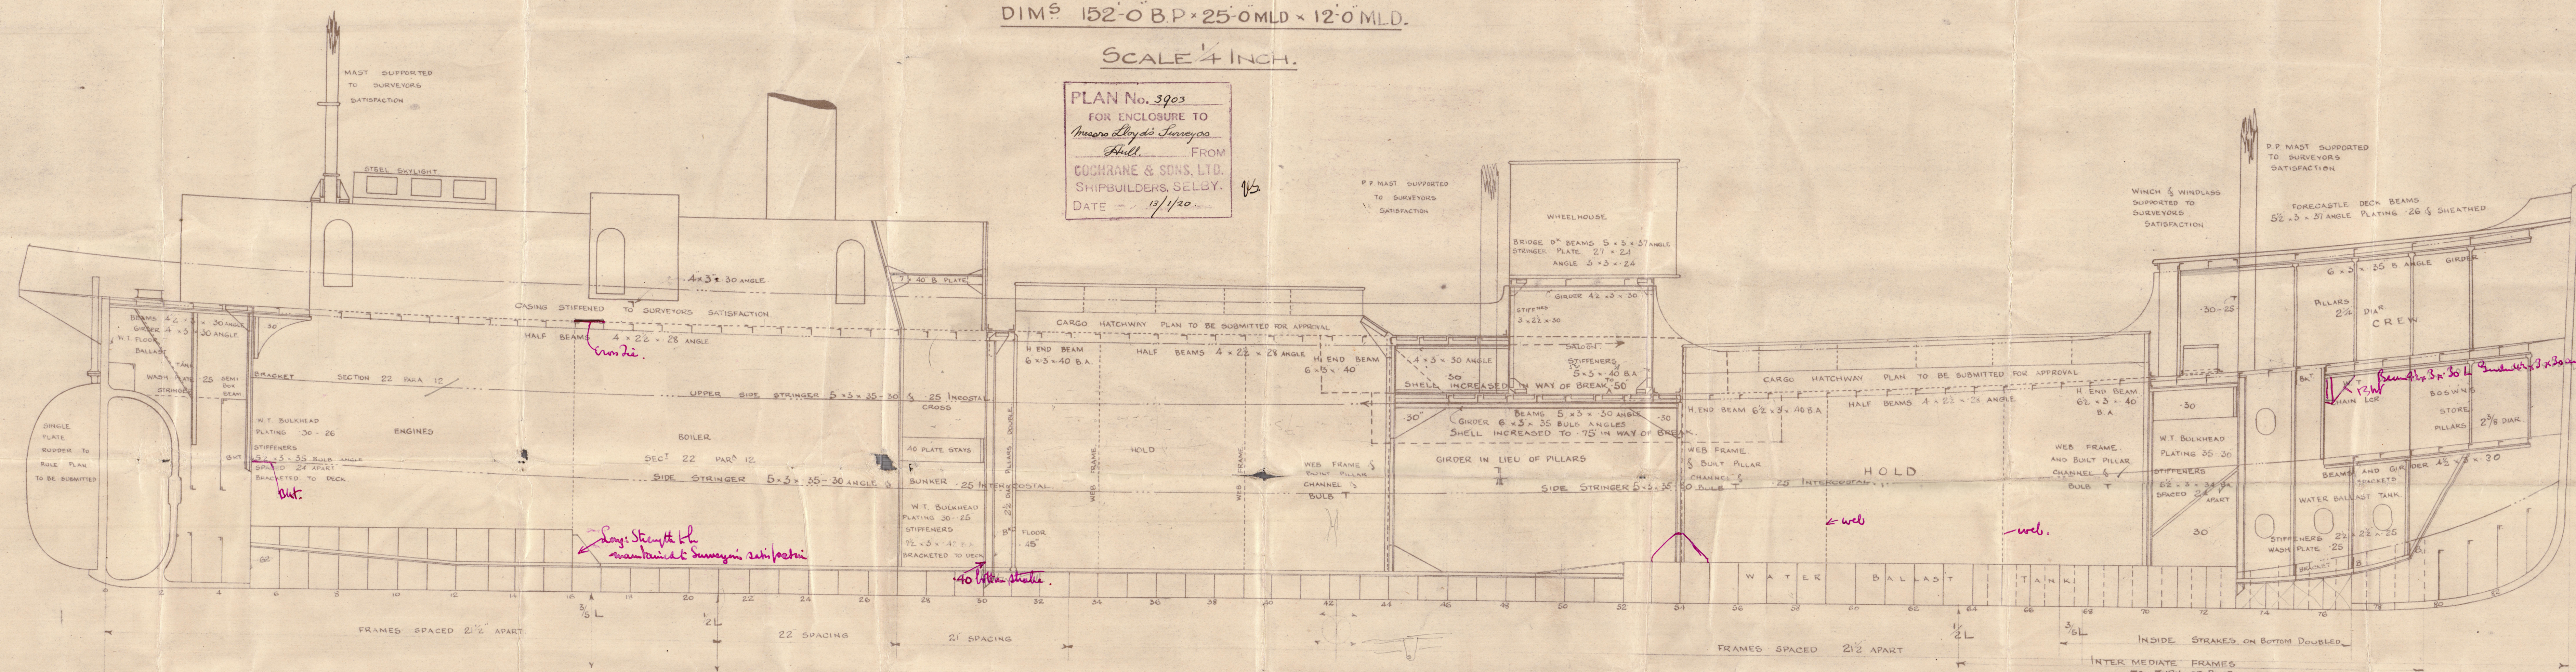

20.1.20.




PROFILE & DECK PLAN.

COCHRANE & SONS LTD

Nº 747

S.S. Margaret Lockington "Hull report No 32416.

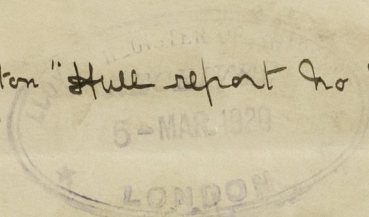

© 2021

Lloyd's Register  
Foundation

002269 - 002278 - 0085