

21.7.16
8/8/16 (730)

PROFILE AND DECK PLAN.

STEEL SCREW STEAMER.

— No 729.4730

DIMENSIONS, 135' OBP x 23' O MLD. x 10' 6 MLD. TO MAIN DECK



TO CLASS 100 A.1.

SCALE 1/4 INCH = ONE FOOT.

PLAN No. 357.
FOR ENCLOSURE TO
Messrs. Lloyd's Register
FROM
COCHRANE & SONS, LTD.
SHIPBUILDERS, LTD.
DATE 6/1/16

12' PITCH PINE MAST
SUPPORTED TO SURVEYORS SATISFACTION.

STRINGER PLATE 14" x 24". TIE PLATES 6" x 24".
DECK STRINGER ANGLE 2 1/2" x 2 1/2" x 25".

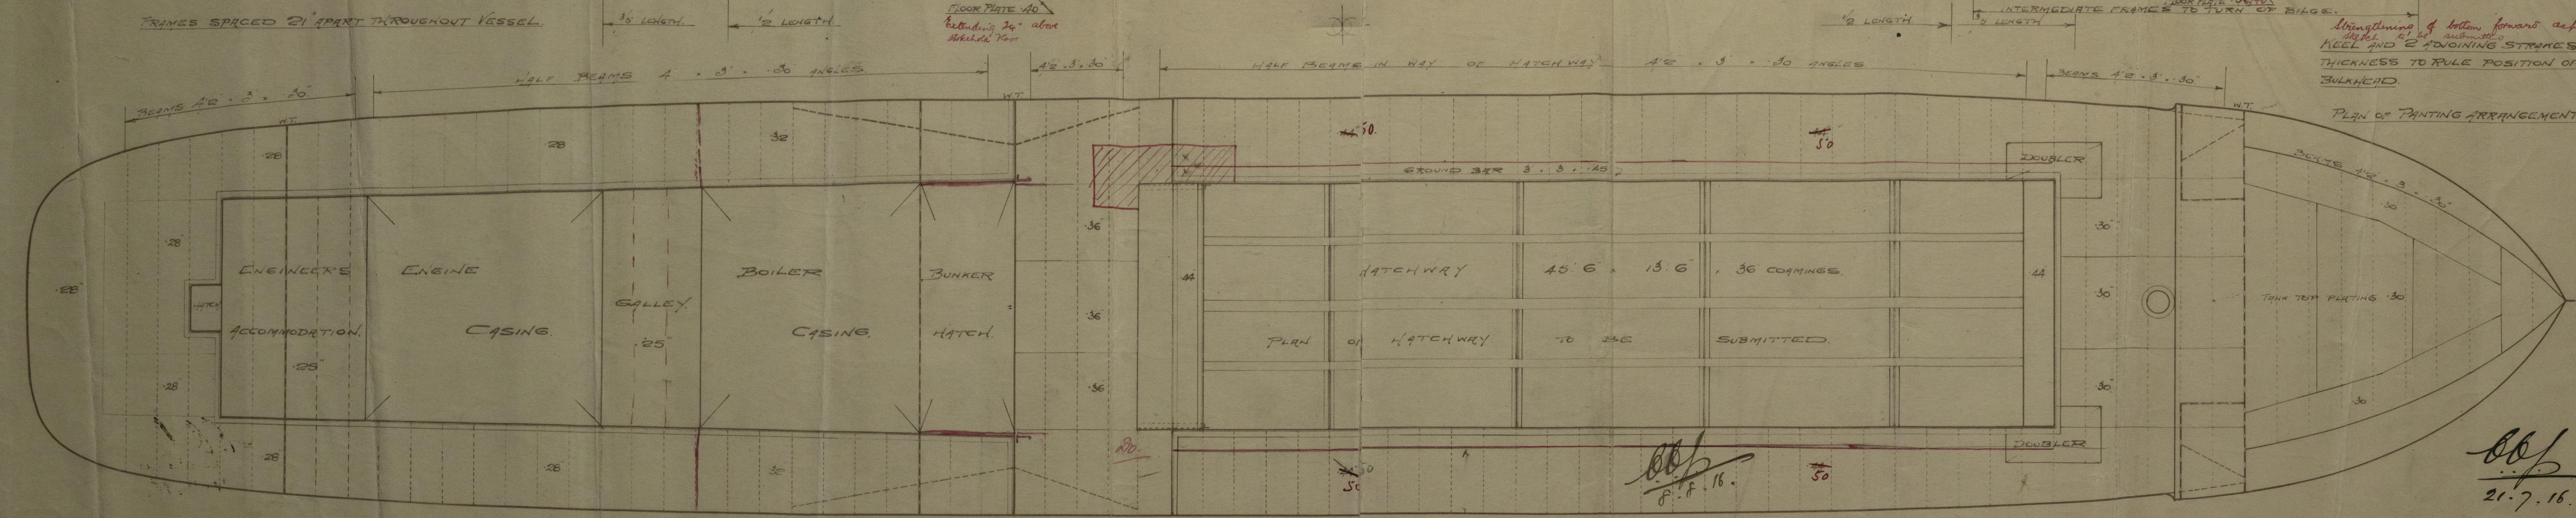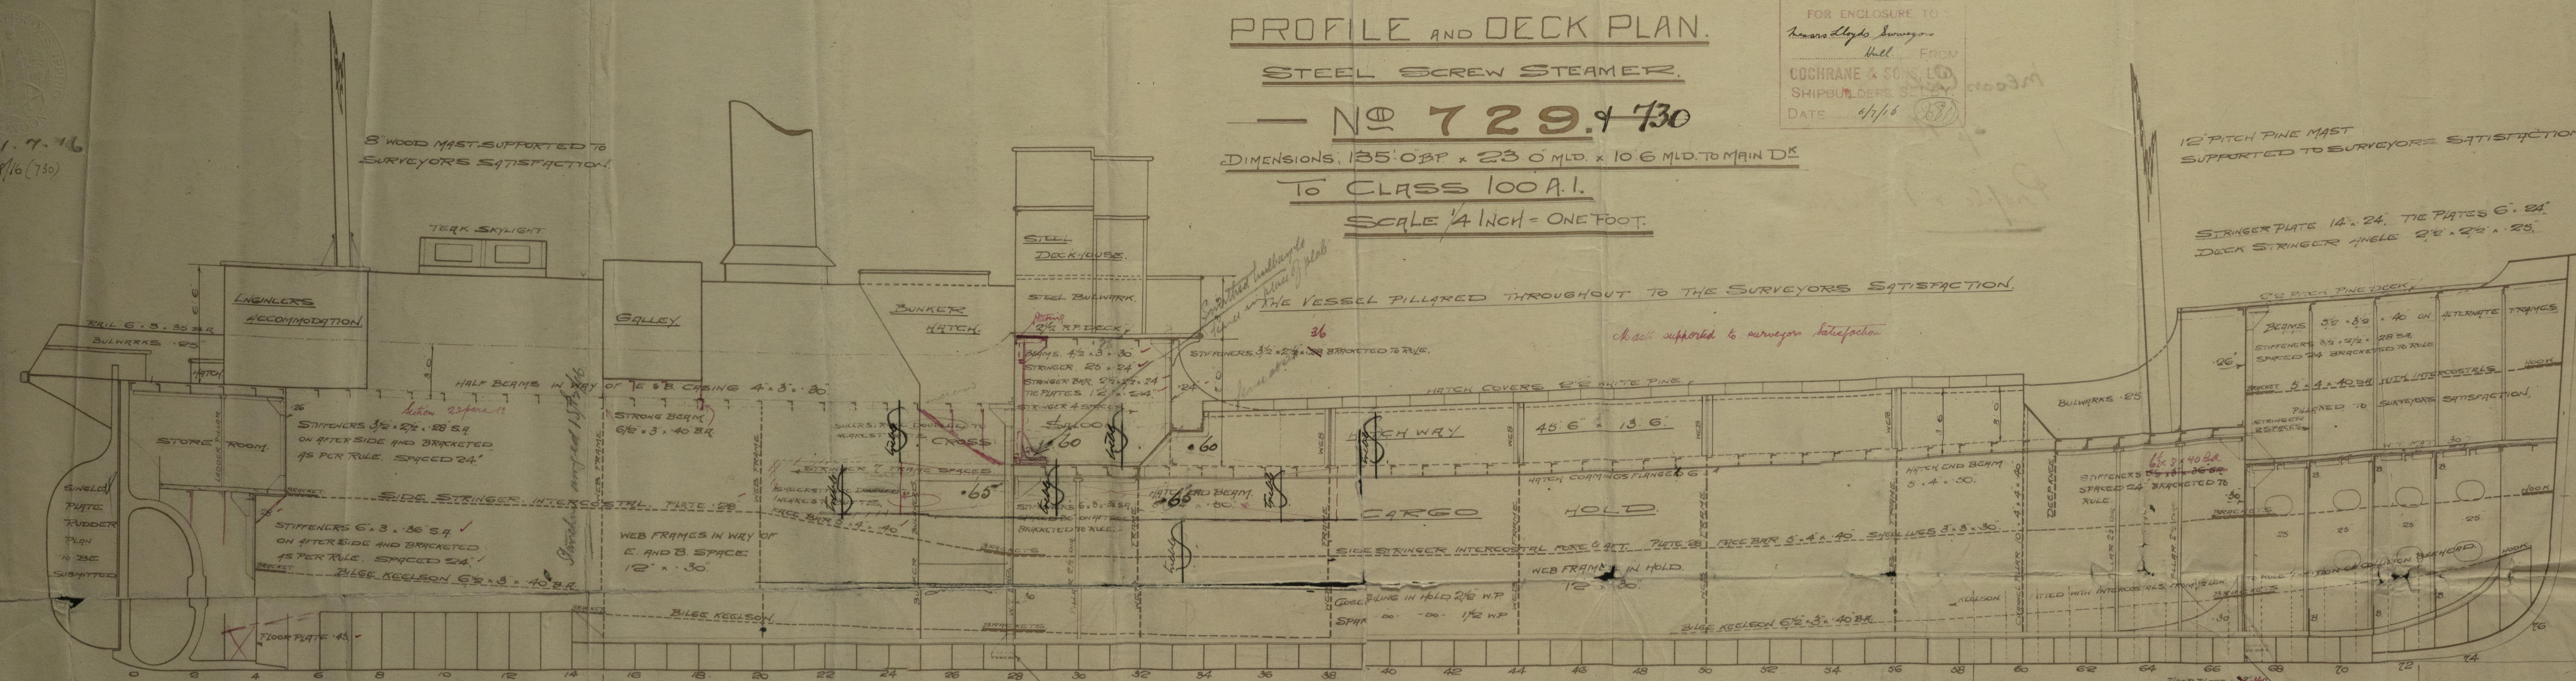


Stringing of bottom forward refer Rule.
Keel and adjoining strakes midship
thickness to rule position of collision
bulkhead.

PLAN OF PAINTING ARRANGEMENT TO BE SUBMITTED.

21.7.16


21.7.16

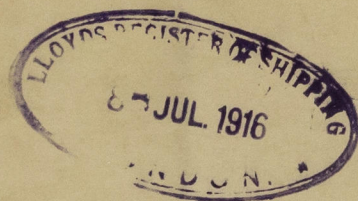

St. Lithium Hull Fbd Rpt No 29783.
St. Lithium Hull Fbd Rpt No 29848.
N.N. Mayden

p. 5
14
4


Messrs Cochrane & Sons Ltd.

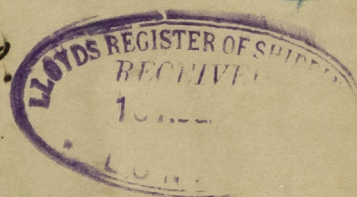

s/s No 729.

Profile & Deck Plan.

St. Lithium Hull Rpt No 29858

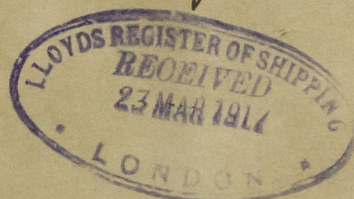

32.