

**Breadth** (*greatest moulded*)

• F

Builders *A/S. Vulcanver*


**Depth,** at middle of length from top of keel to top of beam at side of uppermost continuous deck. See Sec. 3 (1c) .....

Owners *L. N. Baracache Ship*

Fonnage 428

M.V. ST. EUSTATIUS.

Diagram of proposed engine room pumping arrangements

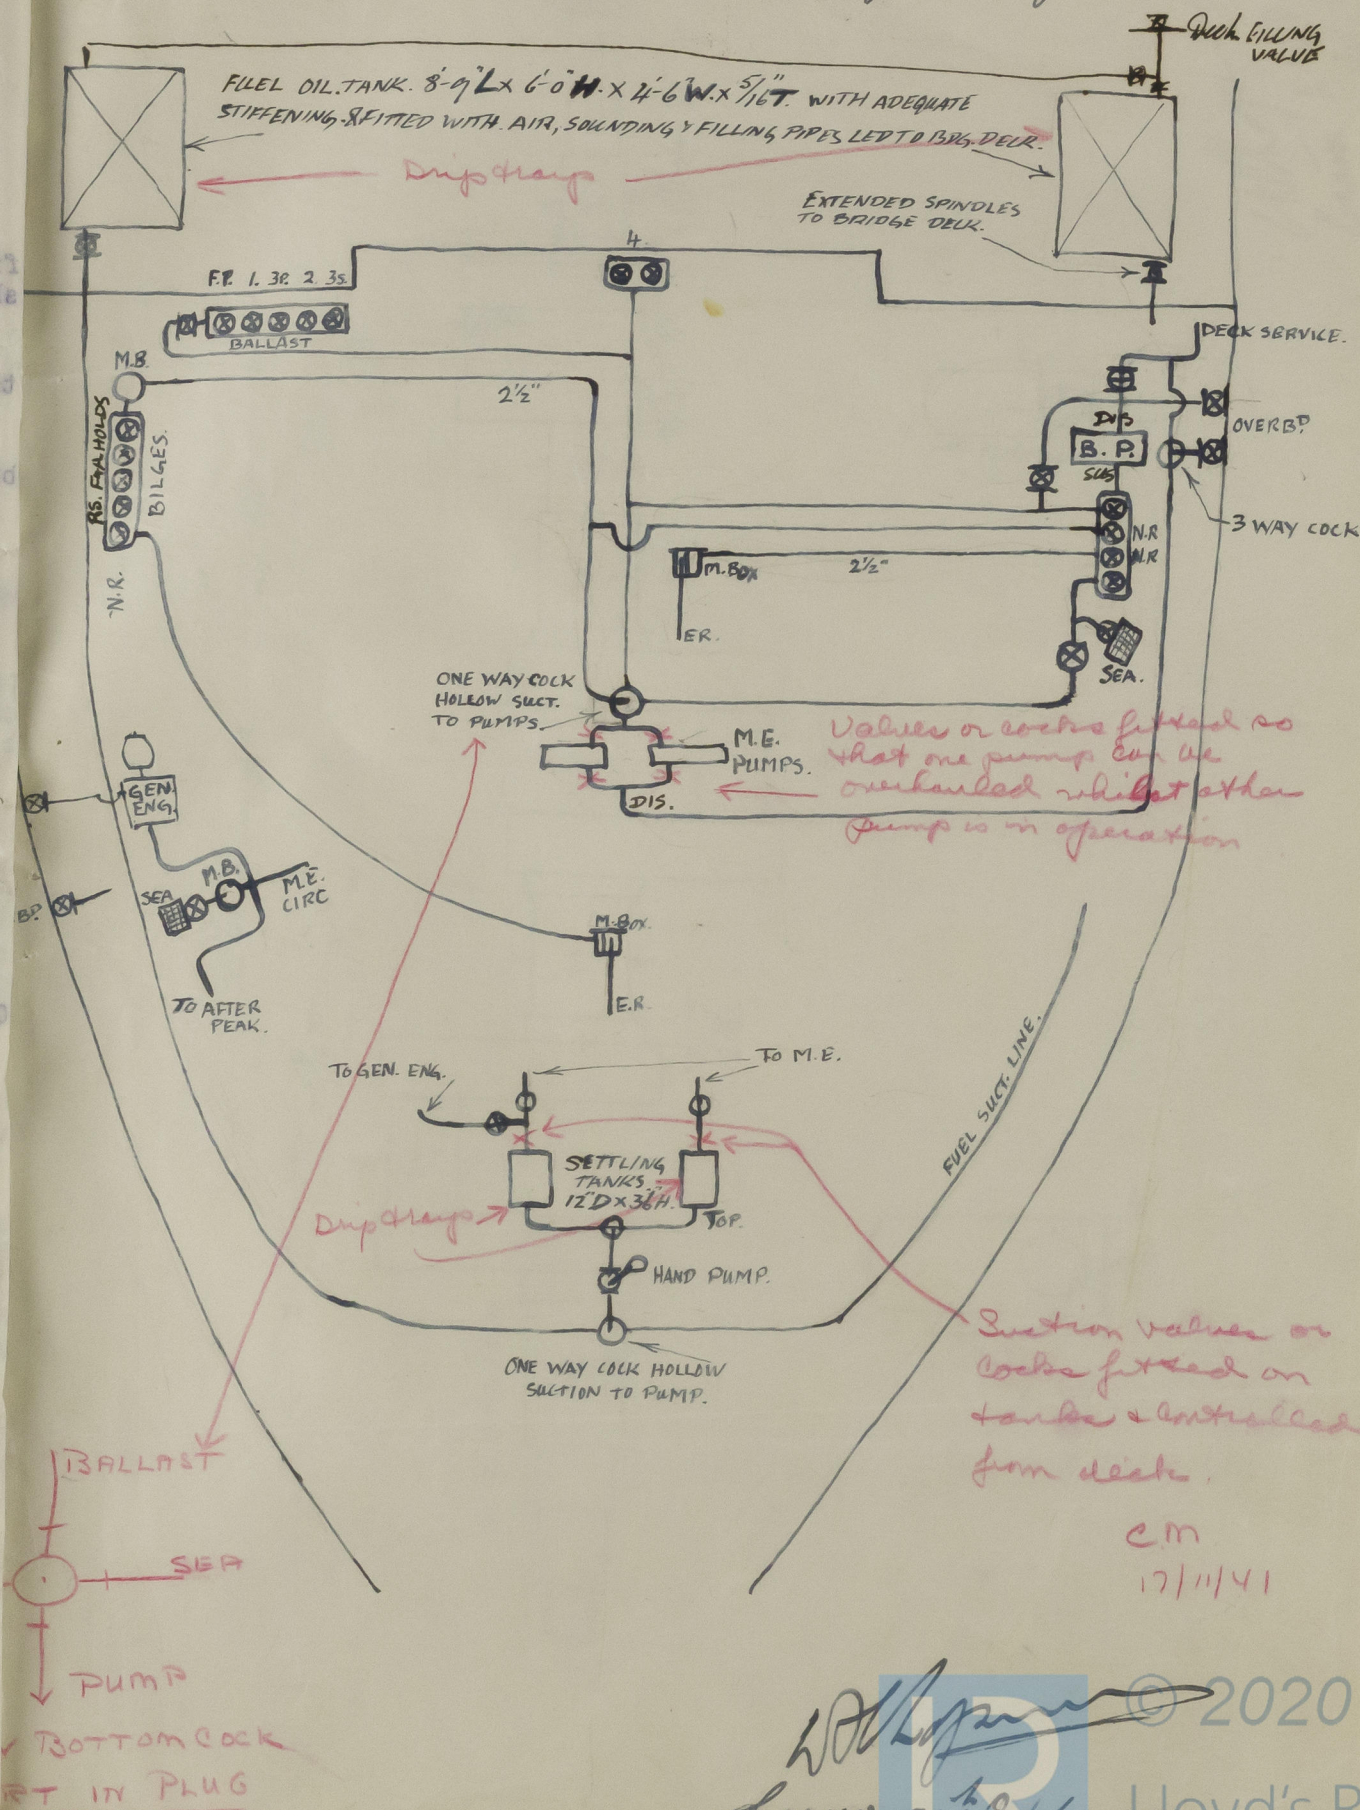

c.m.  
17/11/4

W. H. Lloyd  

## DOUBLE BOTTOM.

thickness of Intercostal Plate...

## Angles

## Spacing

**Poop Deck, Angle,** ~~10~~

## Spacing

5 3

244