



SCALE 3" = ONE FOOT.

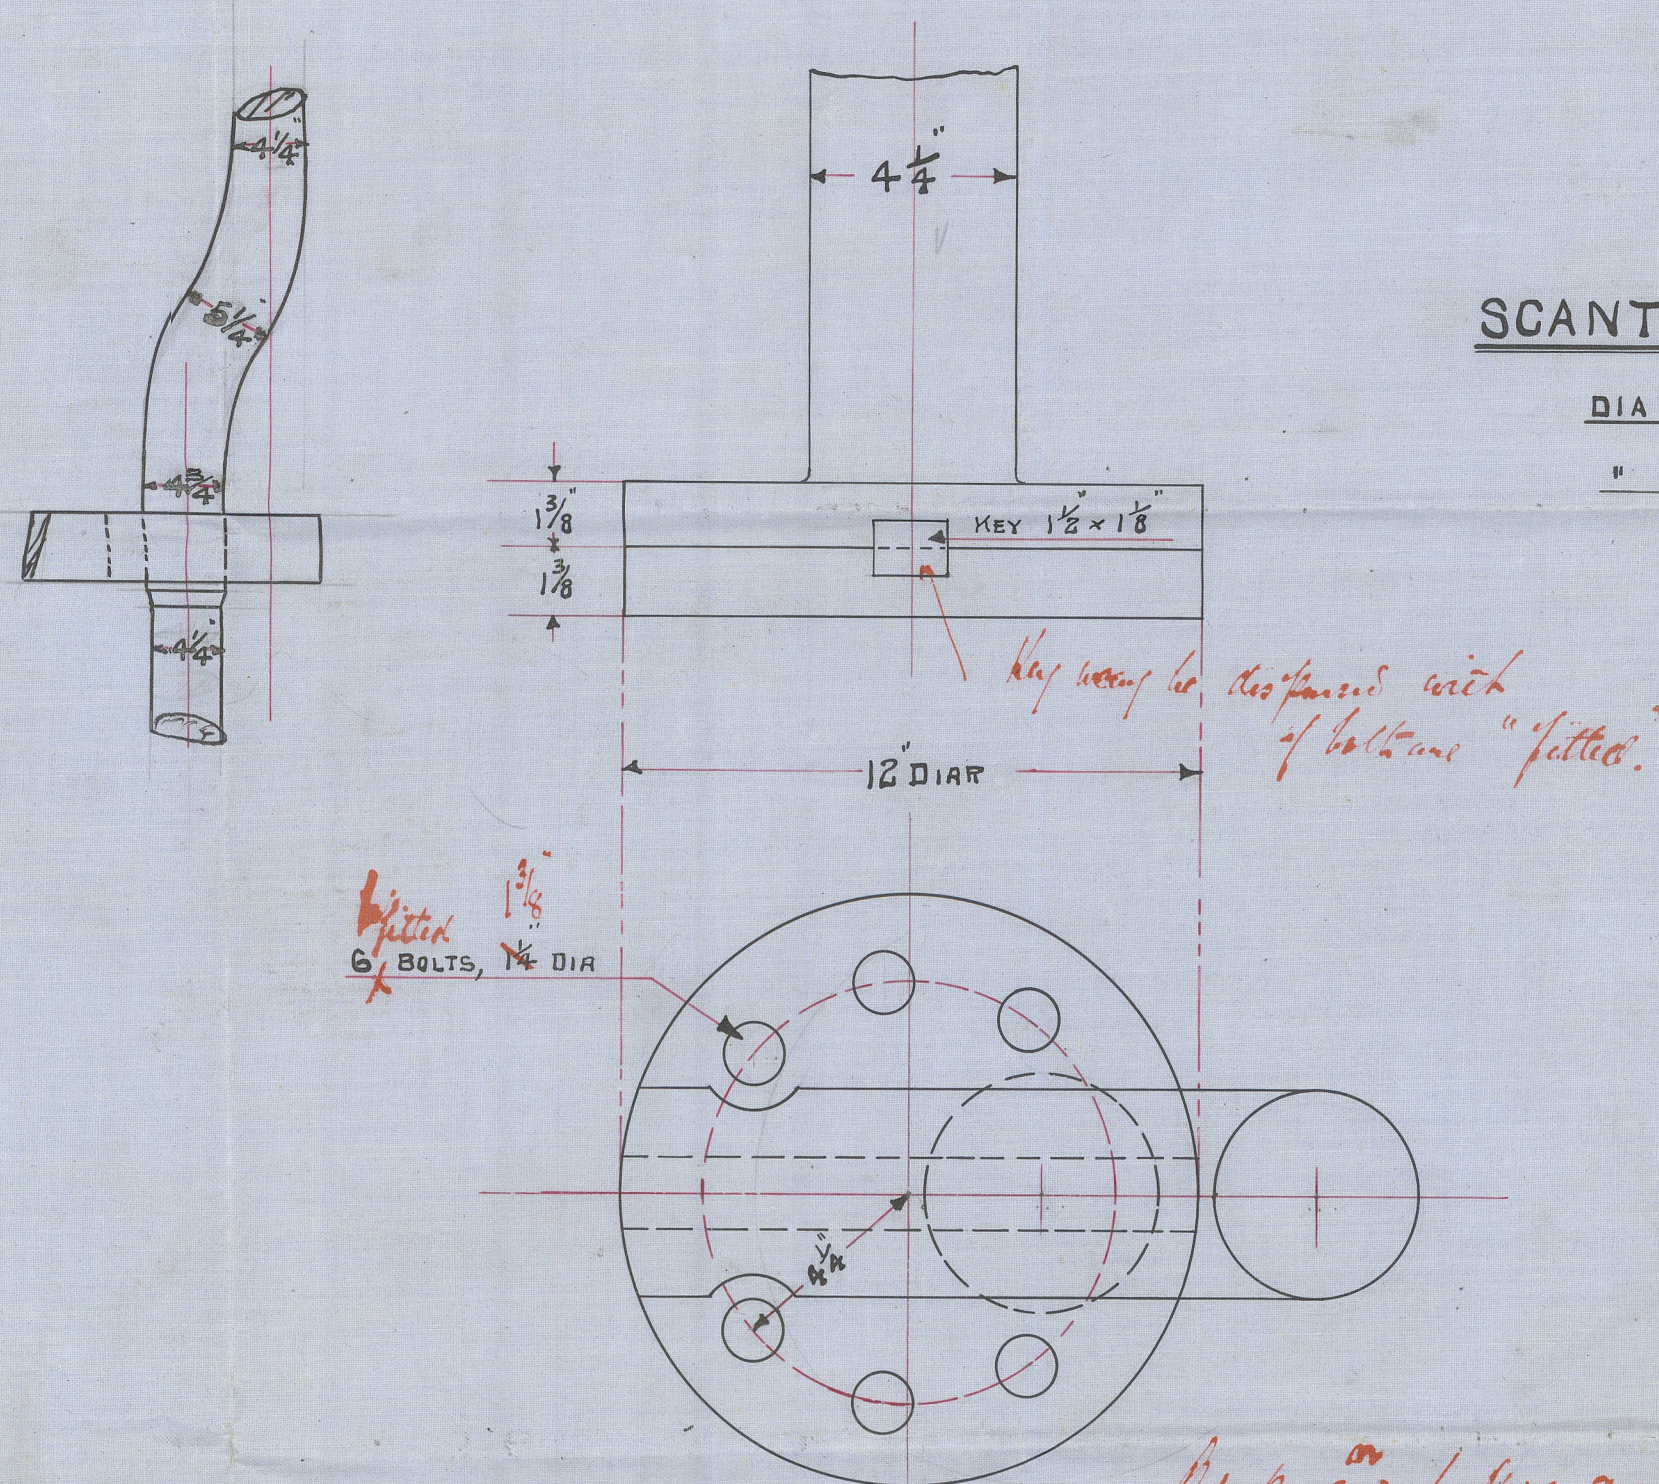

Drake ~~is~~ looking gr. to be
fitted as per Section 33 para 5.

An arrangement of Books & Tracts,
a & other suitable alterations, to be
applied & fitted to the current satisfaction.

DIA	OF	CHAINS	$\frac{9}{16}$ "
"	"	RODS	$\frac{11}{16}$ "

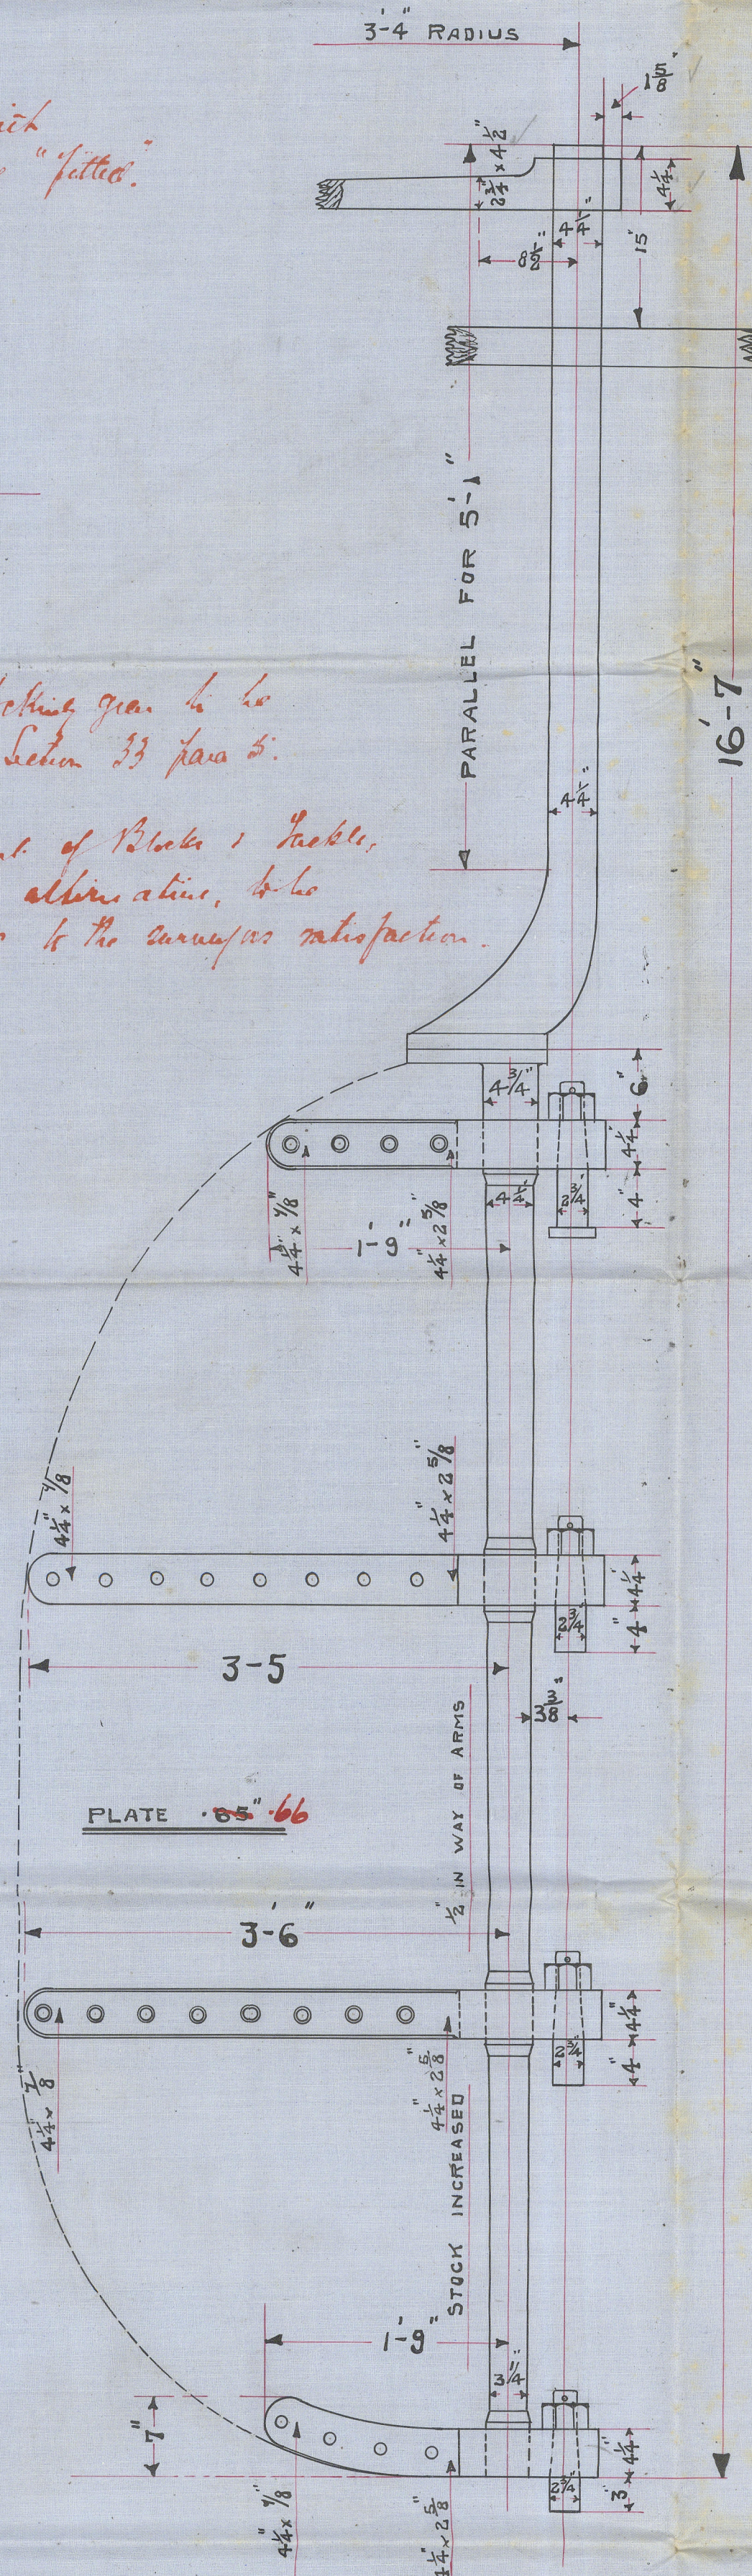

S. S. № 305.

SCALE 1" = ONE FOOT.

$$\underline{A \times D = 62.72}$$


SPEED UNDER 12 KNOTS.

HOLES IN STERNFRAME TO BE BORED $\frac{1}{16}$ " FOR $\frac{1}{2}$ " RIVETS
SPACED 5 DIA APART CENTRE TO CENTRE. ✓

FROM	BOTTOM	OF KEEL	TO CENTRE	OF LOWER ROW	Z'
"	"	"	"	" UPPER "	4"

HOLES IN RUDDER ARMS TO BE BORED $1\frac{1}{16}$ " FOR 1" RIVETS
SPACED $4\frac{1}{2}$ " DIA APART CENTRE TO CENTRE AND COUNTERSUNK

RUDDER PINTLES $2\frac{3}{4}$ " DIA. GUDGEONS BORED TO SUIT.

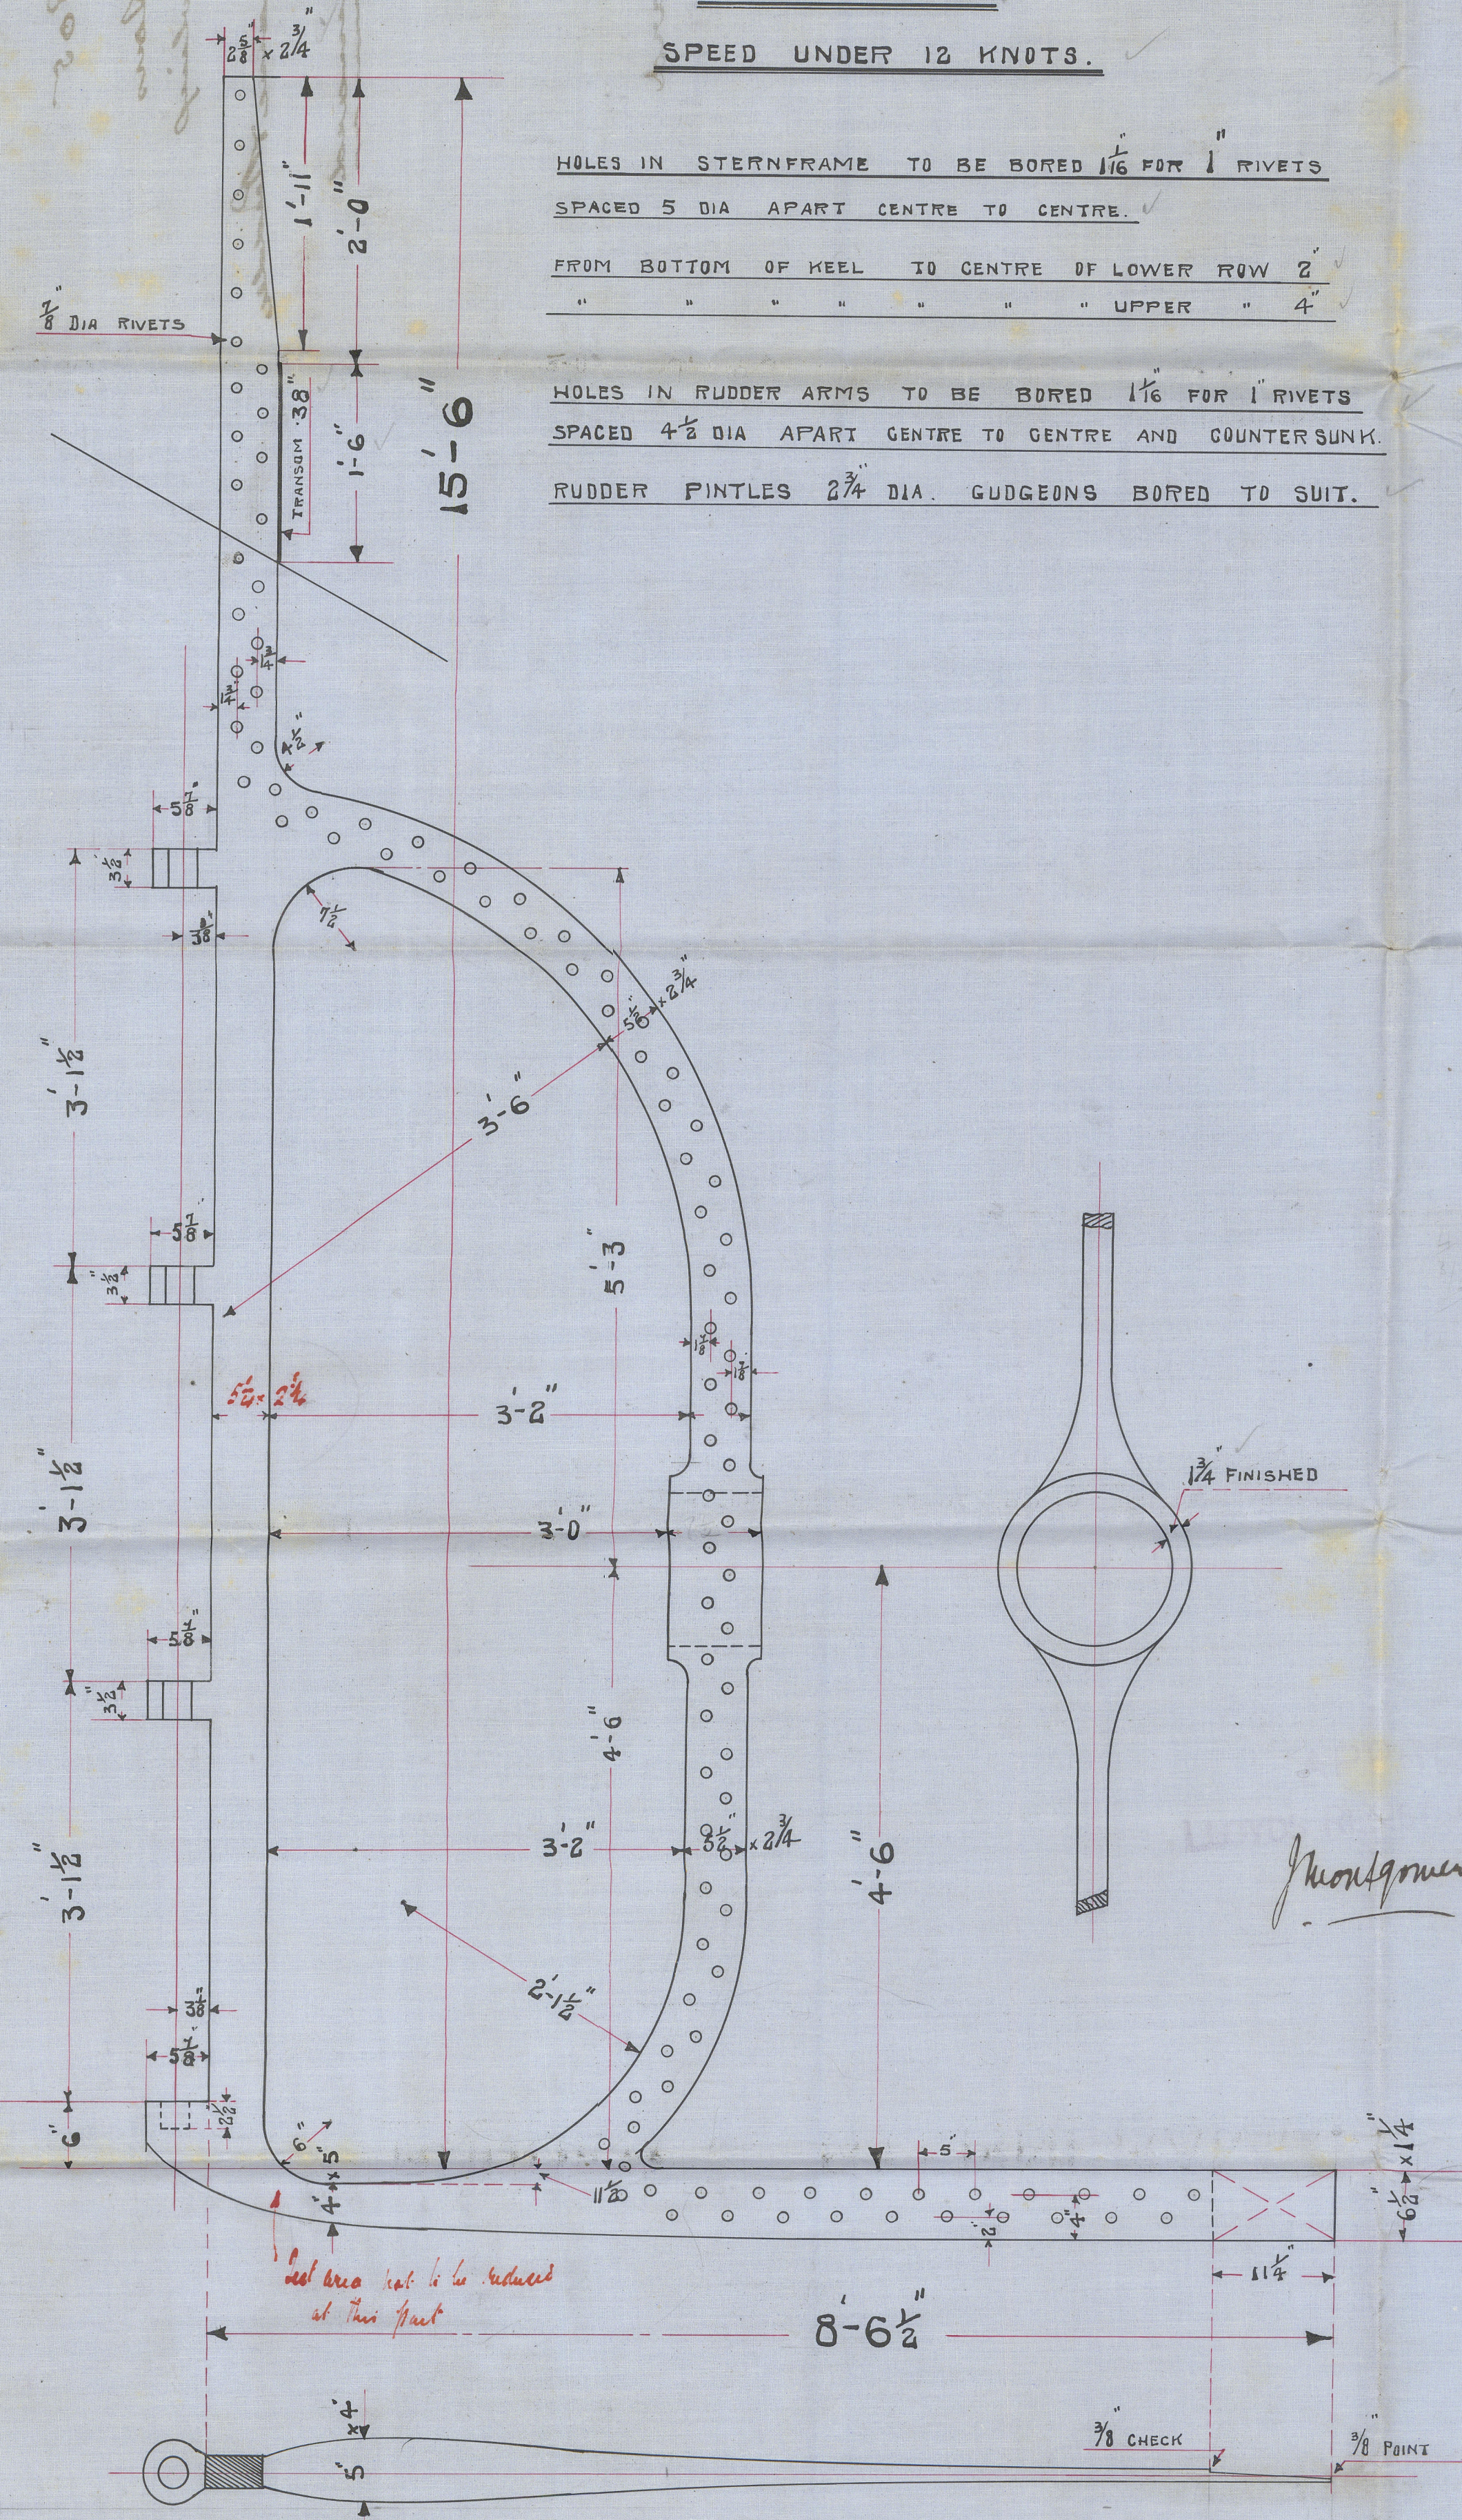

Montgomery 25.5.75

Sp 305

Scott Ross
Bowling

Sternum & Throat

Sp Minard

Minard



© 2020

Lloyd's Register
Foundation

002279 002288-0128