

Lloyd's Register of Shipping.

6/11/53.

Ship's Name MIRANDELLA.

Official No. _____



Memorandum of alterations reported since ship was surveyed for assignment of Load Lines in _____

MAIN DECK. OPENING:

2'0" x 2'0" 9" BULB PLATE COAMING WELDED
TO DECK WITH RIB ANGLE DEATH. BOTTOM.
WOOD COVER AND TARPULINE.

LOWER DECK OPENING

2'0" x 2'0"
FITTED WITH HINGED STEEL COVER PLATE.

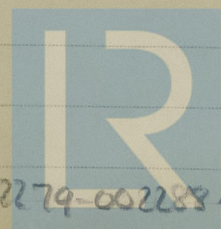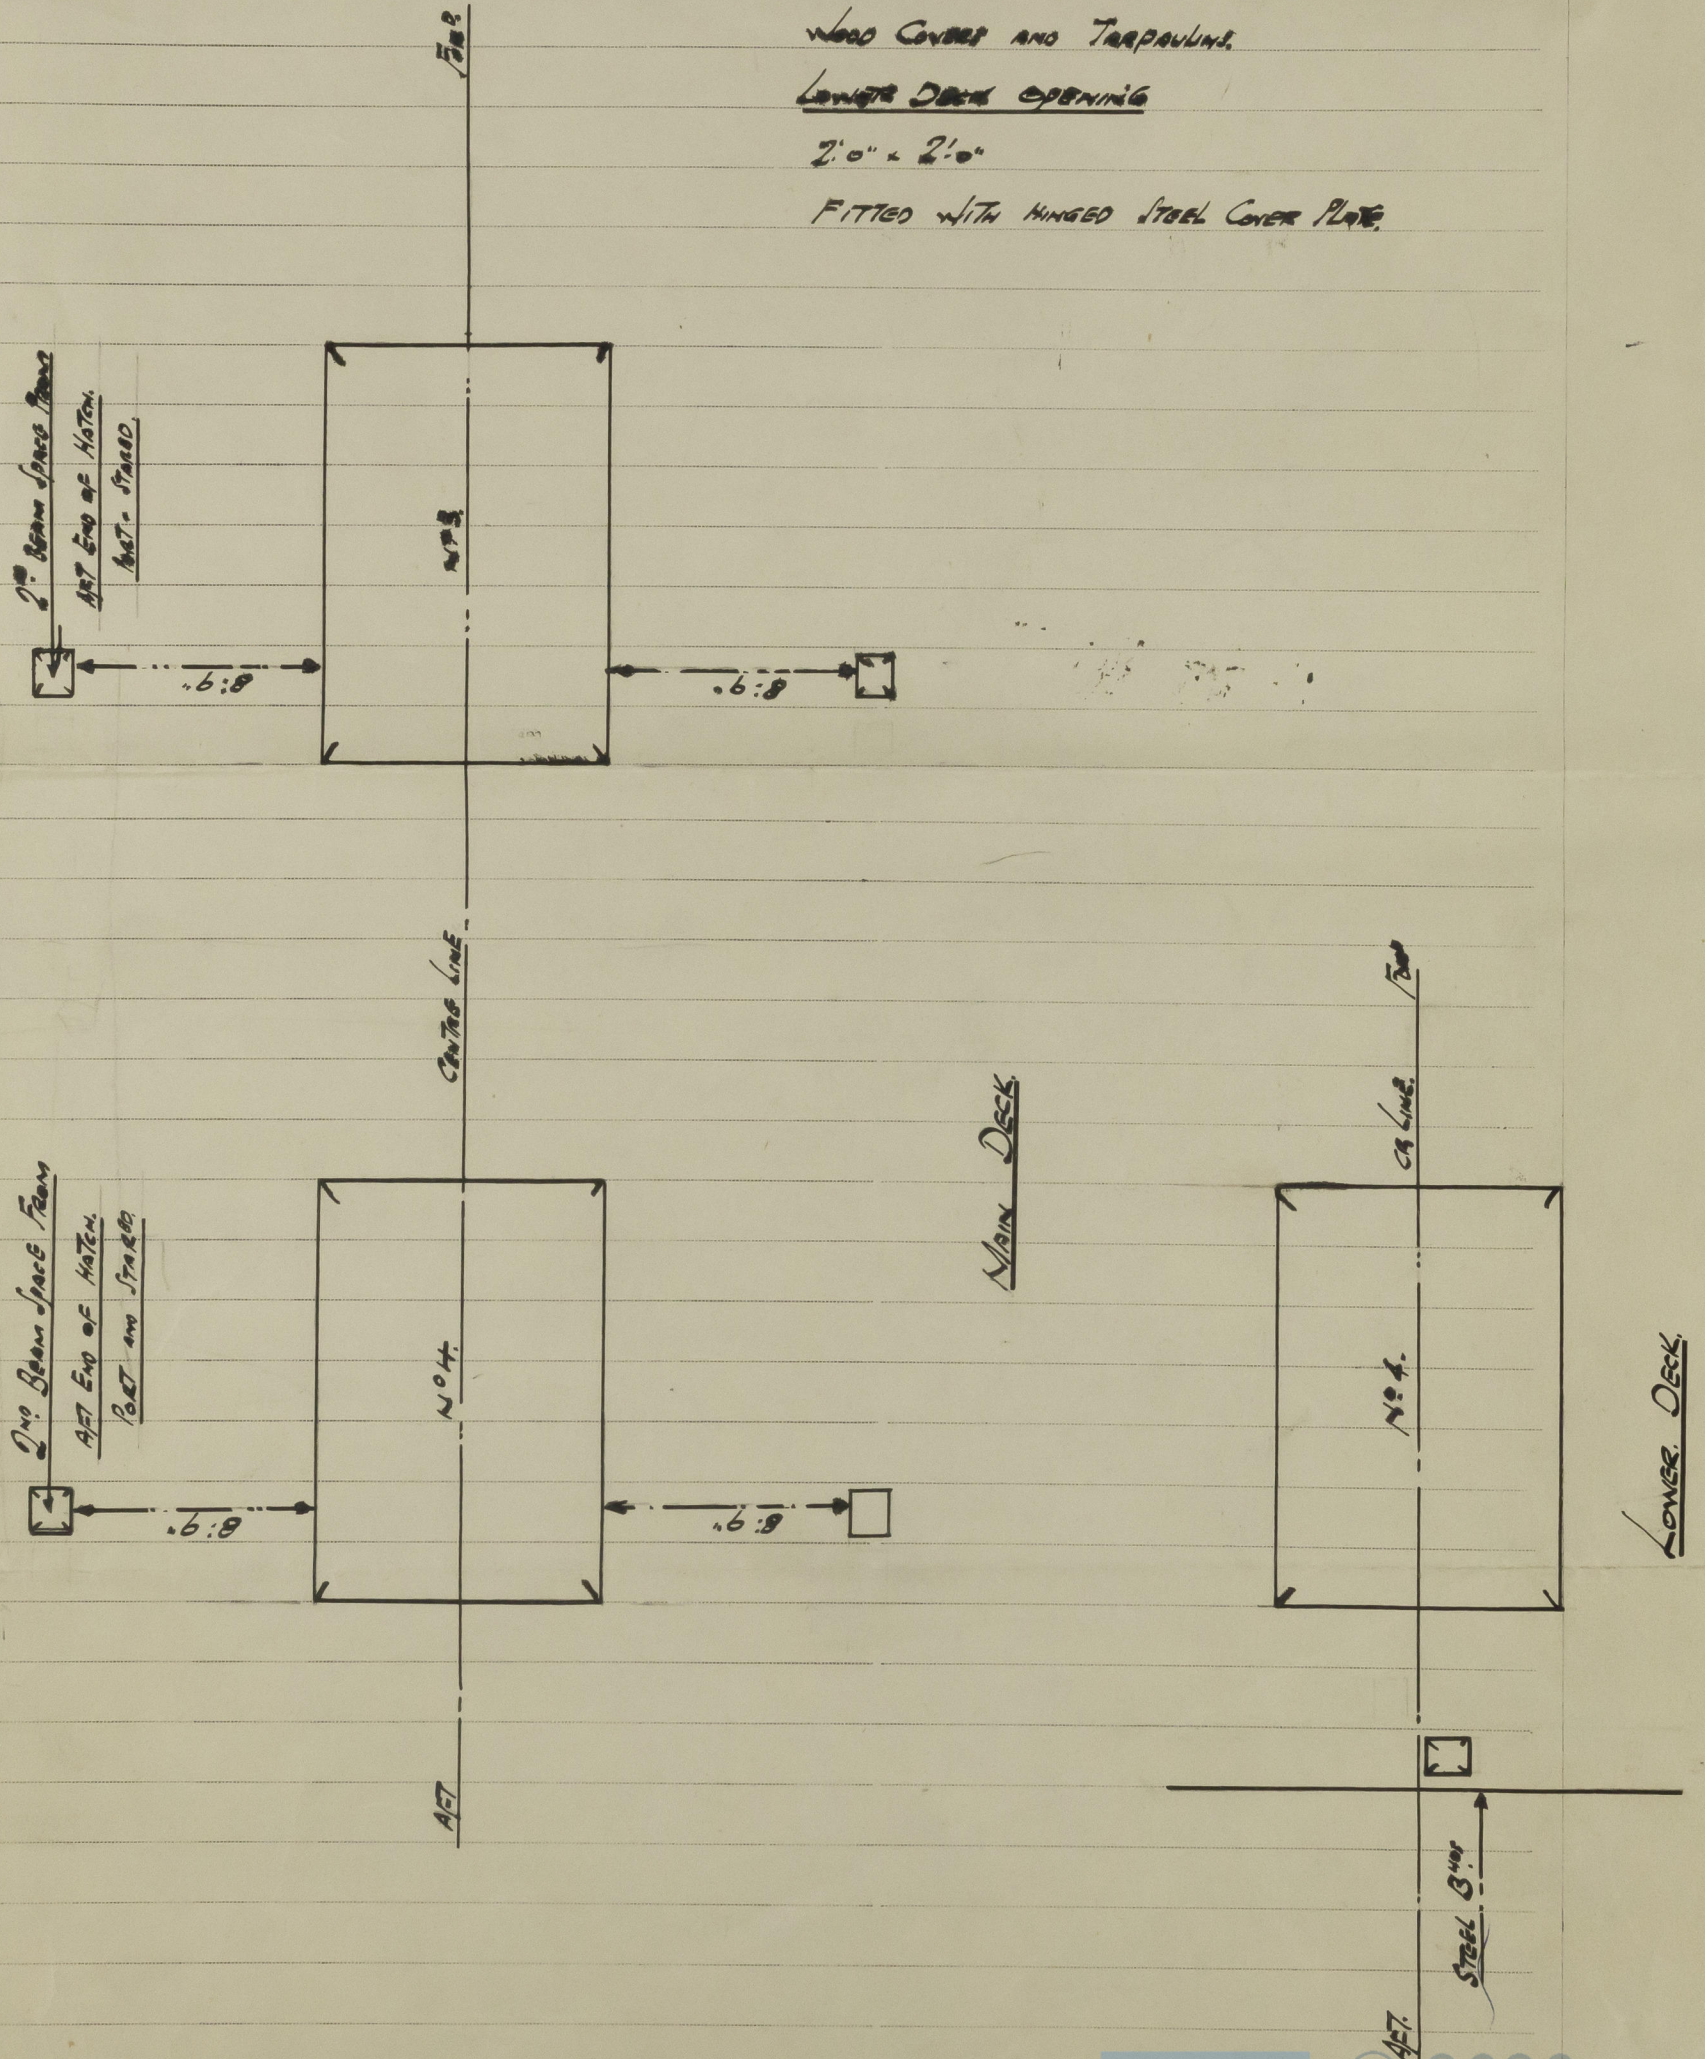

© 2020

Lloyd's Register
Foundation

002279-002288-0175