


TO ACCOMPANY LETTER
OF 28TH JANUARY 27

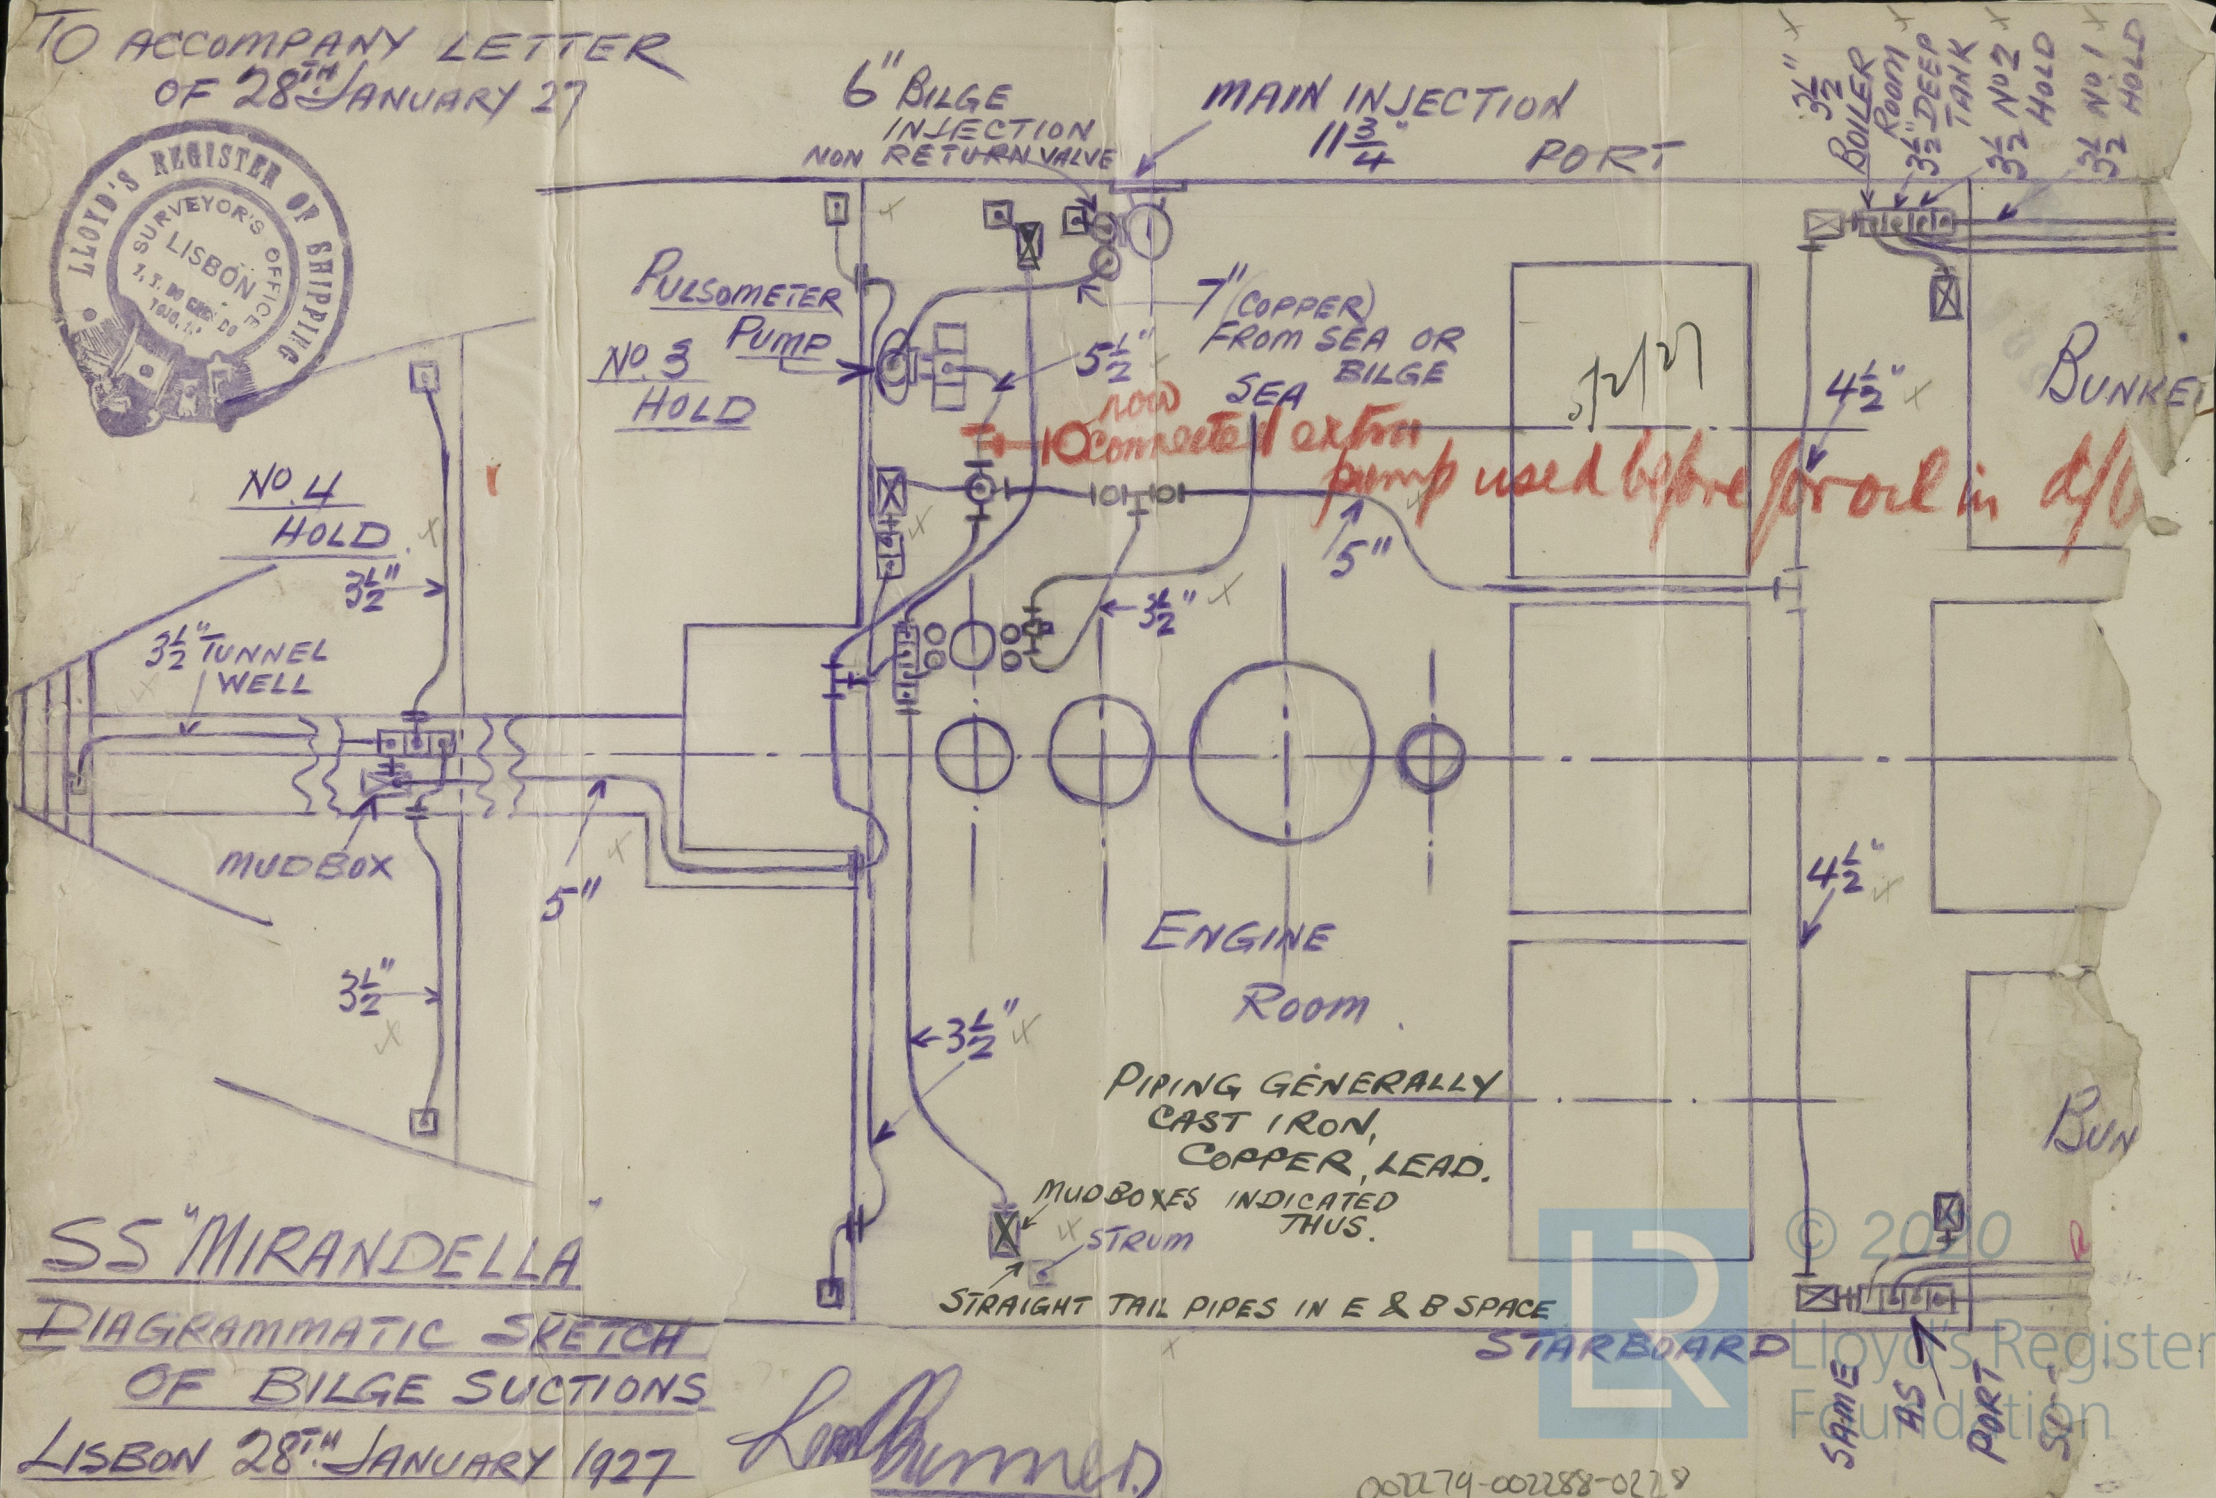

002274-002288-0228