

For the information of Surveyors and the Committee only.

Received at

Office

19

# Lloyd's Register of Shipping.

(Report on Vessel No. 39489)

Port Hull

## No. SHIP FORGINGS OR CASTINGS.

I have to report that the undermentioned Iron ~~or Steel~~ Forgings ~~or Castings~~, manufactured by J. S. Foster & Son L<sup>d</sup> of Sunderland for the Vessel No. 3755, being built by Cook Nelson & Gummell & Co Beverley have been inspected by me as set forth below and found to be, so far as can be seen, Sound.

on Forgings or Castings.

Lloyd's

No. 5041 ✓

12-12-28

D. D. Williamson

Sunderland, 13-12-28

STERN FRAME.

RUDDER FRAME.



STEM.

Material\* ...  
made ...  
annealed ...  
ensions ...  
gress on Inspection ...  
e when Inspected }  
CASTINGS.  
sts on Standard Test Pieces.  
ile Test—  
Tons per square inch ...  
Extension per cent. ...  
Bending Test—  
Angle before fracture ...  
p Test—  
Height from ground ...  
nmering Test—  
If made according to Rules and found satisfactory ...

Scrap Iron  
Forged

5 1/2" dia 5" x 5 1/2" x 4 1/2"  
Forged & Finished  
30-11-28 to 12-12-28

SKETCHES OF FRAMES SHOWING POSITION AND DESCRIPTION OF WELDS OF FORGINGS.

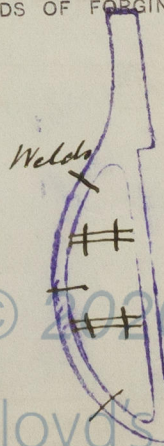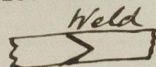

Fee (if any chargeable) £

To be paid at

If of Iron, state whether scrap or puddled Iron. If of Steel, state whether made on the Open Hearth process.