



FLOORS IN MOTORROOM = 7.5%
CENTRE GIRDER IN MOTORROOM = 10.0% AT END = 8.5%

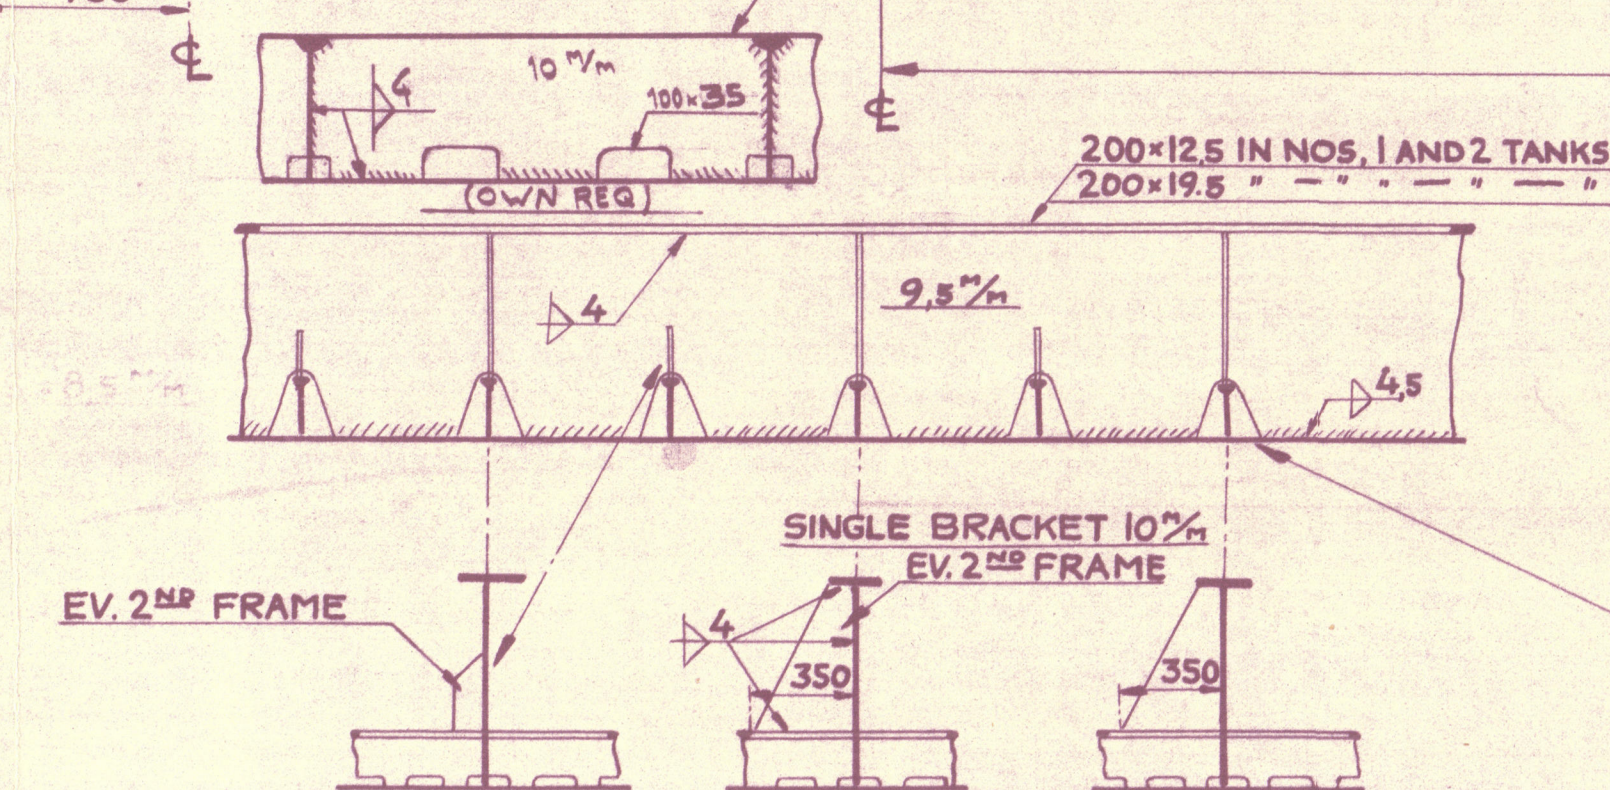

MAIN FRAMES TO BE CARRIED UP TO
POOP DECK AND FORECASTLE DECK

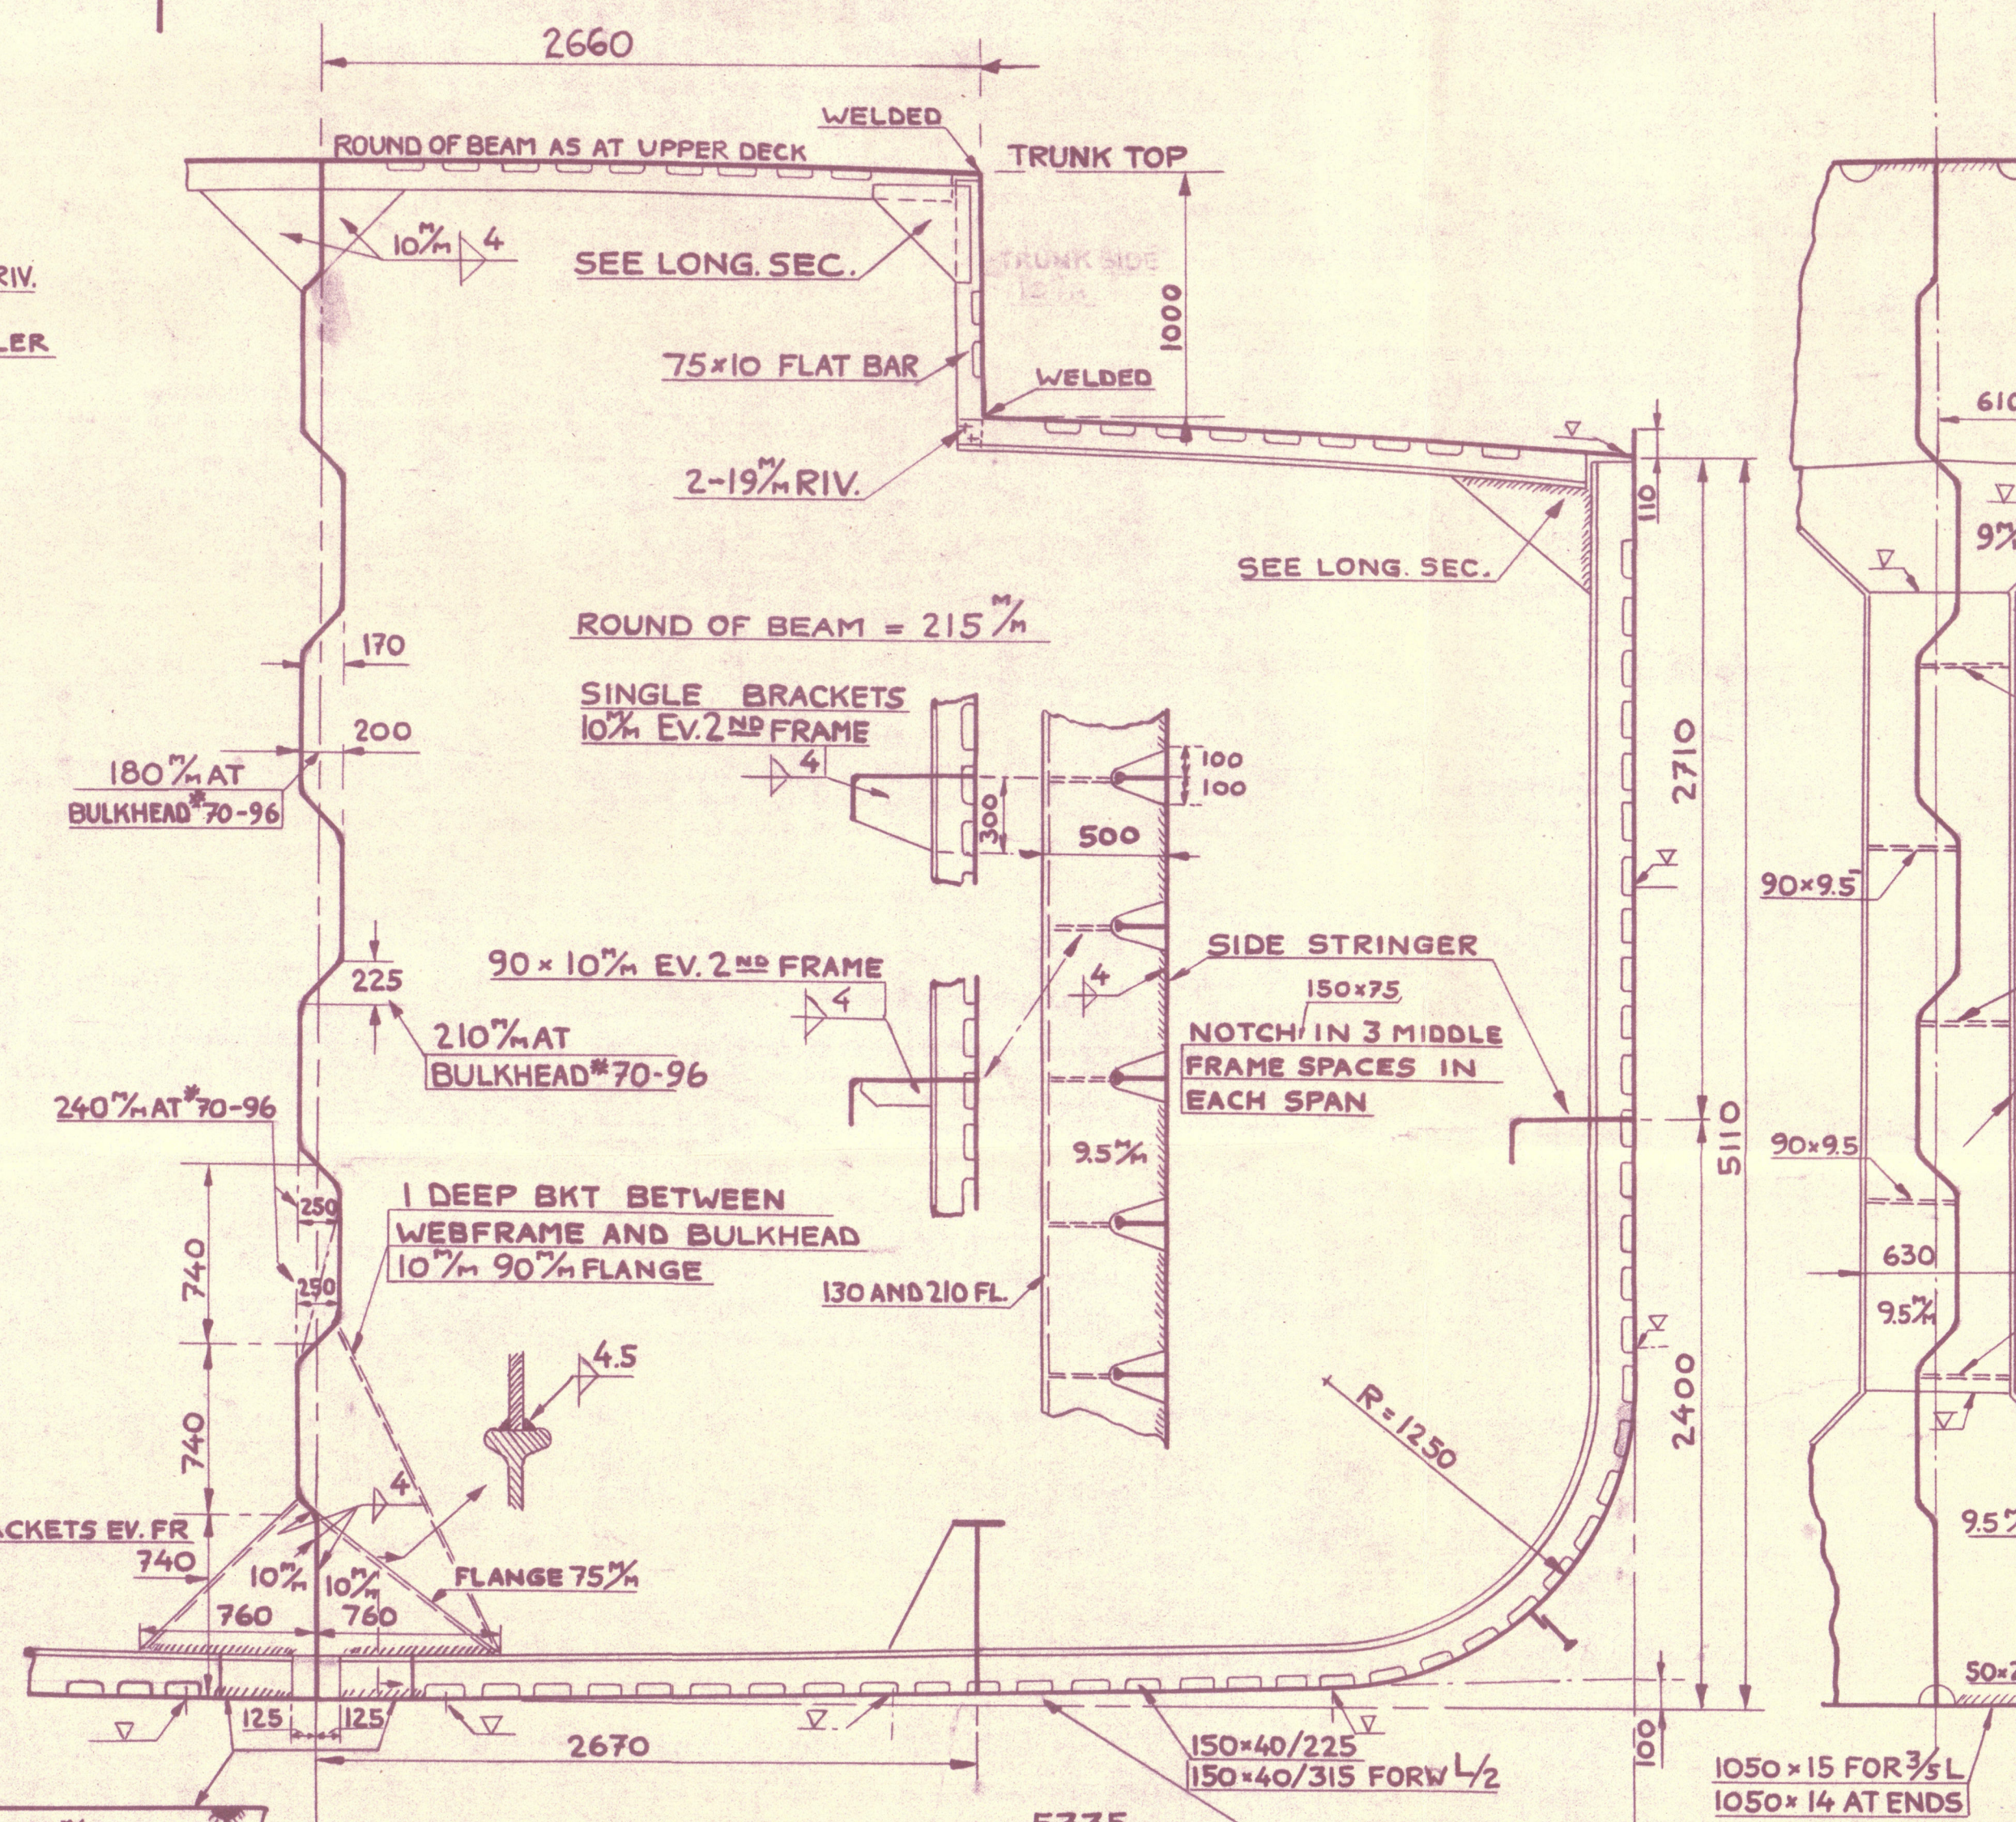

TEST HEAD 5 FEET ABOVE TOP OF TRUNK.


1011	1	REBERT A.S. NORDSTERNAN.	1947	
1010	1			
1009	1			
BEST. Nr.	LIT. GGR	BESTÄLLARE	DATA	ANMÄRK.
				SKALA
				1:25.
MIDSHIP - SEKTION.				1:5.
				1:10.
KITAD	KOPISAD	GRANSKAD	GODKÄMP	
7/7 1947		18/2-52		
57-N		Almqvist		
LINDHOLMEN		No. 2729		

002289-002297-0078

"LINDESNAS" ★

midship section (as built)

RECORDS DEPT.,
LONDON

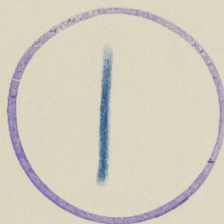

002289-002297-0078



© 2020

Lloyd's Register
Foundation