

# Lloyd's Register of Shipping.


Ship's Name "MORETON BAY".

Official No. 130169.

Memorandum of alterations reported since ship was surveyed for assignment of Load Lines in

The following alterations have been effected whilst vessel was undergoing a reconditioning survey at Liverpool in March, 1947 to January, 1948:

- (1) Structural alterations effected by extending lengths of Forecastle, Shelter deck sidehouses (P. & S) abreast of bridge front and extension of bridge aft end on Port side for additional accommodation.

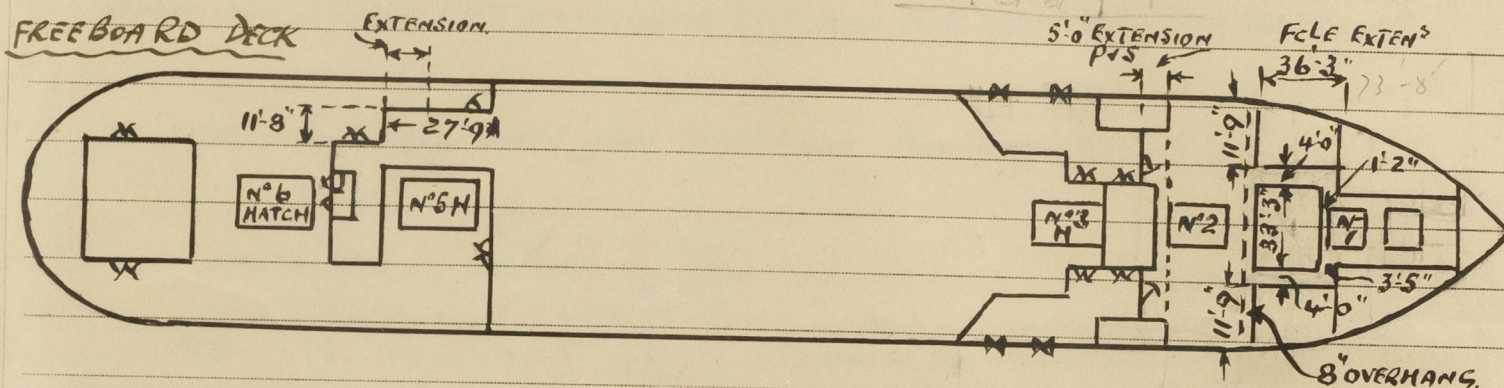

- (2) Tonnage openings at ship side P & S and washport openings (2P. & 2S) on shelter deck abreast No. 3 hatch now restored as formerly.

- (3) Portlights (3P & 3S) in Nos. 1 & 6 lower Tween decks respectively removed and Shell openings efficiently closed with spigot plate blanks.

- Ship Side doors (5port and 5 stbd) in way of Nos. 2, 3, 4, 5 & 6 tween decks removed,  
(4) Shell openings efficiently plated over and internal structure in way made good.

*Thos J. Roberts*

SURVEYOR TO LLOYD'S REGISTER.

January 1948.

002289-002297-0225