


ADVANCE PLAN


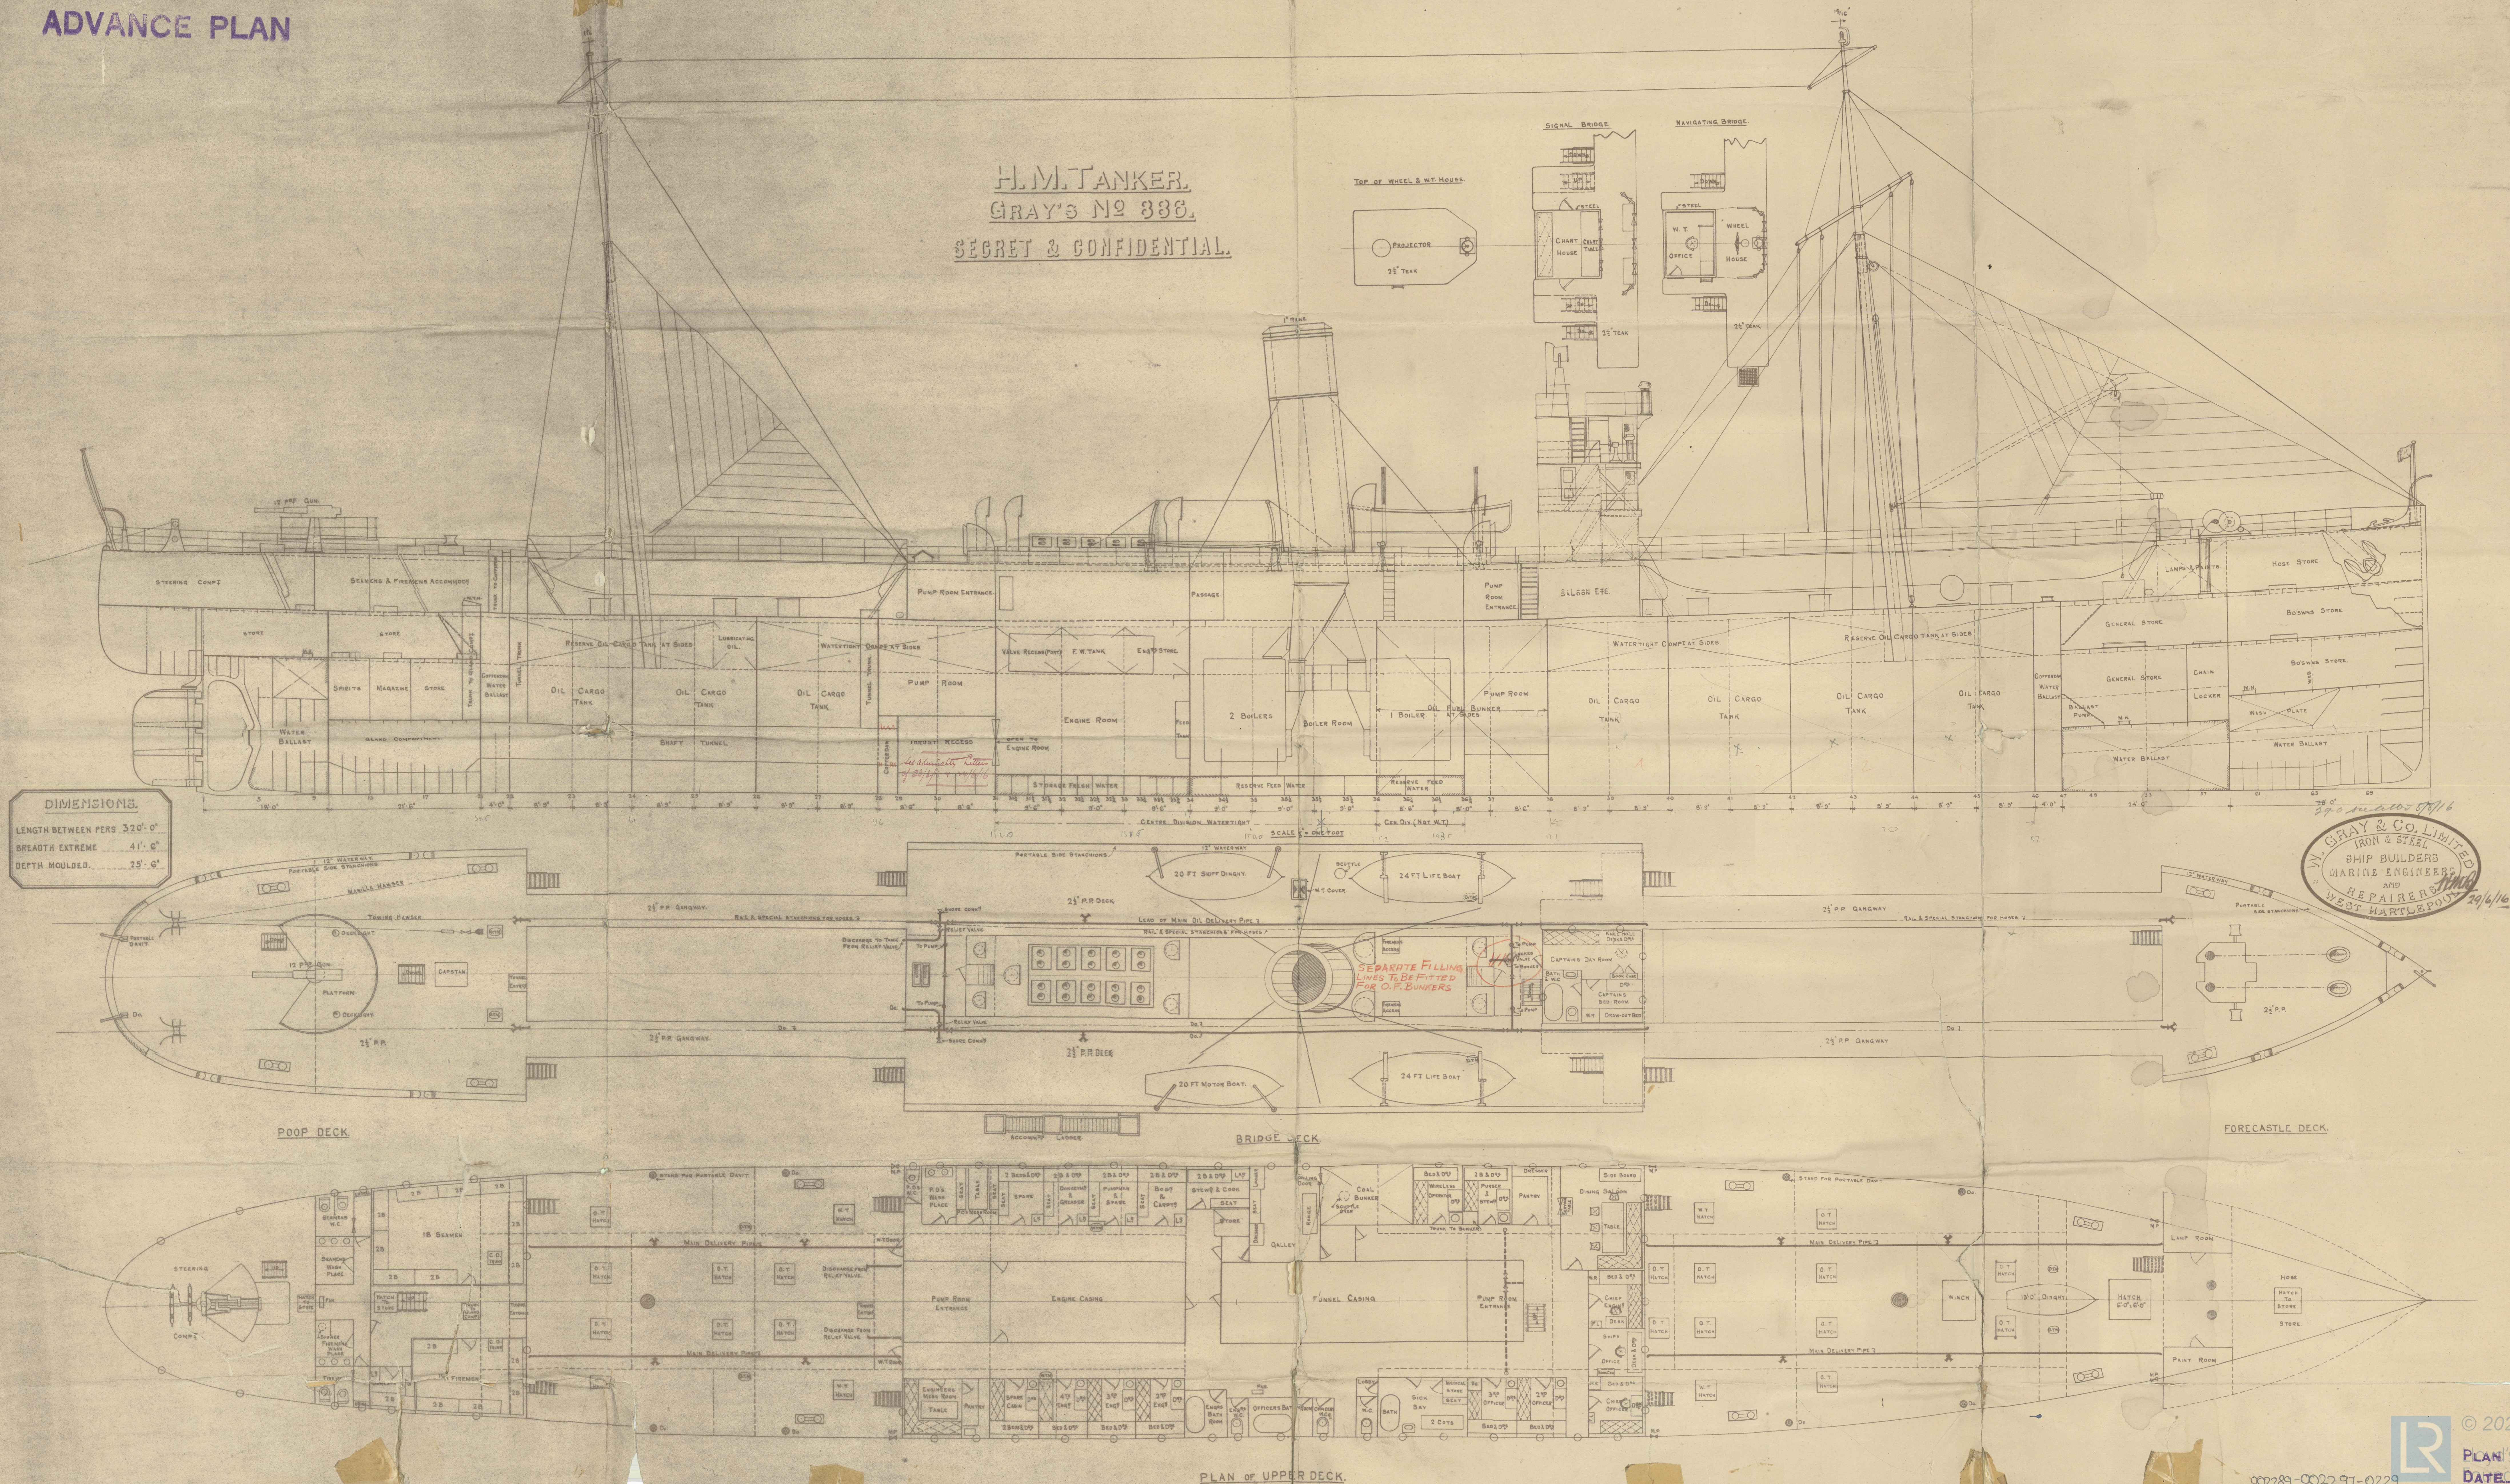

W. GRAY & CO. LIMITED
IRON & STEEL
SHIP BUILDERS
MARINE ENGINEERS
AND
REPAIRERS
WEST HARTLEPOOL 19/4/16

Entre plan

General arrangement



Rabindral

Louise Moller



002289-002297-0229



© 2020

Lloyd's Register
Foundation