


✓ Sketch of strengthening & diaphragms in way  
of break to be submitted.  
and for 1/2 ft from midships.

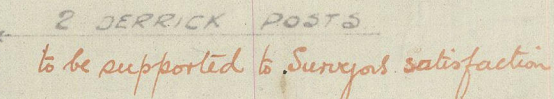

002298-002304-0005



LLOYDS TO BE  
RETURNED



© 2021

Lloyd's Register  
Foundation



RECEIVED  
26 APR 1919  
No.

Harland & Wolff Ltd

N<sup>o</sup> 592 G

Profilection



GLASGOW REPORT No 39805

% Somerset Coast



© 2021

Lloyd's Register  
Foundation

002248-002304-0005