


# S.S. "SCILLONIAN"

## PROFILE AND DECK PLANS.

TO CLASS LLOYDS 100A1+ SPECIAL SURVEY

SCALE,  $\frac{1}{8}" = 1 \text{ FOOT}$

DIMENSIONS:- 170'-0" B.P. x 28'-6" B.M.L.C. x 12'-0" D.M.L.C. TO UPPER DECK; 19'-0" TO PROMENADE DECK.

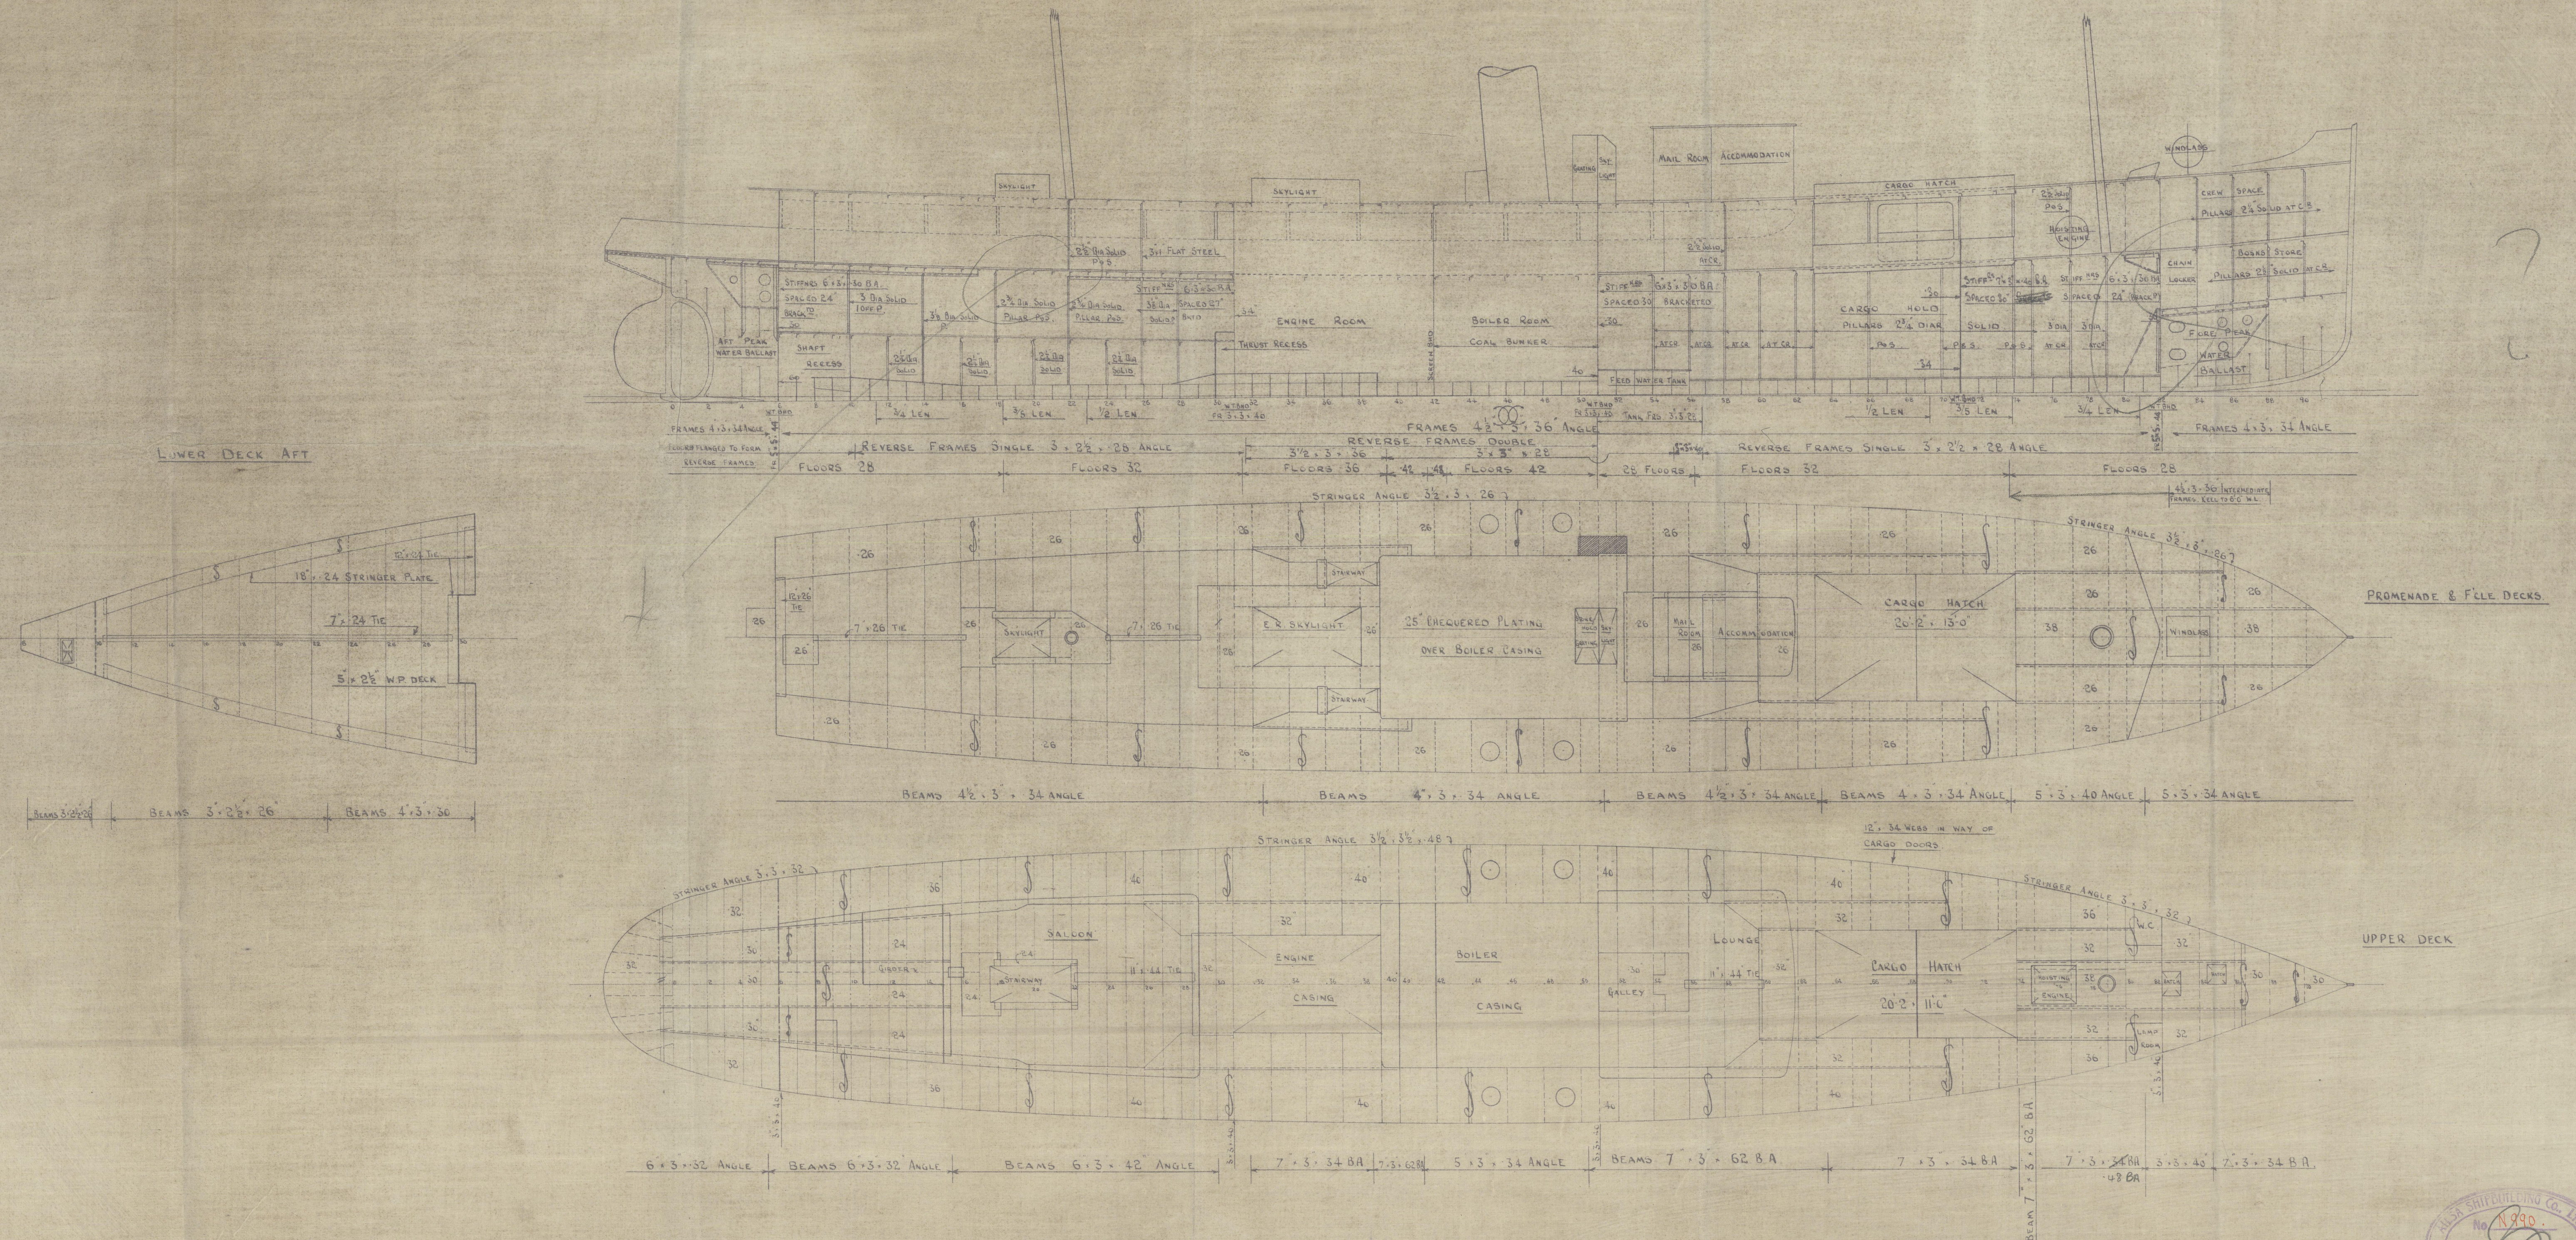

S.S. "SCILLONIAN".

(Ailsa S.B. Co's N<sup>o</sup> 396)

Profile & Deck Plans as built.

*Scillonian*  
GLASGOW REPORT No 45332



© 2021

Lloyd's Register  
Foundation

002298-002304-0111