


21-7-50

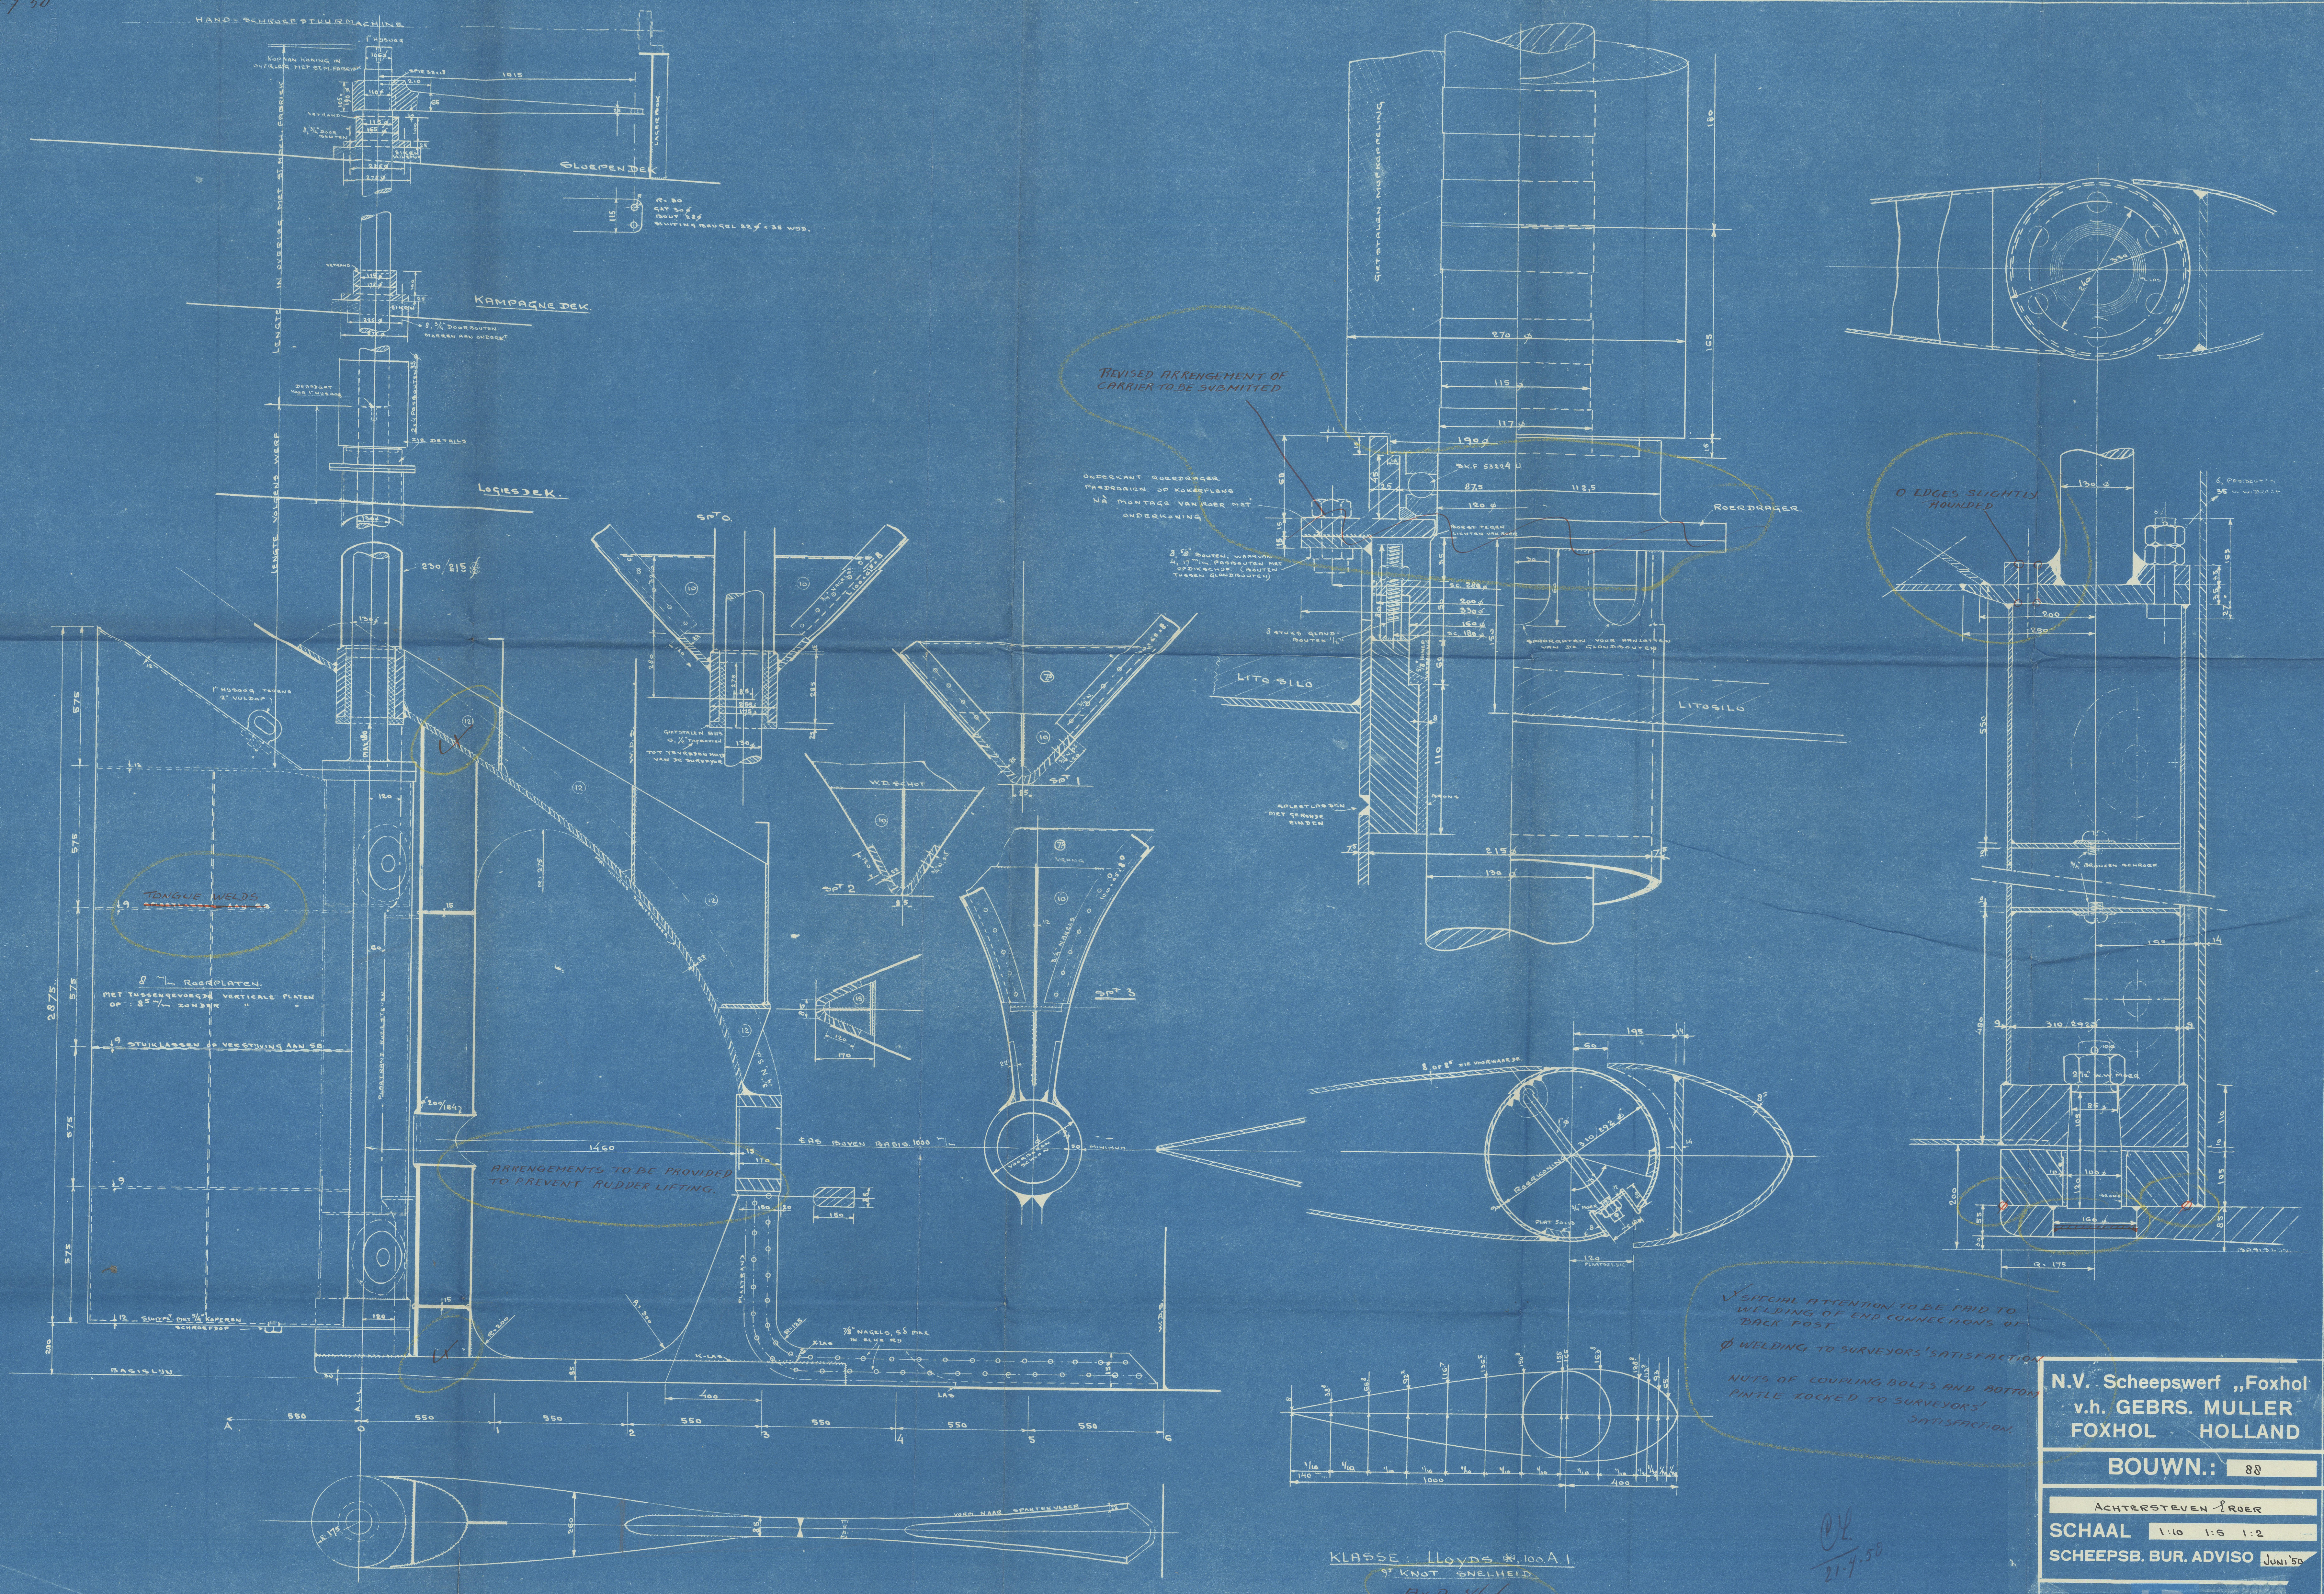

N.V. Scheepswerf „Foxhol“
v.h. GEBS. MULLER
FOXHOL HOLLAND

BOUW.: 88

ACHTERSTEVEN ROER
SCHAAL 1:10 1:5 1:2
SCHEEPSB. BUR. ADVISO Juni '50

TEKENING N° 1032

KLASSE: LLOYDS 100 A 1
9° KNOT SNEELHEID
A x D = 46.6

21-7-50

L.

SCHEEPSWERF "FOXHOL"
(GEBR. MULLER).

YARD NO 88

STERN FRAME
& RUDDER.

002305-002319-0080




© 2020

Lloyd's Register
Foundation



POLLUX

Pollux.  sent Gro. 26/4/51


Sternframe & Rudder.

RECORDS DEPT.
LONDON



SCHEEPS. "FOXHOL"

YARD NO. 88 © 2020

—  STERNFRAME & RUDDER

Lloyd's Register
Foundation

