


1.6.06
11.6.06
22.6.06

No. III. PROFILE.

SCALE 1/4" = 1 FT

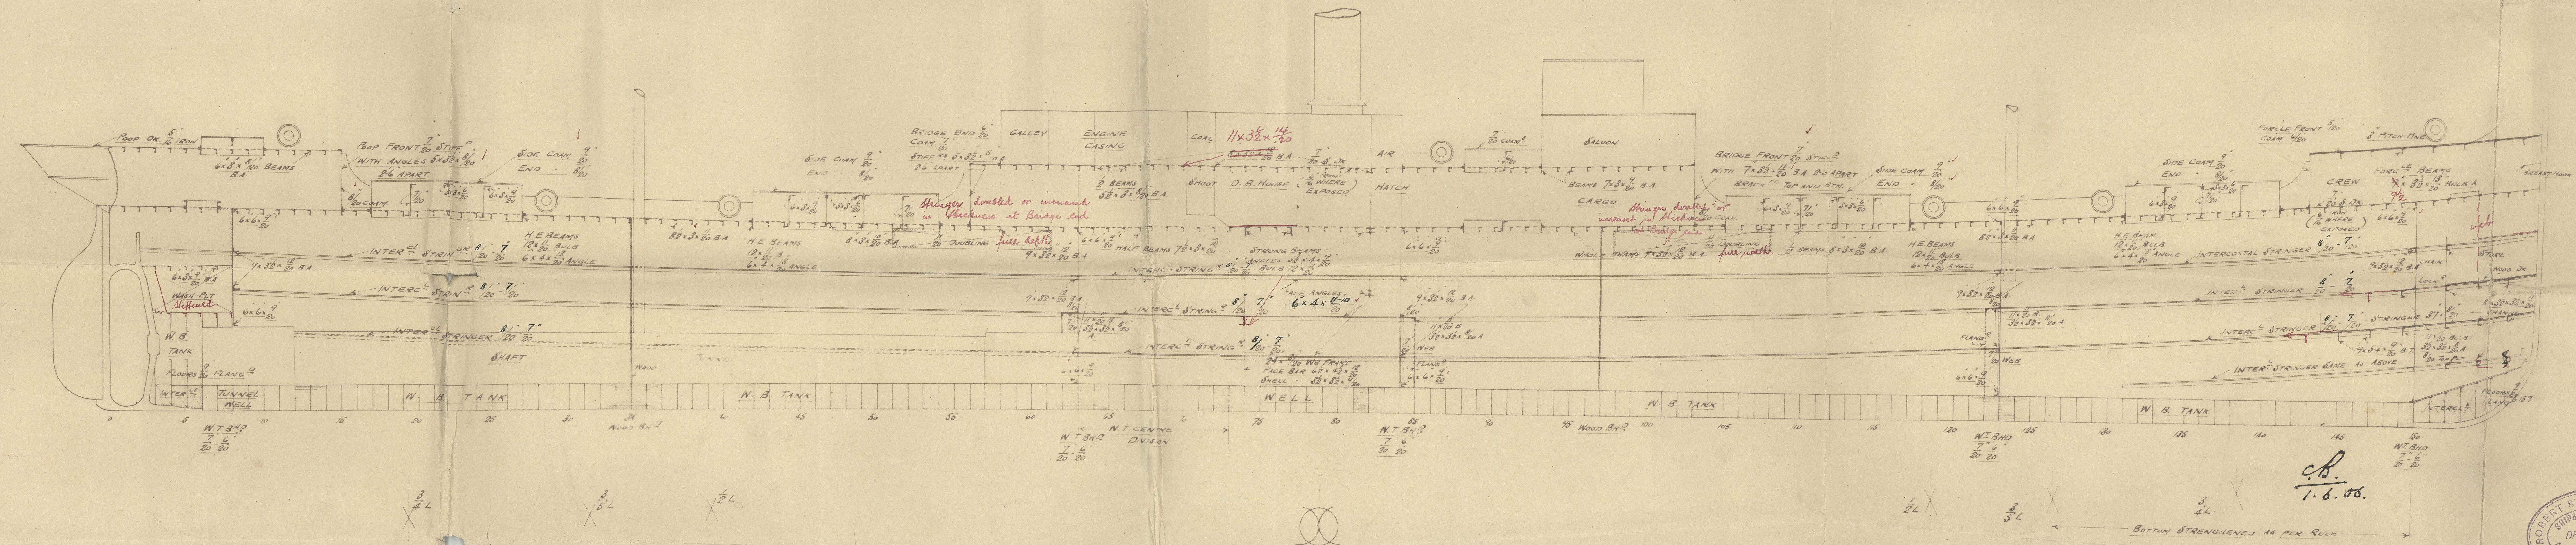

12.6.961

RETURNED 5.6.06.



© 2020

Lloyd's Register
Foundation

R Stephenson & Co
8/8 No III VIRGINIA
Profile Ex
S.P. Marina

Newcastle Report

No 52439

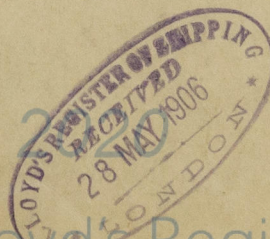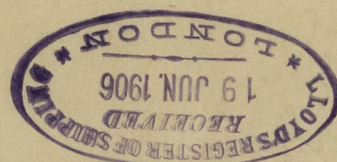

©

Lloyd's Register
Foundation

002305-002319-0126