


Lloyd's Register of Shipping.

Ship's Name ^{S/S} "NORANIA" EX "VIRGINIA" Official No. 5540

Memorandum of alterations reported since ship was surveyed for assignment of Load Lines in

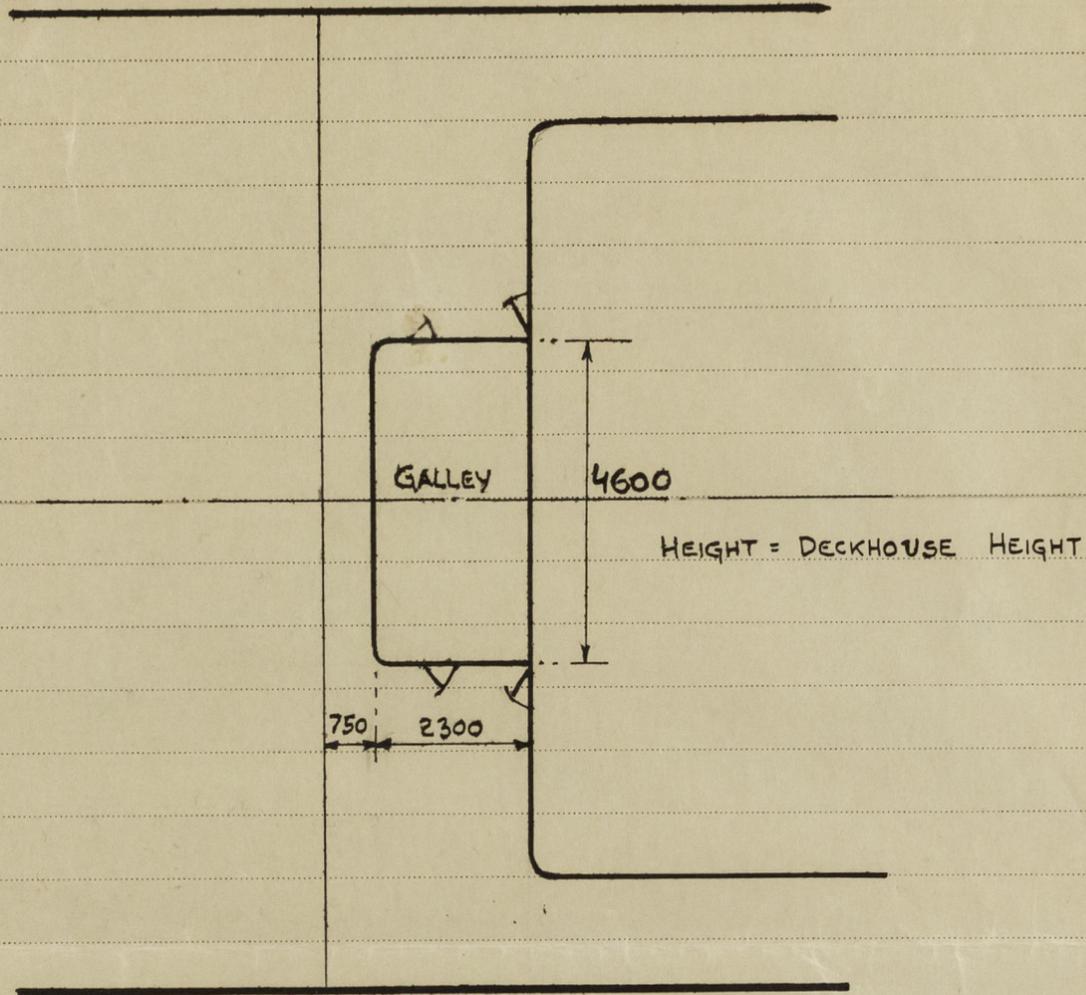

ALTERATION TO GALLEY ON BRIDGE DECK

Bertrand Lynnes

G.H.W.
5 - APR 1949

