

To
Gr
For the information of Surveyors and the Committee only.

Received at

Office

6 OCT 1927

Lloyd's Register of Shipping.

(Report on Vessel No. 38385 Port Hull

No.

SHIP FORGINGS ~~OR~~ CASTINGS



I have to report that the undermentioned Iron ~~or Steel~~ Forgings ~~or Castings~~, manufactured by J. S. Fowler & Sons Ltd of Sunderland for the Vessel No. 489, being built by Cook, Weller & Gemmell Ltd of Bristol have been inspected by me as set forth below and found to be, so far as can be seen, Sound.

on Forgings ~~or Castings~~

Lloyd's


No. 4436

15.7.27.

James Dickie
Sunderland
21.7.27.

	STERN FRAME.	RUDDER FRAME.	STEM.
Material* ...	<div style="writing-mode: vertical-rl; transform: rotate(180deg);">Scrap Iron Forged</div>	<div style="writing-mode: vertical-rl; transform: rotate(180deg);">5 1/2 dia, 5 1/2 x 5 to 4 x 3 Forged & Finished 1.7.27 to 15.7.27</div>	<div style="writing-mode: vertical-rl; transform: rotate(180deg);"></div>
made ...			
annealed ...			
Dimensions ...			
Pressure on Inspection ...			
When Inspected ...			
CASTINGS.			
Tests on Standard Test Pieces.			
Ball Test—			
Tons per square inch ...			
Extension per cent. ...			
Bending Test—			
Angle before fracture ...			
Drop Test—			
Height from ground ...			
Swinging Test—			
If made according to Rules and found satisfactory ...			

SKETCHES OF FRAMES SHOWING POSITION AND DESCRIPTION OF WELDS OF FORGINGS.

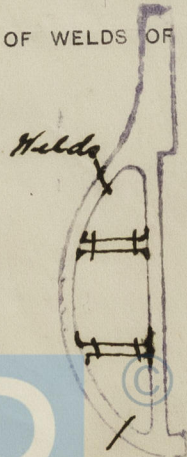

Fee (if any chargeable) £

To be paid at

* If of Iron, state whether scrap or puddled Iron. If of Steel, state whether made on the Open Hearth process.