

S/T CLEVELA

MIDSHIP SECTION

STEEL SCREW TRAWLERS

NOS 1071-72 & 73 & 1087 & 1088
140.0 B.P. * 25.0 EX. * 14.3 MLD.


3979

ENCLOSURE TO

Midship Section to
Messrs Lloyd's Register of Shipping

SHIPBUILDERS' SECTY.

DATE 5-4-30.

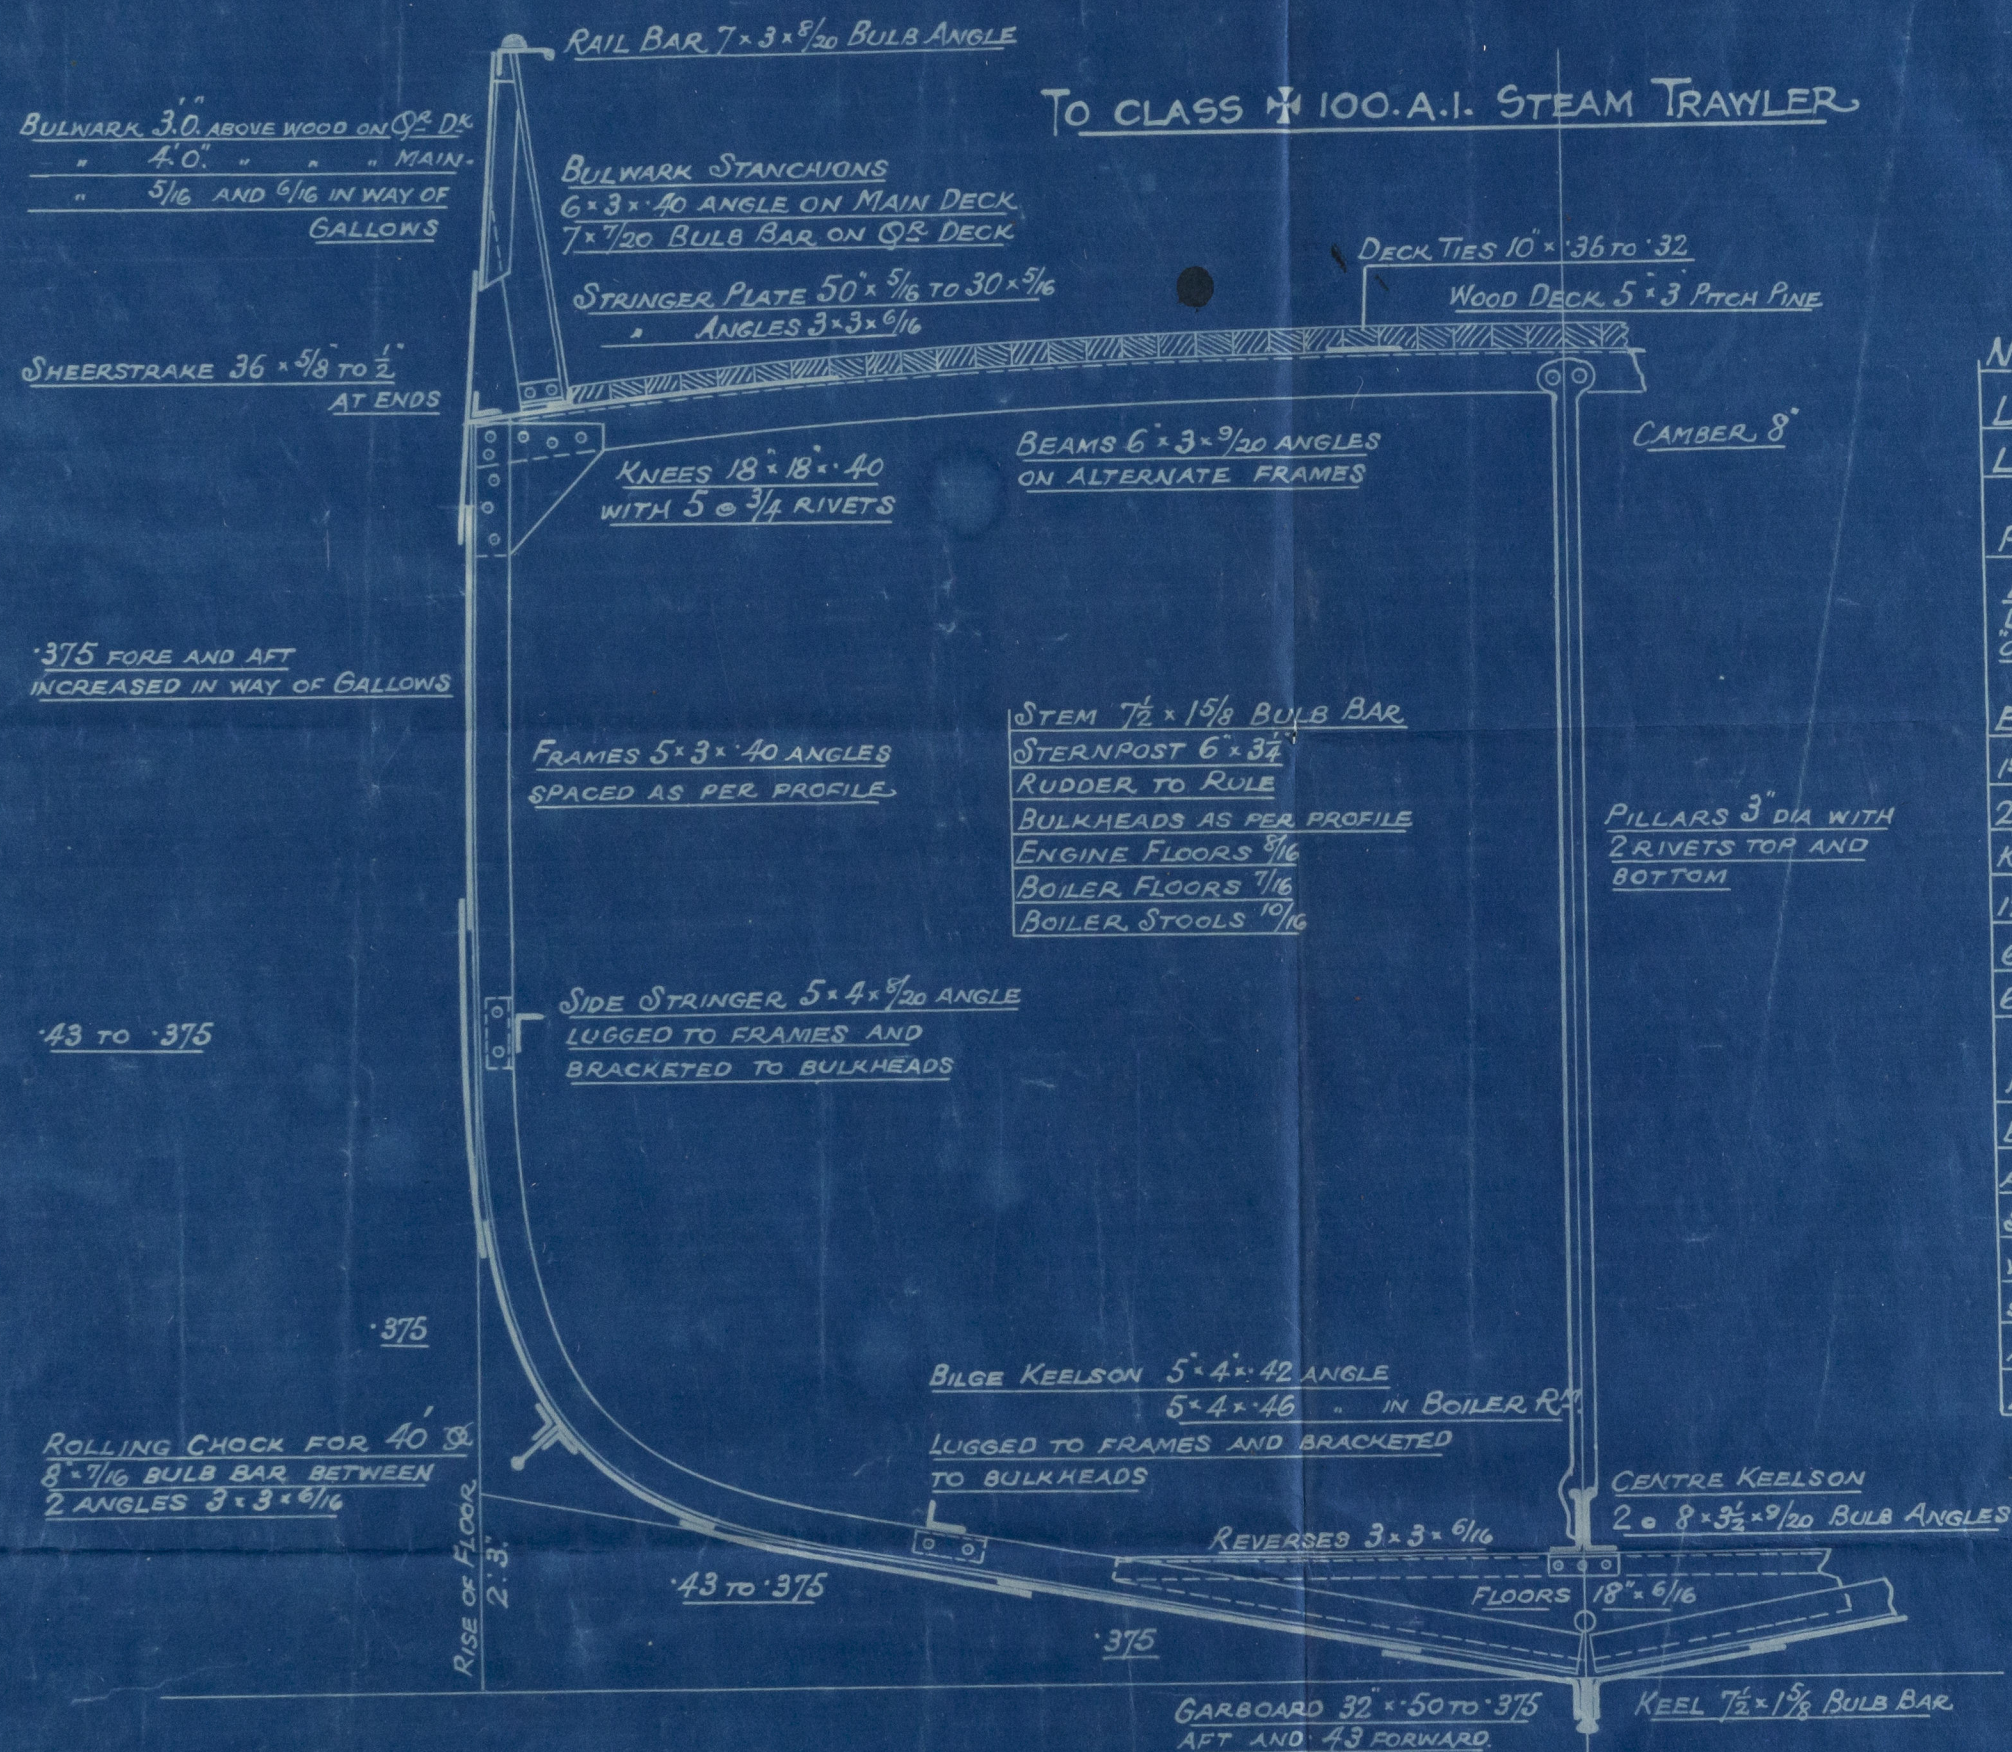

TO CLASS 100.A.1. STEAM TRAWLER

NUMERALS

L x D ----- 1995.00

L x (B+D) ----- 5476.80

PROPORTIONS

L ----- 9.82

D ----- 12.83

EQUIPMENT

1ST BOWER ANCHOR 8 1/2 CWTs - STOCKLESS

2ND " " 7 1/2 " "

KEDGE ANCHOR 3 1/2 CWTs. EX STOCK

120 FMS. 1 3/16" STUD CHAIN CABLE

60 FMS 6" HEMP HAWSER

60 FMS 5" HEMP WARP.

RIVETING

BUTTS OF SHELL PLATING TO BE LAPPED
AND DOUBLE RIVETTED EXCEPT GARBOARD,
SHEERSTRAKE AND E AND F STRAKES IN
WAY OF CHAFING BARS, WHICH ARE TO BE
STRAPPED AND DOUBLE RIVETTED
ALL LANDINGS DOUBLE RIVETTED
BULWARKS SINGLE RIVETTED

SCALE 1/2 INCH = 1 FOOT

No. 1073


Midship Section (as built).

Cochranes Sons & Co.

S.S. "Cleveland"

HULL REPORT NO. 40756

Lloyds

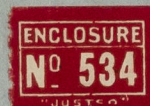

© 2020

Lloyd's Register
Foundation