
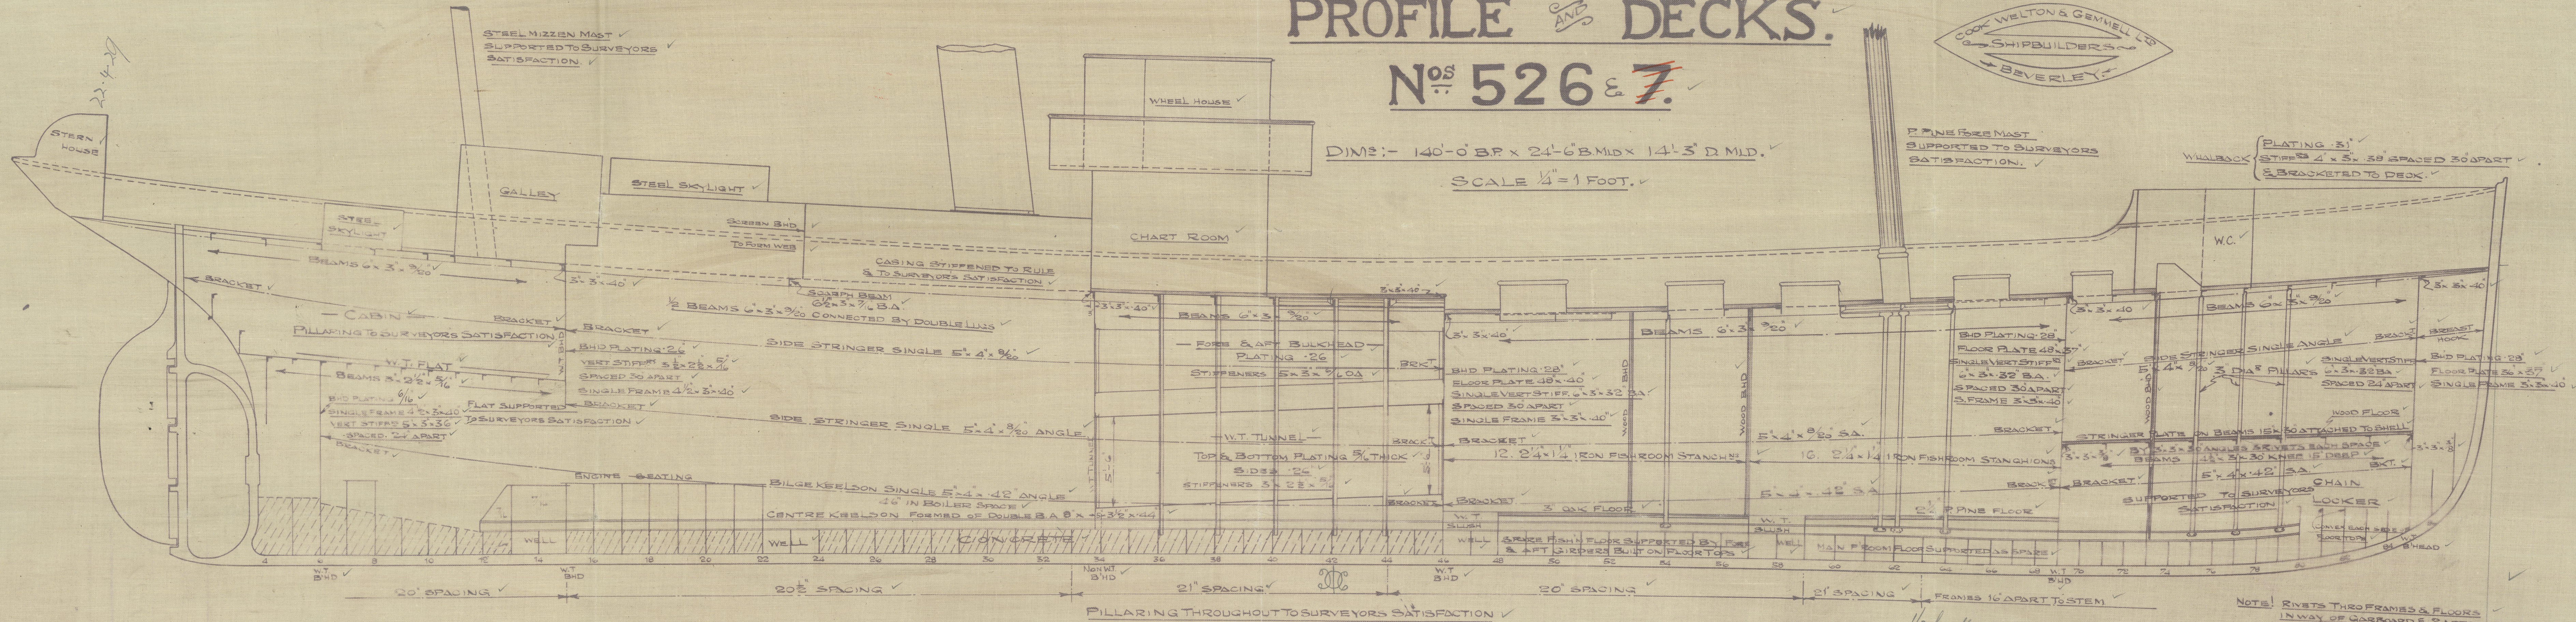


PROFILE AND DECKS.


N^{os} 526 & 7.

DIMS:- 140'-0" BP x 24'-6" BMD x 14'-3" D MLD.


SCALE 1/4" = 1 FOOT.

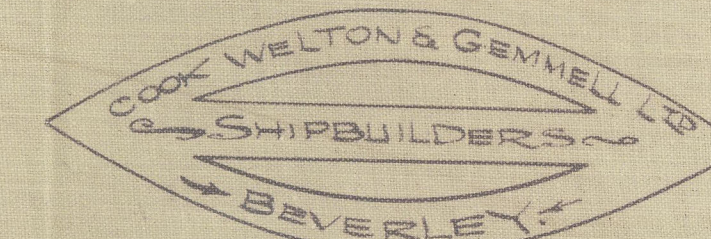

NOTE: RIVETS THROUGH FRAMES & FLOORS IN WAY OF GUNBOARDS & ADJOINING STROKES FORD OF 63 FRAMES TO BE 4 SPART

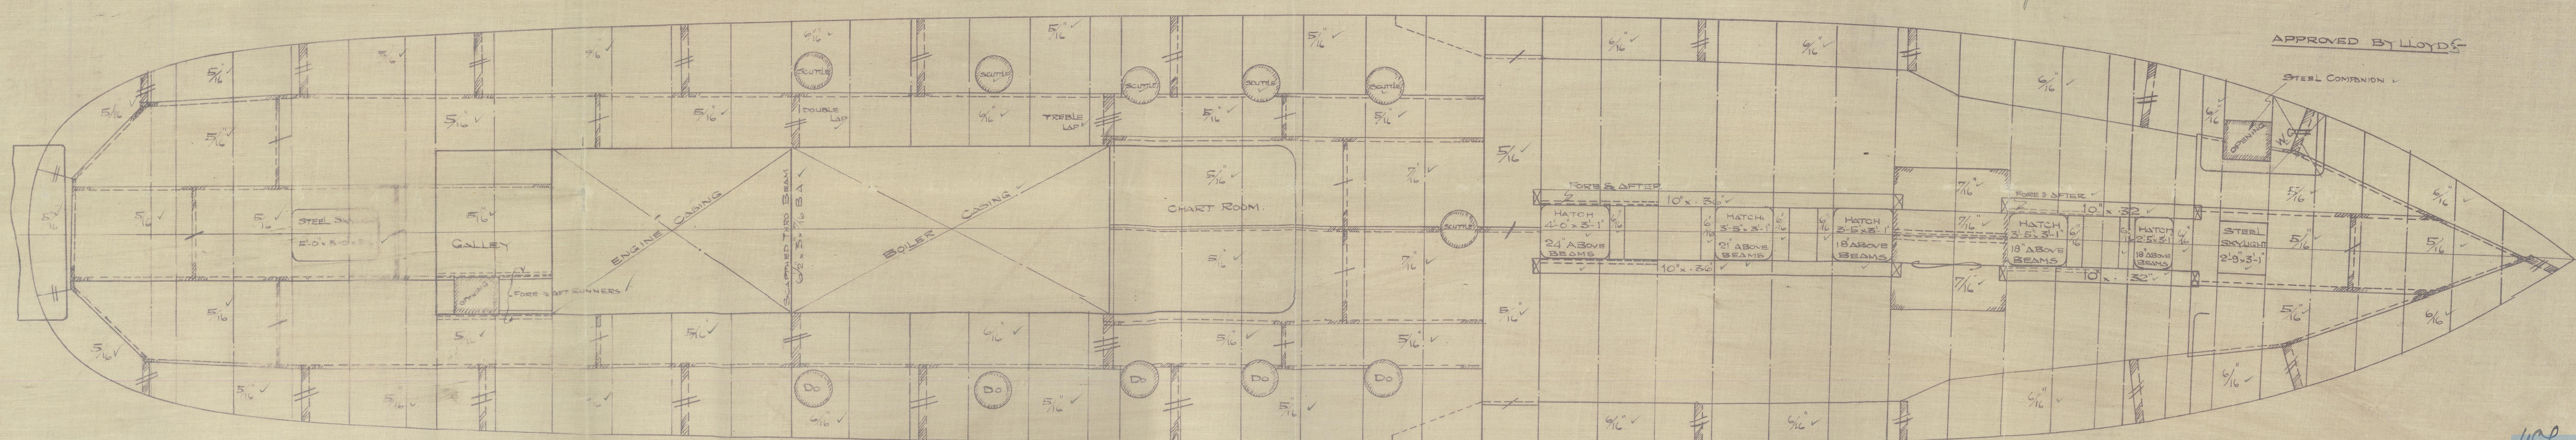

APPROVED BY LLOYD'S

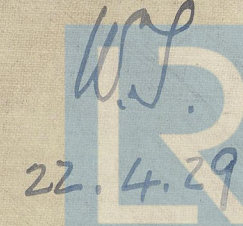

© 2020 Lloyd's Register Foundation

002305-002319-0231

Cook, Welton & Gemmell
Beverley.

Profile & Section
nos. 526-~~4~~
~~7~~

S.S. Galvani

HULL REPORT No. 40236



© 2020

Lloyd's Register
Foundation

002305-002319-0231