

31 MAY 1947

Index No. 20880.
(For London Office only).

39097


Lloyd's Register of Shipping.

SURVEYS FOR FREEBOARD.

(CONDITIONS OF ASSIGNMENT.)

Ship's Name *Elisabeth* Port of Survey *Rotterdam*
 Official Number *✓* Surveyor's Signature *C. J. de Jong*
 Nationality and Port of Registry *Dutch Rotterdam* Date of Survey *19 May 1947*

Disposition and dimensions of superstructures, trunks, deckhouses and machinery casings to be inserted in the diagrams and tabular statement:—

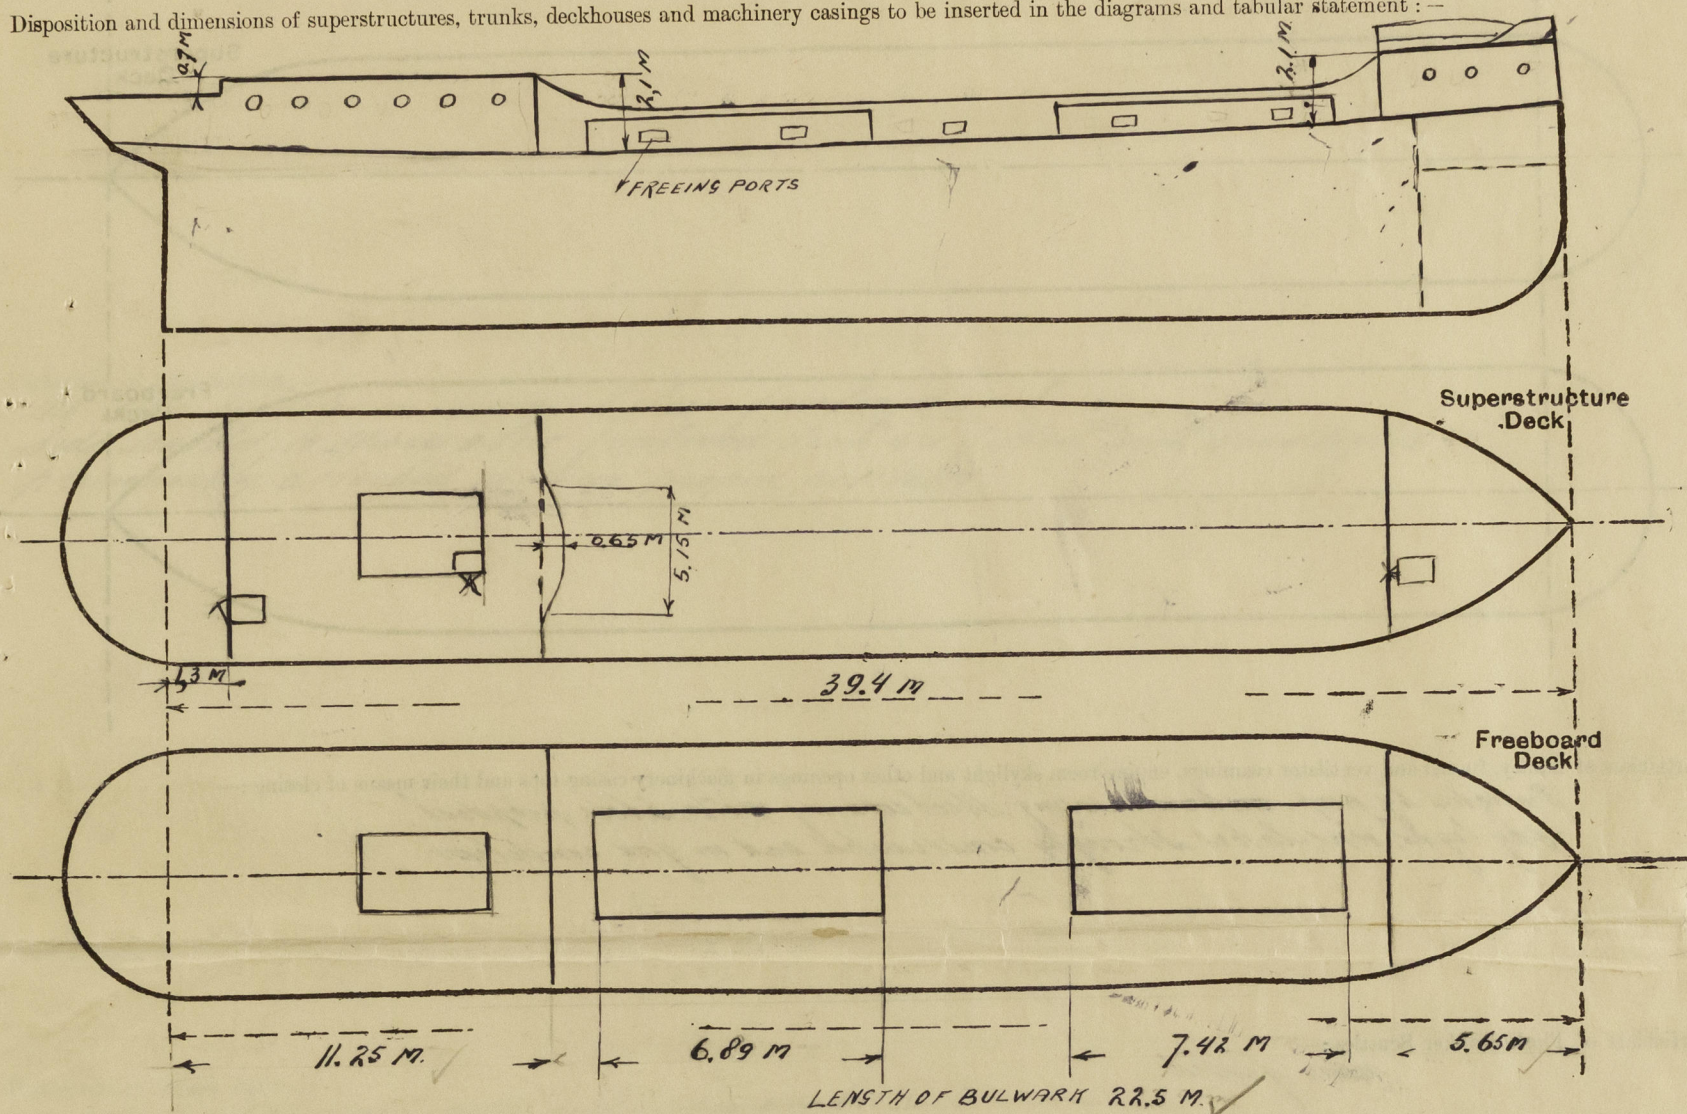

Particulars of Superstructures, Trunks, Casings, Deckhouses.


	Coaming	Plating	Stiffeners	Spacing	End Attachments of Stiffeners	Size of Openings	Height of Sills	Height of Casings
Poop Bulkhead ...	✓	6	✓ 140 × 90 × 9	650	BRACKET KNEES WITH 300 × 400	✓	✓	2100
Raised Quarter Deck Bulkhead ...	✓							
Bridge, After Bulkhead ...	✓							
Bridge, Forward Bulkhead ...	✓							
Forecastle Bulkhead ...	460	6	✓ 75 × 75 × 8	650	BRACKET KNEES WITH 300 × 400	1370 × 700	460	2100
Trunk, Aft ...								
Trunk, Forward ...								
Exposed Machinery Casings on Freeboard or Raised Quarter Decks ...								
Exposed Machinery Casings on Superstructure Decks ...	460	6	✓ 75 × 65 × 7	650	✓	750 × 600	400	400
Machinery Casings within Superstructures not fitted with Class I Closing Appliances ...								
Deckhouses on Flush Deck Ships ...								

Particulars of Closing Appliances (state if capable of being manipulated from both sides).

Poop Bulkhead ...	<i>no openings</i>
Raised Quarter Deck Bulkhead ...	✓
Bridge, After Bulkhead ...	✓
Bridge, Forward Bulkhead ...	✓
Forecastle Bulkhead ...	<i>4 steel hinged doors operated from both sides 1400 × 700 sills 420 mm</i>
Exposed Machinery Casings on Freeboard or Raised Quarter Decks ...	
Exposed Machinery Casings on Superstructure Decks ...	<i>One double hinged door 750 × 600 sill 400 mm operated from both sides</i>
Machinery Casings within Superstructures not fitted with Class I Closing Appliances ...	
Deckhouses on Flush Deck Ships ...	

PARTICULARS OF PROTECTION TO OPENINGS, ETC.

The following diagrams should be used to indicate the positions of cargo and coaling hatchways, gangway, cargo and coaling ports, ventilators, companionways, etc., which would affect the seaworthiness of the ship:—

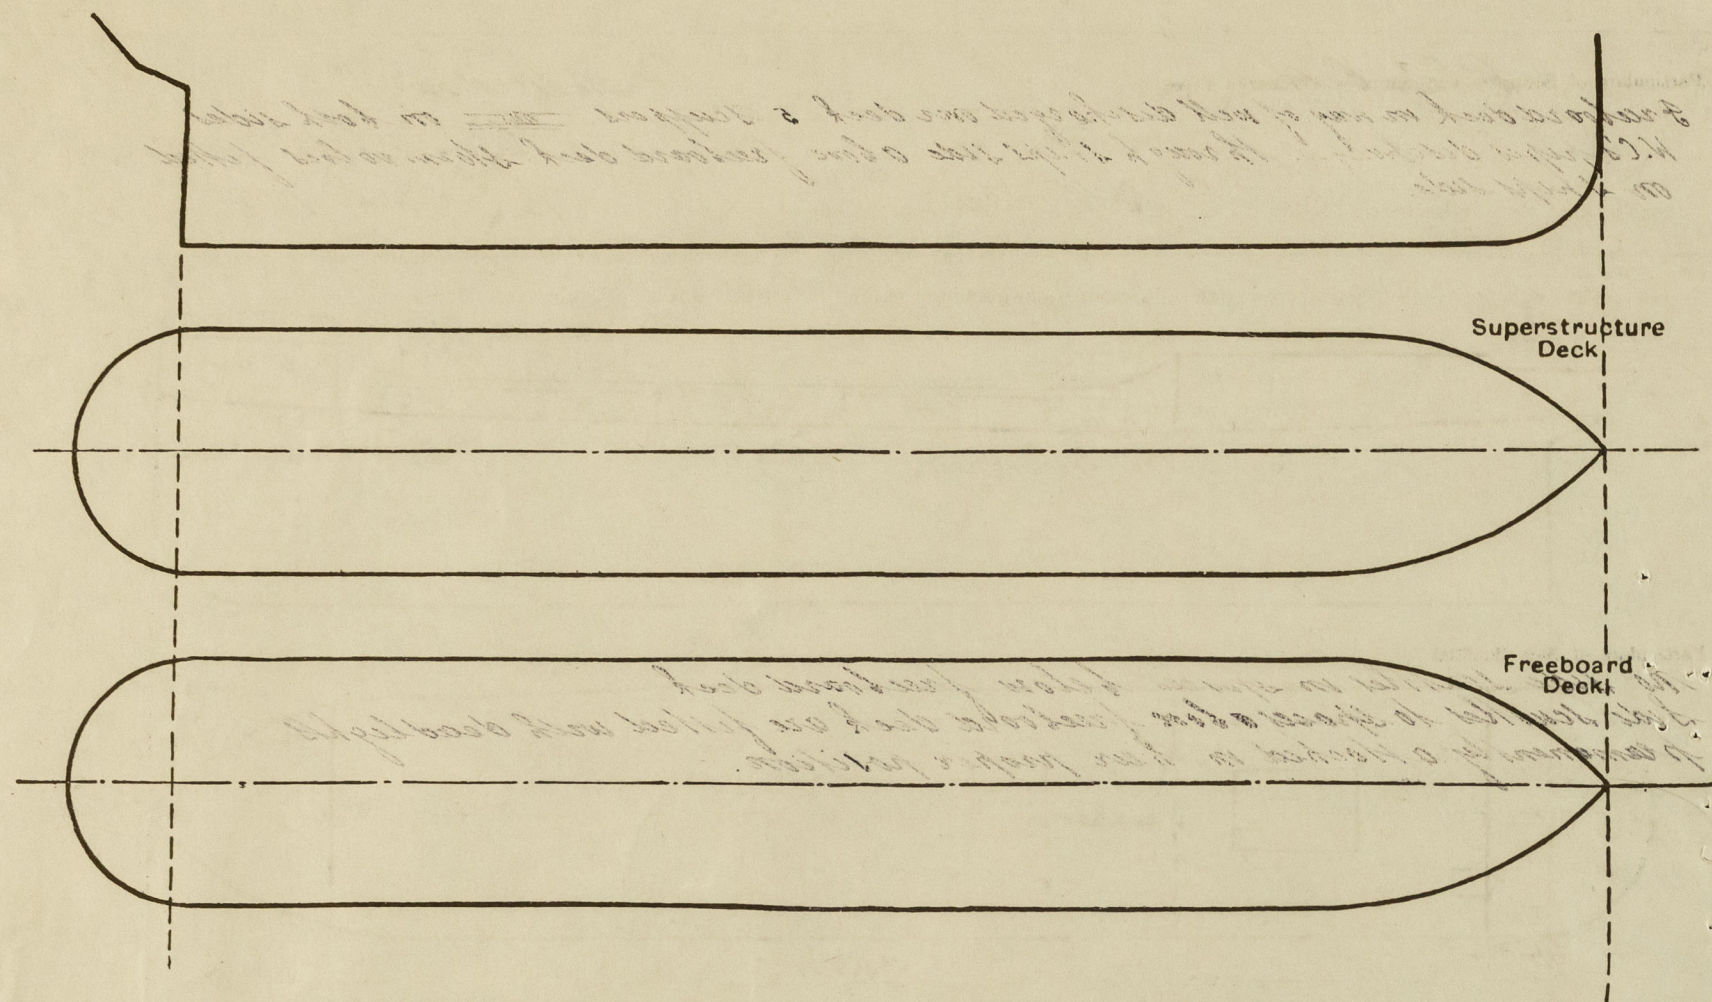

Particulars of fiddle, funnel and ventilator coamings, engine room skylight and other openings in machinery casing tops and their means of closing:—

Protected by prop. motorroom casing steel coaming 400 mm above poopdeck.
Skylight, ventilator strongly constructed and in good condition

Particulars of Flush Bunker Scuttles:—

none fitted

Particulars of Companionways:— On fore-castle steel companion way 920 x 650 x 650 mm high double ordinary hinged doors (steel) 800 x 470 sill 270 mm operated from both sides
On poopdeck steel companion way 1700 x 800 x 600 mm sill 300 mm with lead lined door 1350 x 600 mm 35 mm thick operated from both sides. One steel companion way to motorroom space built in motorroom casing double ordinary hinged doors 750 x 600 sill 400 mm operated from both sides
Entrance poopdeck inside strong wheel house lead door 1600 x 600 x 35 mm sill 450 mm operated from both sides.

Particulars of Ventilators in exposed positions on freeboard and superstructure decks:—

On fore-castle deck one mushroom ventilator
One ventilator 500 high 300 g 7 mm thick
In well one supported ventilator 1600 high 300 g 7 mm thick
On poopdeck 11 mushroom ventilators
2 ventilators on motorroom skylight 600 high 200 g 6 mm thick
Ventilators are provided with wooden hatches and canvas covers

Particulars of Air Pipes in exposed positions on freeboard, raised quarter, or superstructure decks:—

One air pipe on fore-castle deck 260 mm high 50 mm
One air pipe on poopdeck 1000 mm high 50 mm
Canvas covers are available.

Particulars of Gangway Cargo and Coaling Ports:—

Elisabeth.

Particulars of Scuppers and Sanitary Discharge Pipes:—

Freeboard deck in way of well discharged over deck 5 scuppers on both sides
H.C. pipes discharge through ship's side above freeboard deck Storm valves fitted on ship's side.


Particulars of Side Scuttles:—

No side scuttles in spaces below freeboard deck
Side scuttles to spaces above freeboard deck are fitted with dead lights permanently attached in their proper position.

Vertical distance of Sill of lowest Side Scuttle above top of keel 4.90 m.

Particulars of Guard Rails:—

Open rail on fore-castle and poopdeck
Non-chained spaced 1400 mm

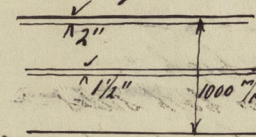

Particulars of Gangways, Lifelines, etc.:—

Steel wire lifelines available and fitted when necessary
from poop to fore-castle deck.

Particulars of Freeing Arrangements.

	Length of Bulwark	Height of Bulwark	Size of Freeing Ports	Number each side	Area each side	Rule area each side
After Well ... } ...	22.5 m	0.95 m	0.60 x 0.40 m	5	1.60 m ²	1.40 m ²
Forward Well ... }						

State position of each freeing port ... } After Well:— 15 cm

(F. and A. position and height above deck edge) } Forward Well:—

State whether the freeing ports are fitted with shutters, bars, or rails, and give particulars of such:— bars 70 mm spaced 200 mm

Additional area where sheer is less than standard.

29880.

PARTICULARS OF PROTECTION TO OPENINGS, ETC.

HATCHWAYS ON FREEBOARD AND SUPERSTRUCTURE DECKS.											
Description of Hatchway		NO 1		NO 2							
Dimensions of Hatchway		7470 x 3600		6090 x 3600							
COAMINGS	Height above Deck	800		800							
	Thickness	Sides	11.5		11.5						
		Ends	11.5		11.5						
	Stiffeners	L 140 x 65, 8		L 140 x 65, 8							
Brackets, Stays											
HATCH BEAMS	Number	2		2							
	Spacing	2500		2300							
	Scantling and Sketch										
	Bearing Surface	75		75							
FORE AND AFTERS	Number	3		3							
	Spacing	equal		equal							
	Unsupported Lengths	1020		1020							
	Scantling* and Sketch										
Bearing Surface		75		75							
HATCH COVERS	Material	white pine									
	Thickness	65									
	How fitted	thru ships									
	Bearing Surface	75									
Spacing of Cleats		450									
Number of Tarpaulins		2									
<p>*Are wood fore and afters steel shod at all bearing surfaces? <input checked="" type="checkbox"/></p> <p>Are battens and wedges efficient and in good condition? <input checked="" type="checkbox"/></p> <p>Are tarpaulins in good condition and in accordance with rule requirements? <input checked="" type="checkbox"/></p> <p>Are lashings provided in accordance with rule requirements? <input checked="" type="checkbox"/></p>											

Particulars of any special features:—

Endorsement at first survey and at surveys for renewal of Certificate:—

The fittings and appliances are in accordance with the particulars shown on this form (or as now modified) and are in good condition.

