
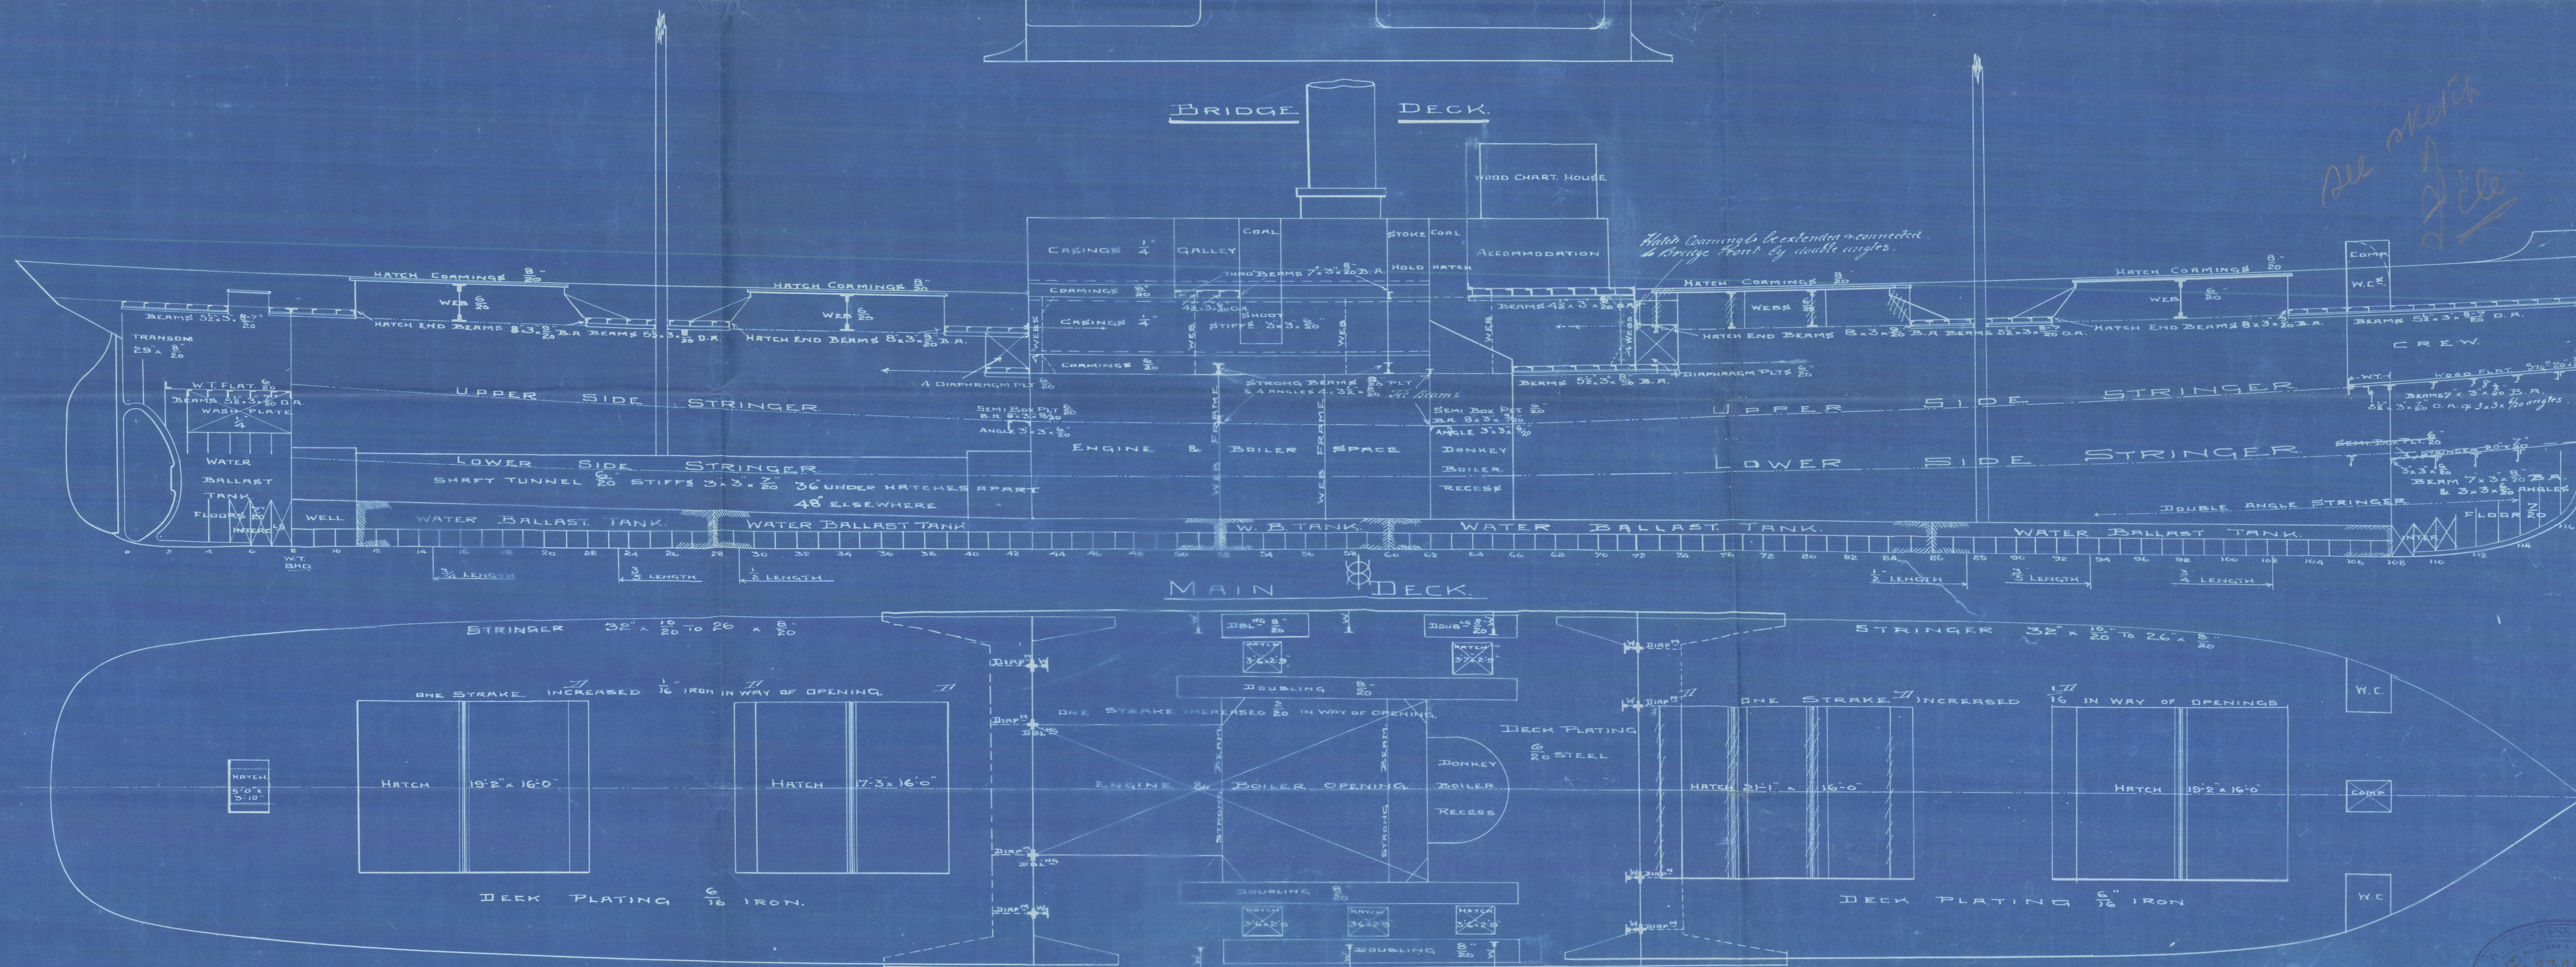


Corrected to Lloyds Approved Plan
April 27th 1900

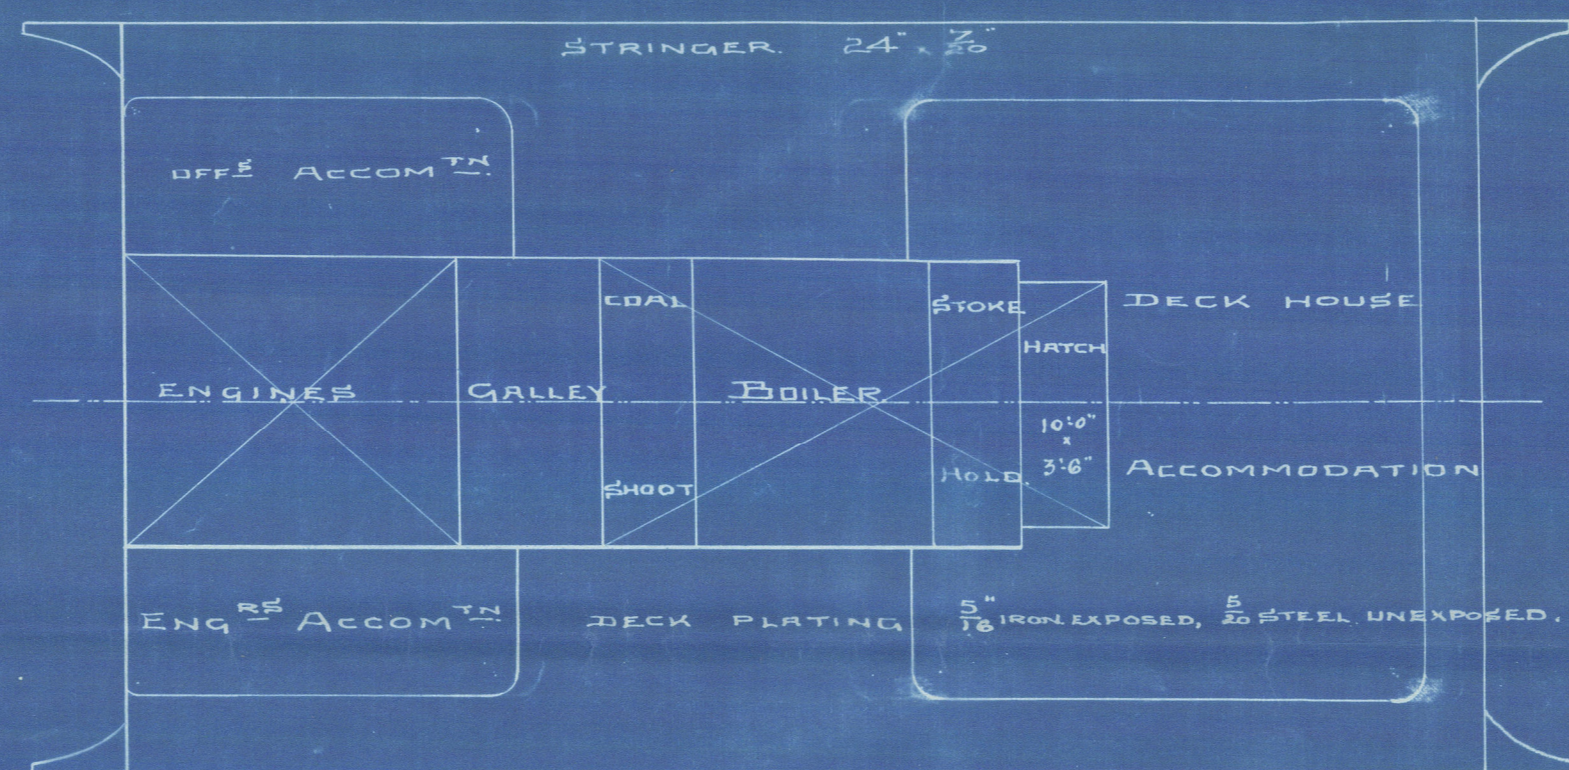

W. HARKNESS & SON
SHIPBUILDERS & REPAIRERS
EAST SLIPWAY
MIDDLESBROUGH-ON-TEES

QUARTER DECK AFT

PROFILE & DECK PLANS

LENGTH BP 225'0" BREADTH EX. 34'0" DEPTH M^d. 16'6"
TO CLASS 100 A1A1 LLOYDS. RAISED QUARTER DECK.
SCALE

QUARTER DECK FORD

N^o 153 & 420

3 pre registers

9+8

7+7



© 2020

Lloyd's Register
Foundation


Profile

W. H. Kess & Sons.

No 154 & 3.




Mar Report No 3098

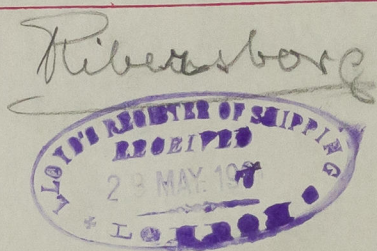

RIVERSBORG

RECORDS DEPT.,
LONDON.

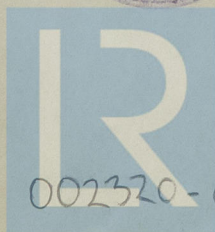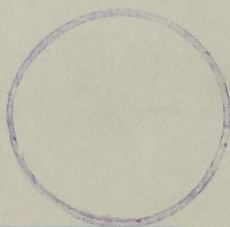

© 2020

Lloyd's Register
Foundation

002320-002329-0010