
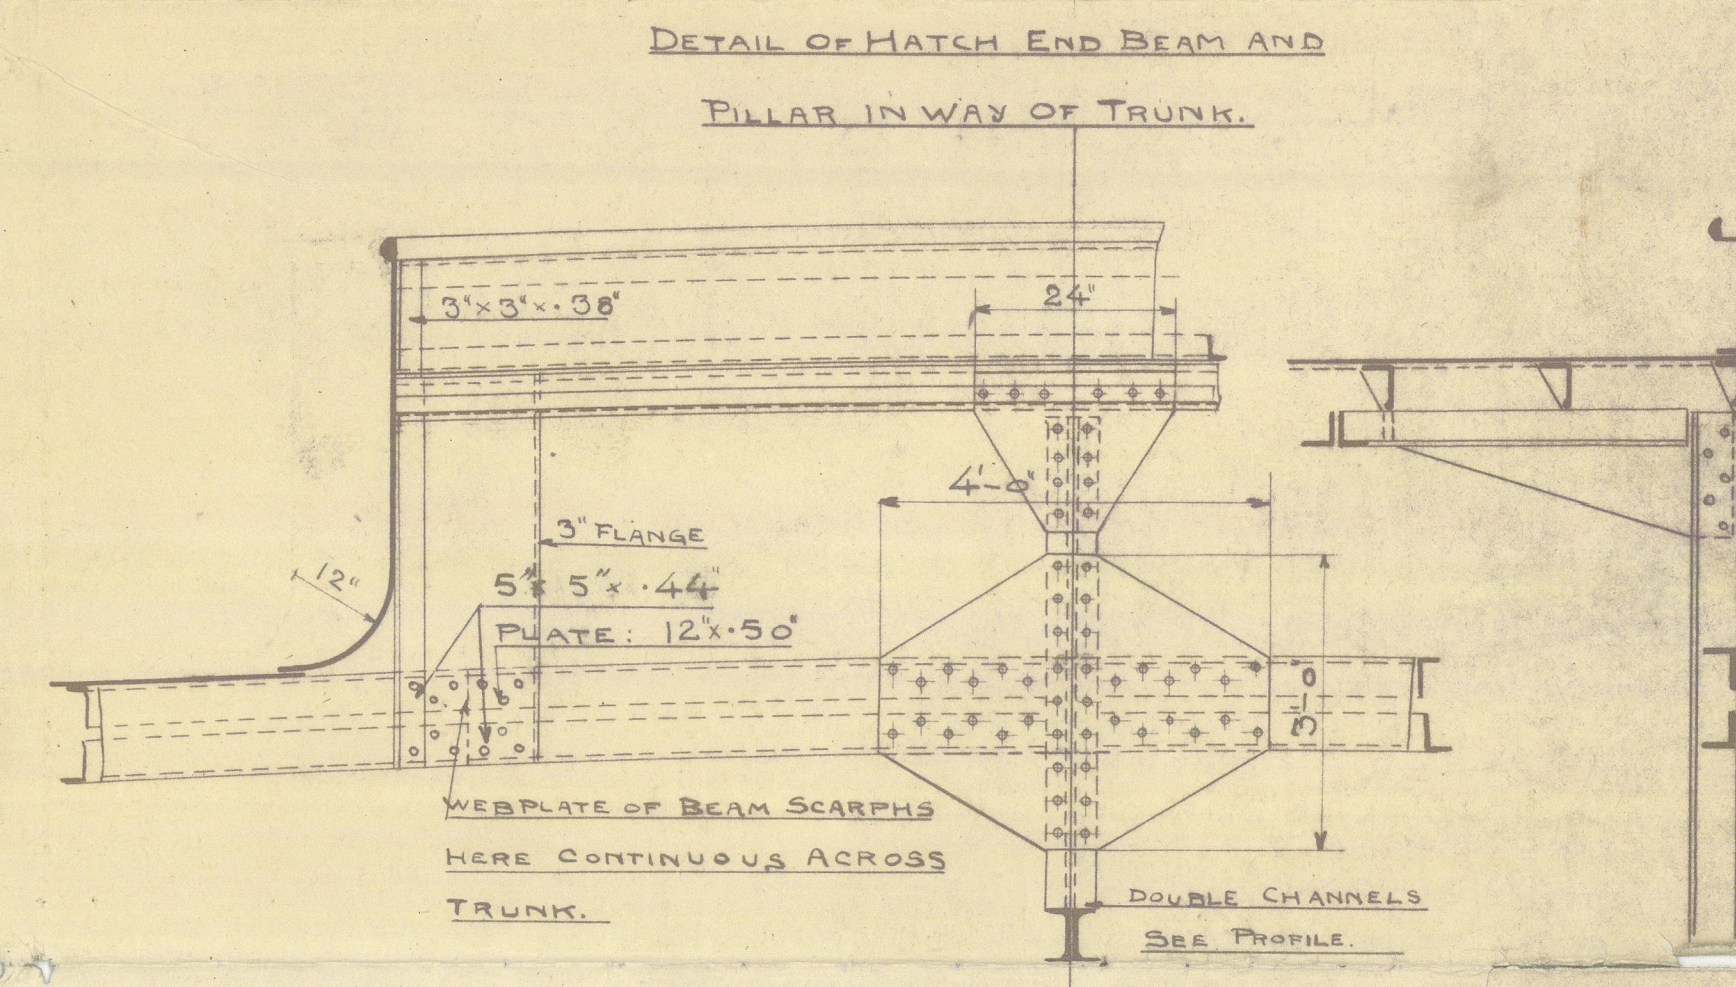


1.8.13  
LENGTH BETWEEN 7  
BREADTH MOULDED

## DIMENSIONS

EQUIPMENT.

### EQUIVALENT SECTIONS

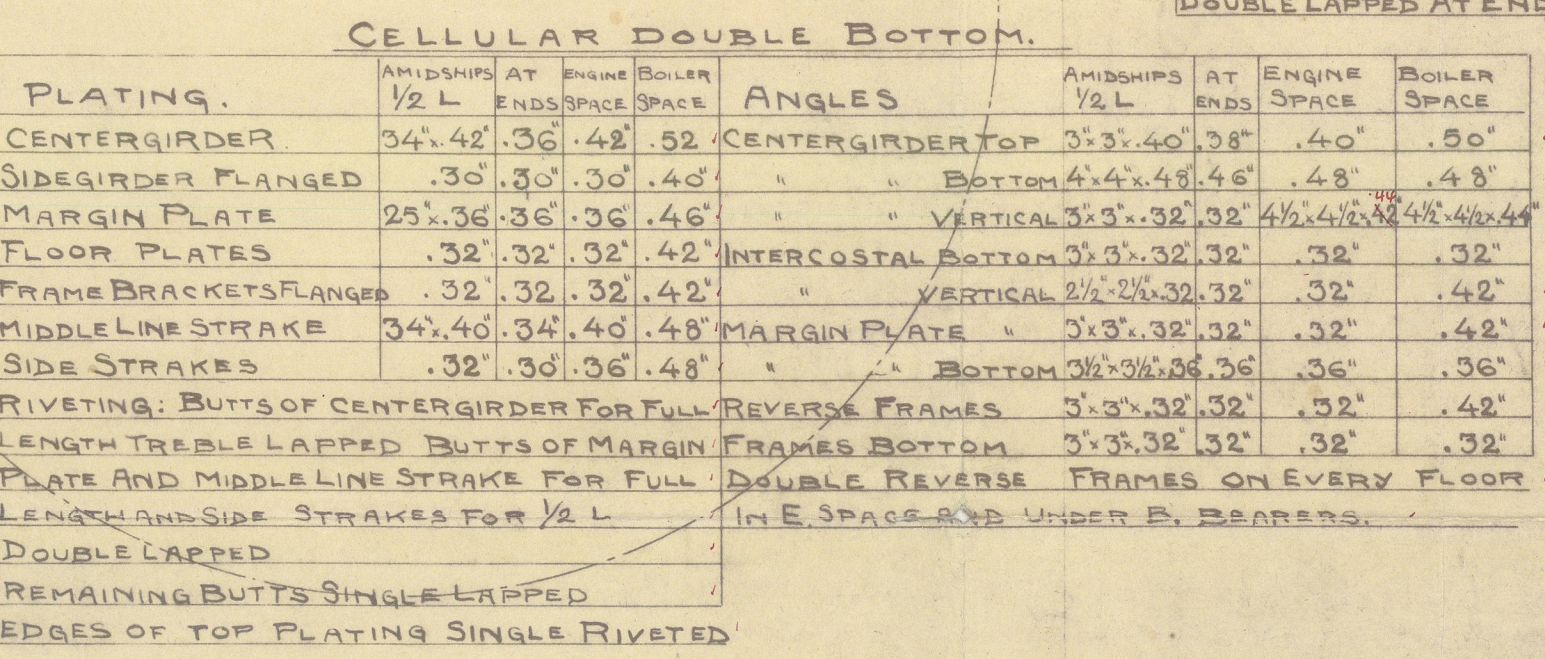

S.S. 118.

MIDSKEPPSSEKTION.

SKALA: 1:24

RIT. 24.7.10 1/2

KOP.

GR.

QDK

KOKKUMS MEK. WERKSTADS A.B.

MALMÖ

© 2020

F.A.

118.

Lloyd's Register  
Foundation



Kockums Mask. Verkstads AB.




Malmö

New building No 118.

Midship section.

Off Johan Larsson

Opn. 4276

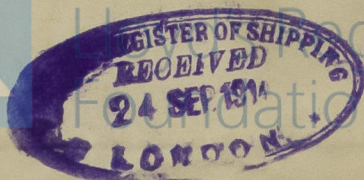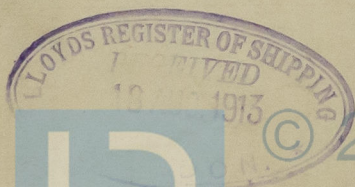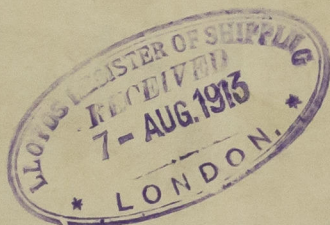

002320-002329-0120