

~~EX-1~~ **Lloyd's Register of Shipping.**
SURVEYS FOR FREEBOARD.—STEAM SHIPS.

PARTICULARS RELATING TO ALL STEAM SHIPS EITHER FLUSH DECKED, OR WITH
TOP GALLANT FORECASTLES, SHORT POOPS AND BRIDGE HOUSES DISCONNECTED, OR
WITH TOP GALLANT FORECASTLES HAVING LONG POOPS, OR RAISED QUARTER DECKS
CONNECTED WITH BRIDGE HOUSES, OR OTHERWISE.

Port of Survey Ipswich
Date of Survey 26-1-25
Name of Surveyor A. E. Farmer

Ship's Name. E Rose & NEVILLE	Port of Registry and Nationality. Yarmouth	Official Number. 113757	Gross Tonnage. 265	Date of Build. 1903-8	Particulars of Classification. H 100 A.1
Number in Register Book 78308.					
Registered dimensions from Ship's Register.	LENGTH. 129.8	BREADTH. 22.45	DEPTH. 9.0	UNDER DECK TONNAGE. 172.	
Length on LOADLINE.	129	Frame Depth 4 Rule " 8 x 2 - - 17	Ceiling fitted Sheer +.37.	Peak 1.2 Tanks	Moulded Depth as measured..... 9.6 Addition for Keel below base line for draught record..... inches.
CORRECTED DIMENSIONS.	129.0	22.28	9.57 2.63	173.2	
Co-efficient of fineness.....	.699 .64	.630			NOTE.—If the depth is measured when vessel is afloat, the details of measurement should be reported.
Any modification necessary [Para. 4 (a) to (e)]*	-	10.6 646			
Co-efficient as corrected	70	.68 Lower in Table 36.86			
Sheer { Stem 48.46 at Sternpost 24.21 } 72 ÷ 2 = 36 ...Mean		22.90 36 / 18.46 .37			
Sheer at $\frac{1}{3}$ of the length from { Stem 29.26.5 Sternpost 15.13.5 } 40 ÷ 2 = 20 ...Mean		÷ .53 = 36.36			
Gradual mean Sheer	36.18	20.00			
Standard mean Sheer [Table, Para. 18]	22.90	18.74 6.26 Correction			
Difference.....	13.28	÷ 4 = 3.32			
§ If limited as Para. 18 (f)		- 8 1/4 " Para. 11 - 1 1/2 " " 14			
Rise in Sheer { At front of bridge house..... from amidships [Para. 18 (e)] { At after end of forecastle		✓			
¶ Fall in Sheer { Para. 18 (d) { ✓ ÷ 2 = ✓					
Length uncovered		✓ Correction			
ALLOWANCE FOR DECK ERECTIONS :—					
Freeboard, Table C.....		Paral / Paral 14			
Correction for Length, if required (Para. 12, 13, and 14)		0 - 1/2 / 0 - 1/2 + 1/2			
Freeboard by Table A, corrected for sheer and for length if required (Para. 12, 13, and 14)		paral / paral 14	0 - 11/4 / 1 - 1/4 0 - 10/4 / 1 - 2 1/4 40% / 32%		
Difference					
Percentage as below.....					
Sheer Length Erections F. Ports.....	48.11 - 3/4 + 1/2 - 4 + 1/4 = 5 1/2 @ 4/10	4.10 4.56			
14 - 1/2 + 1/4 - 4 1/2 = 14 1/4 @ 4/10		6.44 - 4.42			
For Erections - 5 1/2 - 14 1/4		3/4			
Correction for R. Q. Dk. if engine and boiler openings not covered by bridge house (Para. 11)		✓ (under 10ft M.D.)			
Allowance for Deck Erections					
Length.....	18' 19.0	Length allowed.....	17.56	Height.....	6' 6"
Forecastle.....					
Bridge House	19'		19.00		7' 6"
† Raised Qr. Dk.	40 41.0 X 2.75 / 3.19		35.35		2' 9"
Poop.....					
Total	89.0	6.12	71.91		.558
Length of Ship	129.0		129.00		
Corresponding percentage (Para. 11, 12, 13, or 14)					

FREEBOARD recommended amidships from centre of Disc to top of Statutory Deck Line, Wood (Steel) Deck :—

Fresh Water Line	above centre of Disc
Indian Summer Line	" "	"
Winter Line	below "	"
Winter North Atlantic Line	" "	"

If the frames, skin planking, or ceiling are of unusual thickness the breadth of vessel to inside of ceiling should be reported if possible.
In vessels obtaining an allowance for deck erections under Para. 11 where the sheer drops abaft amidships the height of the R.Q.D. is to be taken from the level of the top of the amidships beam.
In vessels having poops and forecastles the total standard mean sheer means the sheer measured at the stem and stern-post. In vessels having poops and forecastles, it means the sheer measured at points distant one-eighth of the vessel's length from stem and stern-post.

State dimensions of freeing port area on back of this form.

The Surveyor should state whether the fall in sheer as reported is measured relatively to the straight line of keel or to the water line. If measured relatively to water line the vessel's draft at time of survey, and also the usual load draft forward and aft should be reported.

MARKING FORM

24 OCT 1925

RECEIVED

MARKING FORM

14 JAN 1925

RECEIVED

002320-002329-0145

© 2020

Lloyd's Register Foundation

Do all the Frames extend to the top height in the Poop? ✓ Raised Quarter Deck? Yes Bridge House? Yes Forecastle? Yes

To what height do the Reverse Frames extend? Across floors only. ✓

Has the Poop or Raised Quarter Deck an efficient Iron Bulkhead at the fore end? Yes

Give particulars of the means for closing the openings in Bulkhead None.

Is the Poop or Raised Quarter Deck connected with the Bridge House? Yes

Has the Bridge House an efficient Bulkhead at the fore end? Yes

Give particulars of the means for closing the openings in Bulkhead None.

What is the thickness of the Bridge Front plating? $\frac{3}{2}$ and Coaming plate? None.

Give scantlings and spacing of the Stiffeners $4\frac{3}{4} \times 2\frac{3}{4} \times \frac{3}{2}$ Angles Average spacing 31"

Are bracket plates fitted at each end of the Stiffeners? Yes Are hor'l. brackets fitted connecting Bridge Bulk'd. with Bulwarks? Yes.

Are bracket plates fitted at each end of the Stiffeners? Yes

Has the Bridge House an efficient Iron Bulkhead at the after end? Yes

How are the openings closed? None.

Is the Forecastle at least as high as the main or top-gallant rail? Yes

Has the Forecastle an efficient Iron or Wood Bulk'd. at after end? Part iron part

Are the Engine and Boiler openings covered by a Bridge, Poop, Raised Quarter Deck, or enclosed by a Strong Iron or Steel Deckhouse?

Raised quarter dk. & stbd casings

If the openings are not so protected are the exposed parts of the Casings efficiently constructed? Yes

Give thickness of plating; scantlings and spacing of Stiffeners No plating. $\frac{3}{2}$ boarings.

What is the height of the exposed Casings? 7'-0" Are suitable means provided for closing all openings in them in bad weather? Yes

Are the Weather Deck Hatchways efficiently constructed and at least equal to the requirements of Section 28 of the Rules for 1904-5? Give particulars below:—

Position and Size.		MAIN HATCH. 29'0" x 14'0"		FORE HATCH. 4'0" x 3'5"							
Item.		Ship.	Rule.	Ship.	Rule.	Ship.	Rule.	Ship.	Rule.	Ship.	Rule.
COAMING. Thickness	Height above top of DECK Sides..... Ends.....	42" 44" 40"		30" 40 40							
SHIFTING BEAMS OR WEB PLATES.	Number Section and Scantlings Material	2 Plates 16" deep 36 thick 2 angles top + bottom $\frac{3}{2}$ " $3 \times 3 \times 20$	20+38 3+37.48	nil							
* FORE AND AFTERS.	Number Section and Scantlings Material	3 Center 10x8 $\frac{3}{4}$ " Sides, 5x5" $\frac{3}{4}$ " Patch pine	8x7 See marking form.	nil							
HATCHES	Thickness Remarks.....	3.		3.							

* The depth of Fore and Afters should be stated from the underside of the hatches in all cases.

(If the sill of the lowest side scuttle will be less than 6 inches above the Indian Summer Load Line if assigned under the tables, state vertical distance from top of deck at side amidships to lower edge of lowest side scuttle.)

The following information is to be given in all Cases of vessels dealt with under Paras. 11, 12 (under 15 feet Moulded depth) and under Shelter Deck Rules.

What is the thickness of the Bridge Sheerstrake? ✓

Strake between Main and Bridge Sheerstrakes? ✓

M.

Delete the words { The Crew, are not, berthed in the bridge house.

that do not apply { The arrangements to enable them to get backwards and forwards from their quarters are, ~~are not~~ satisfactory.


Length of Bulwarks in well ~~50~~ 54 feet.

Area of Freeing Ports required by Para. 11 (e) each side of vessel = 11.5 Sq. ft.

Ft. Tenths. Ft. Tenths. No. $1.8 \times 2.5 \times 2$ EACH SIDE Freeing Ports (each side of vessel) = 9.0 Sq. ft.

There are 3 scuttles each side
 $4\frac{1}{2} \times 4$.

Total deficiency or excess = 2.5 Sq. ft.

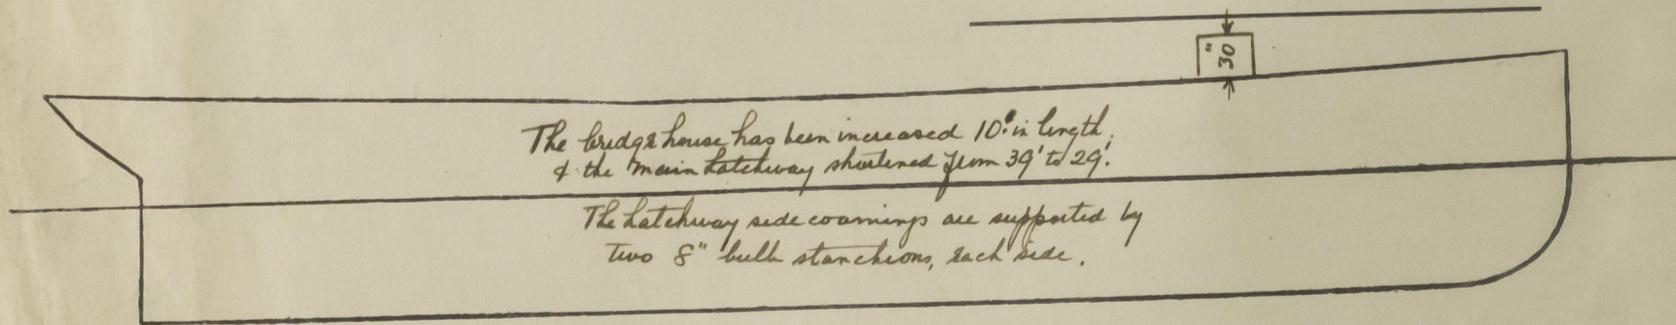

Show hereon line of Floors or Tank Top with position of any Breaks in same; also height of Peak Tank tops, &c., &c.

State any special features in the construction of the Vessel

Builder's name and yard number

Names of sister vessels

Owners

, Address

Fee £ 2 : 0 : 0

Received by me 2/2/15 JWW

