

19.2.03
 35.2.03
 9.4.03
 3.7.03



N^o 241.

PROFILE & DECK PLANS

DIMENSIONS

130'-0" BP. 22' 1/2" x 9'-6" MOULDED.

SCALE 1/8" = 1 FOOT.

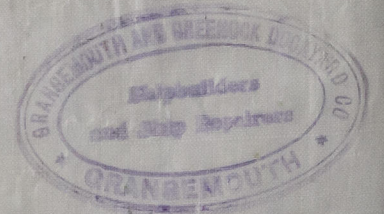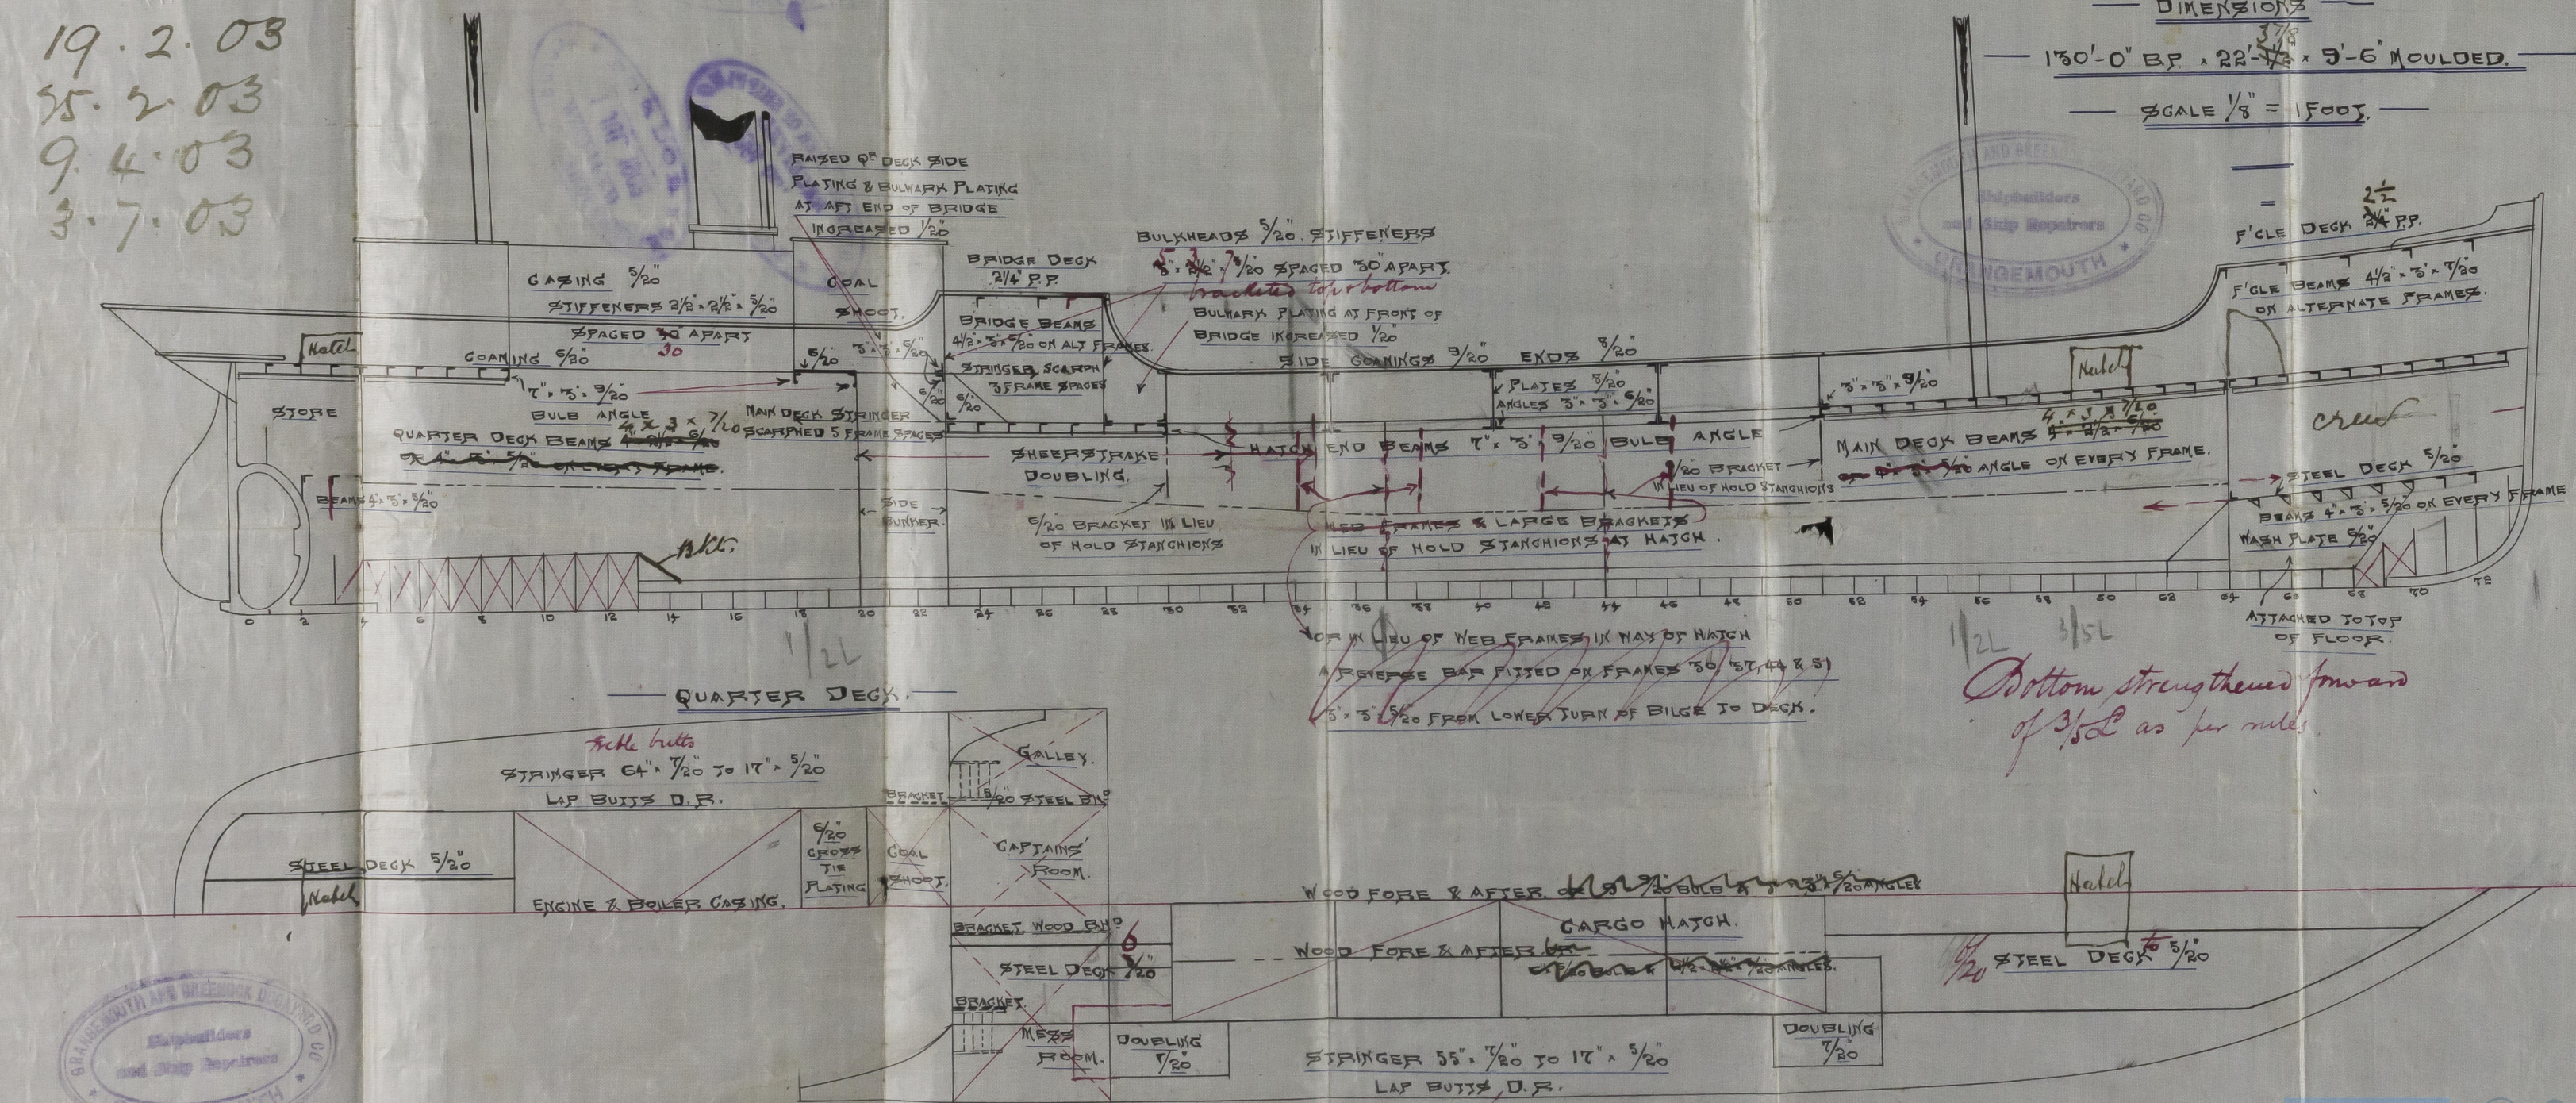

002320-002329-0171




© 2020
 Lloyd's Register
 Foundation


Profile
241
Granghish Dock Co.
Lith
S.S. "WOODLAND" (ROTA)

Lith Ref No 10518
17 FEB. 1903
LONDON

ROTA

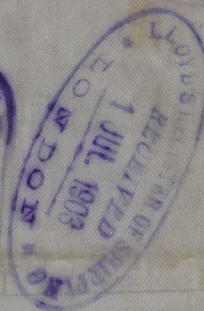

10. 2. 10
10. 4. 2
10. 4. 10
10. 4. 10

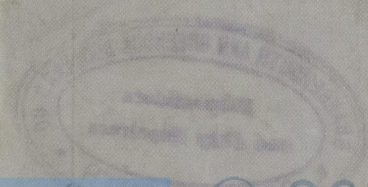

© 2020

Lloyd's Register
Foundation

002320-002324-0171