



SCALE $\frac{1}{2} = 1 \text{ FI.}$

SCALE $1\frac{1}{2}" = 1 \text{ FI.}$

SCALE 3" = 1 FT.

19.2.13.

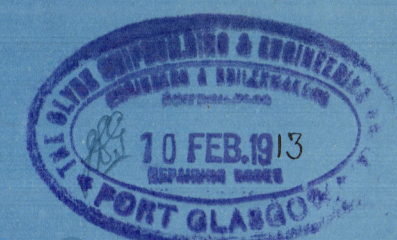

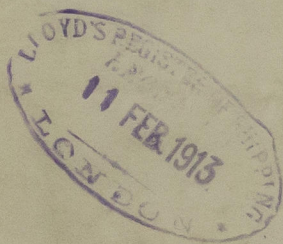

© 2020


Lloyd's Register
Foundation

8. N^o 308-9.

Sternframe & Kudder:

Messrs.

The Clyde St^r,
Eng, Co., Ltd.

308. 8. Kother 
GREENOCK Ref. No 16681

309. 8. Rye
GREENOCK Ref. No. 16703.



Lloyd's Register
Foundation

002330-002339-0001