
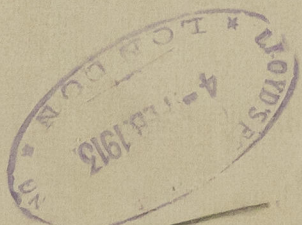
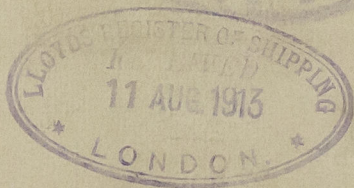
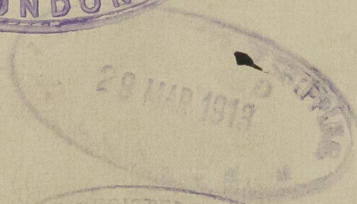


1/2 No 308-G.

Midship Section
(Amended.)

Messrs,
The Clyde S.S. Co.,
Company Limited,

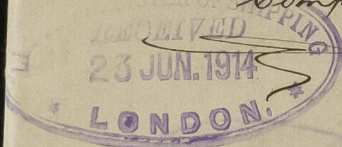


6180E

308. 1/2 "Rother"
★ GREENOCK R.M. No. 16681

309. 1/2 "Rye"
GREENOCK R.M. No. 16703.



© 2020

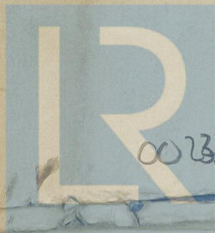

002330-002339-0000
Lloyd's Register
Foundation