

18 SEP 1953

Rpt. C. 11 (Contd.)

Index No.


Lloyd's Register of Shipping.

Ship's Name

Bozher

Official No. 128883

Existing pump argh
 Memorandum of alterations reported since ship was surveyed for assignment of Load Lines
 in accordance with ton letter dated 10th July, 1953.

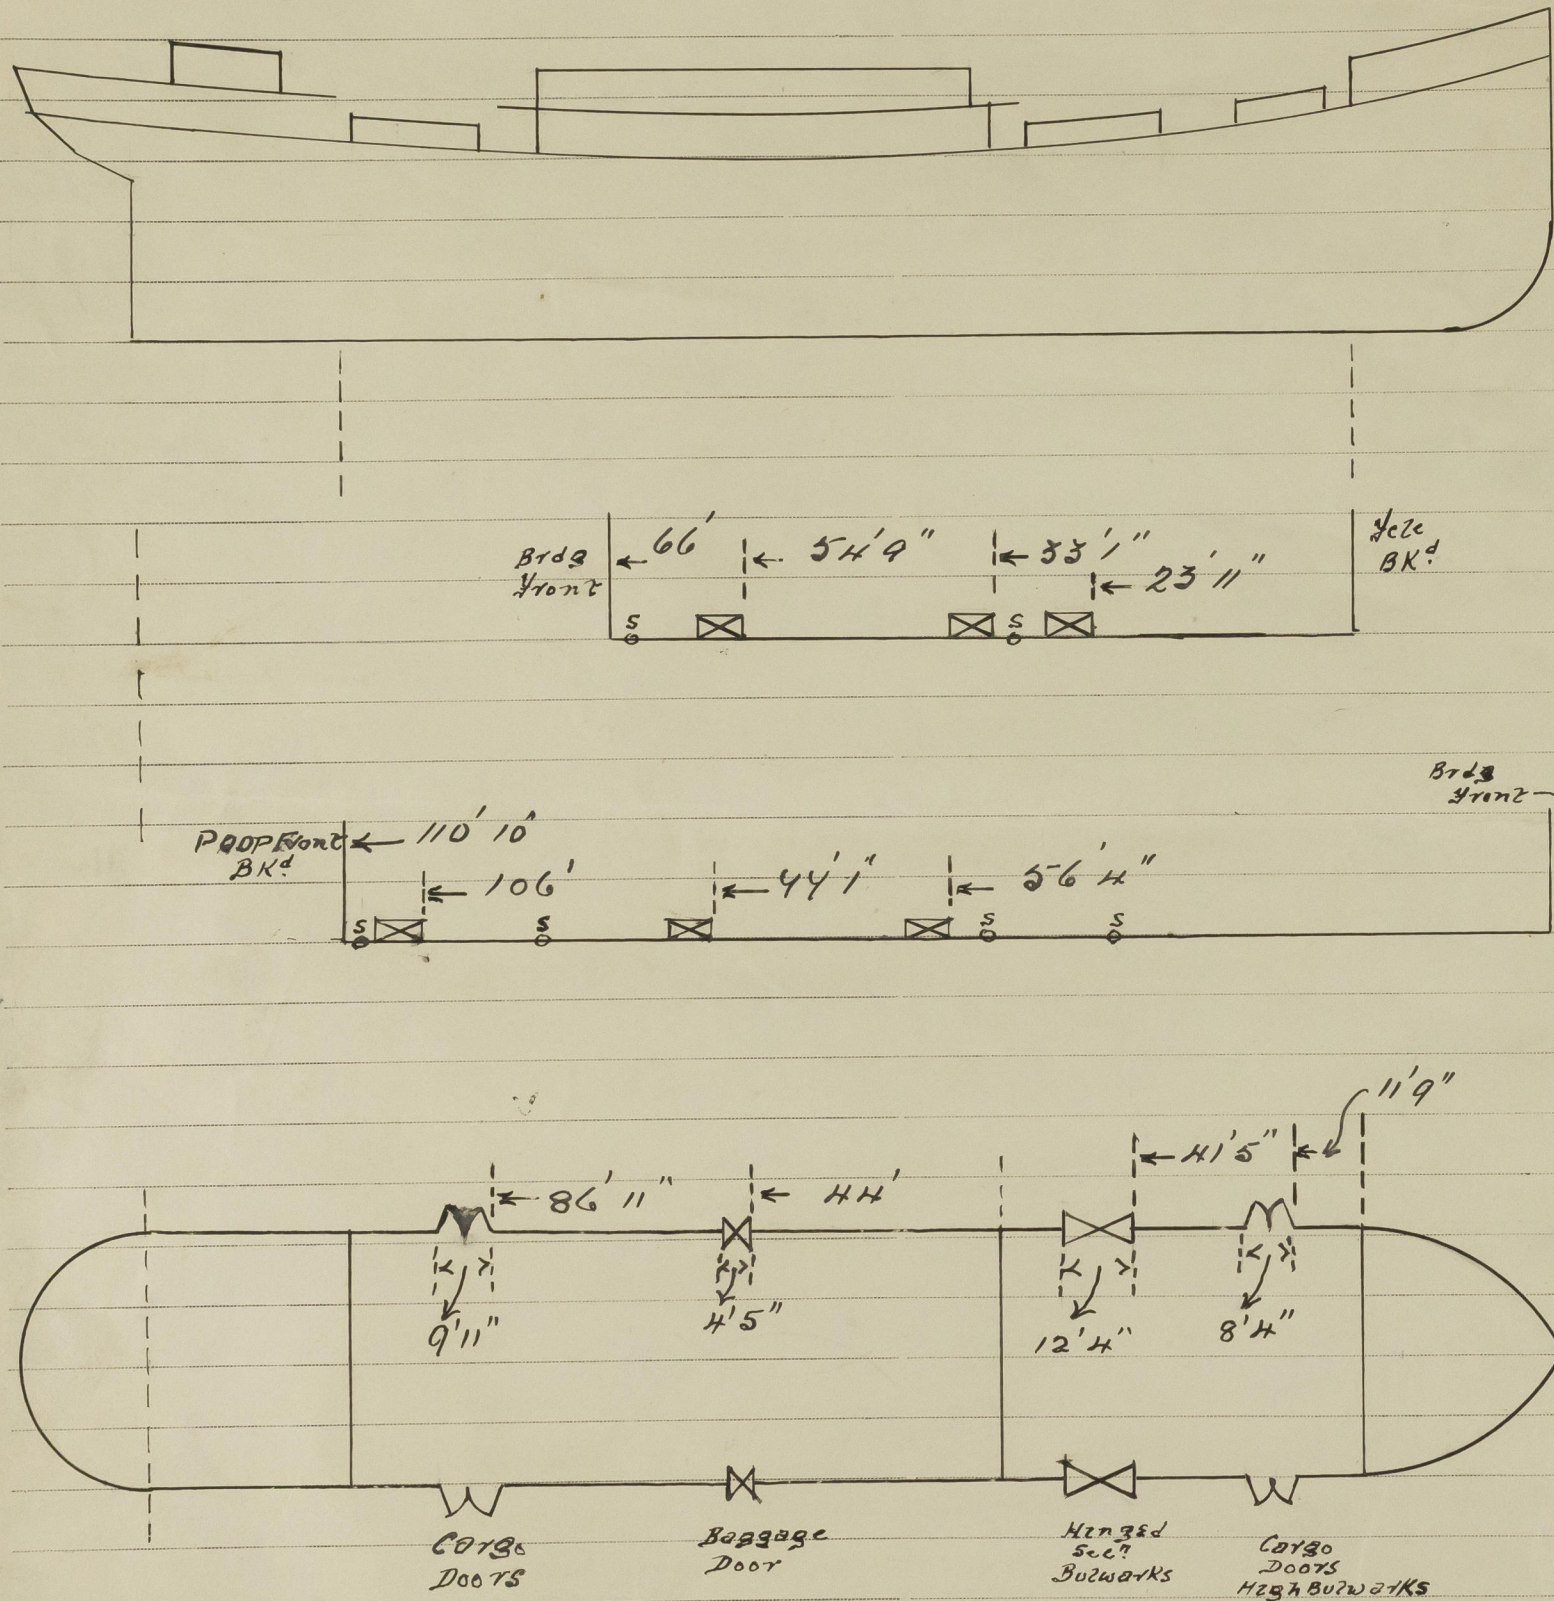

Three framing ports 2'6" x 1'10" with height of sill 12" hinged shutters
 (2 P: 25) H" Scuppers ⑤ fitted with N.R.V discharging through ships side below 4th Deck } For. Deck
 Three framing ports 1'6" x 1'6" with height of sill 12" hinged shutters } Enclosed Bridge
 (4 P: 45) H" Scuppers ⑤ fitted as in For. Deck } Space to Poop Front BK

H. C. Jones
 Hull, Sept. 1/53