

10/12/18  
17/2/19 (2856)


# STEEL SCREW STEAMER.

N°283-4-5-6 N° 268-290


SCALE  $\frac{1}{4}$ " = ONE FOOT.

DIMENSIONS 141'-6" x 23'-8" x 11'-0" MLD.

TO CLASS 100 A. AT LLOYDS.

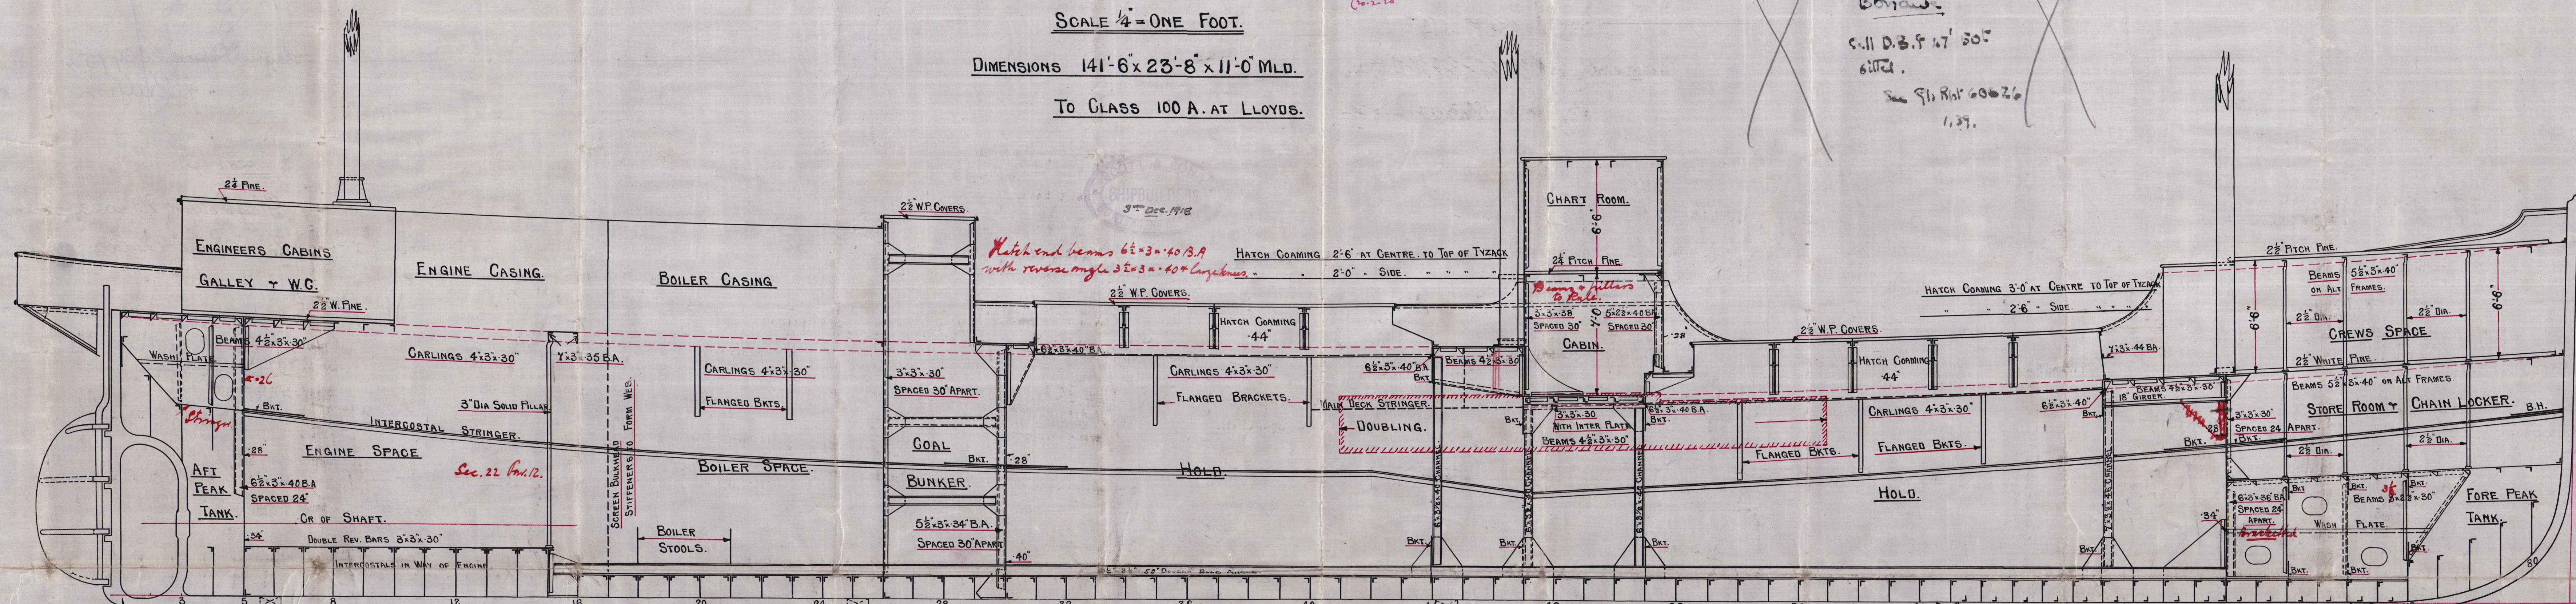

## QUARTER DECK.

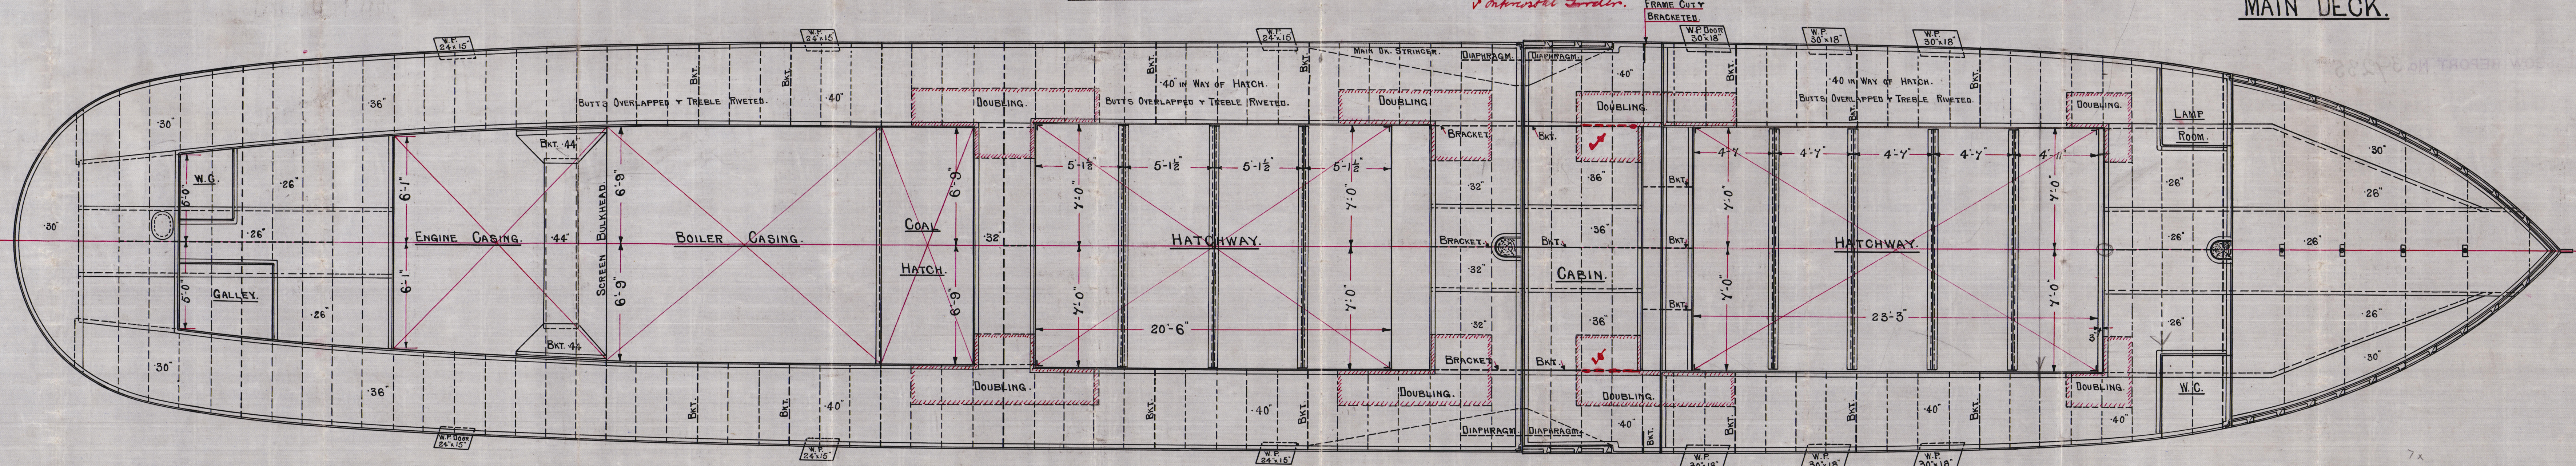

GLASGOW REPORT No. 39235



© 2020

Lloyd's Register  
Foundation

- SCOTT & SONS. -

- PROFILE & DECK PLAN. -

- Nos 283 - 4 - 56

*Kell.*  
4.12.18.

3931<sup>3</sup>5

Saint Barchan

Glasgow Report No. 39452  
5/8 Balfour

No 286

Glasgow Report No 40230

7/8 Saint Aidan

*Pradave*



© 2020

Lloyd's Register  
Foundation

002530 402339 0118