



³⁰ *Musships thickness of two strakes of bottom plating next keel
to be maintained to Rule position of Collar Bld.*

13.5.20

Crabtree Hb.

S S 183

Madhip Section

'Saint Kieran'


183

Saint Kieran

Lloyd's

Glen. Mary
Lon Rpt No 84592

~~183~~

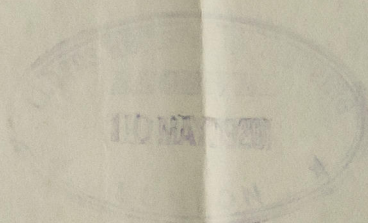

~~183~~

~~183~~



© 2020

Lloyd's Register
Foundation