


MIDSHIP SECTION S. S. No 416.

S.S 360'-0" x 49'-4" x 25'-11 1/2" MLD.

SCALE $\frac{1}{2}$ " INCH = ONE FOOT.

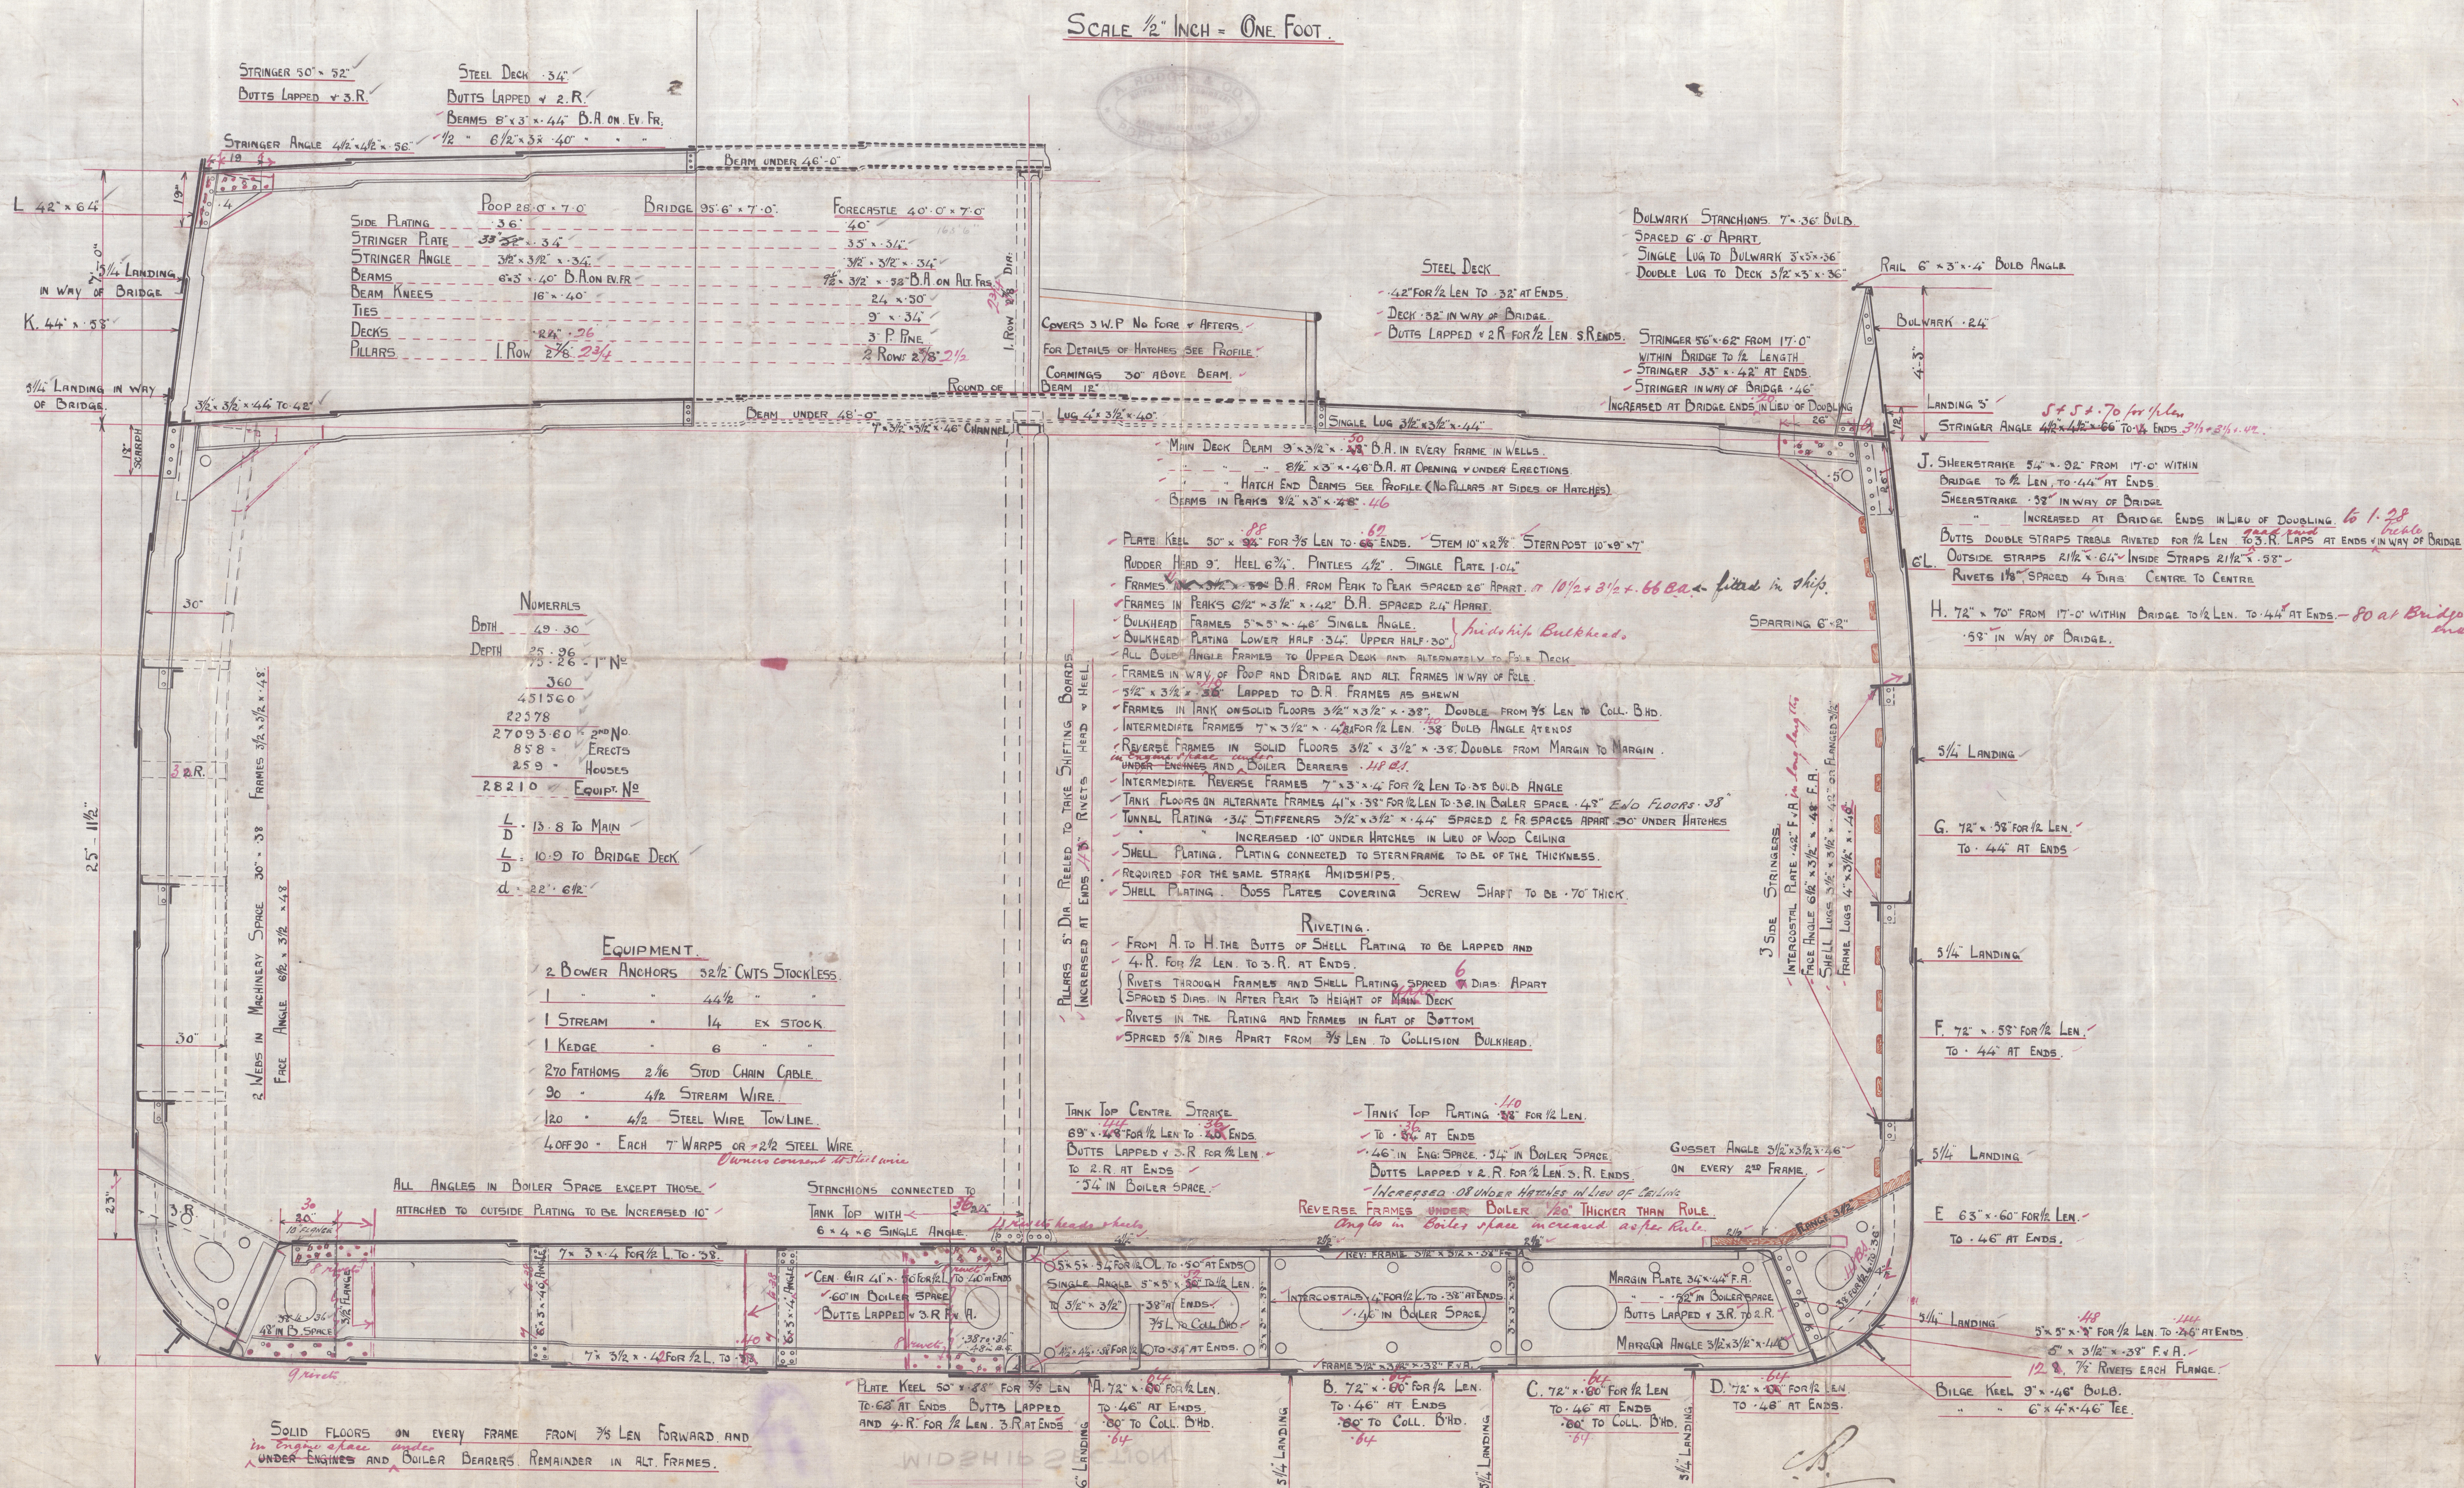

Note: If solid floors fitted to every 3rd frame instead of every 2nd frame
Intermediate Built angle frames are to be 8' 2" 3 1/2" 4' 2 1/2" 4' 0" Built up.

Vertical angles on side girder $S + 3\frac{1}{2} = 40$ to 38 angles.

S.S. 416.

MIDSHIP SECTION.

Meigs A. Rogers & Co.

S. S. Glenisloy
Greenock Report No. 16122

002340-002351-0222



© 2020

Lloyd's Register
Foundation