

Newcastle Freeboard Report 23310


S.S. No 151

SCALE 1/8 INCH TO 1 FOOT.

THU 19 SEP 89  
THU 17 OCT 89  
FRI 18 NOV 89



Spacing of stringers at end  
ground work to correct  
spacing amidship

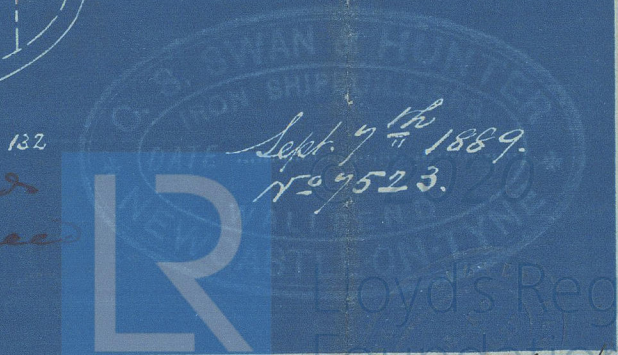

002352-002361-0017



L100-19070

LLOYD'S REGISTER OF  
RECEIVED  
5-DEC. 89  
LONDON



© 2020

Lloyd's Register  
Foundation

002352-002361-0017



S.S. "Arundo"  
Two Entry Report to  
24344  
No 151  
Swan & Hunter

G.B.



Approved profile

SAVONIA  
24 Arundo

Arundo



© 2020

Lloyd's Register  
Foundation

002352-002361-0017