

DR. No. 174
 DATE MAY 9th 1924
 SS. No. 256.
 2/5/24.

SHIP No 256. PROFILE & DECK.

DIMENSIONS 80'0" B.P. x 22'0" MLD x 12'3" MLD

To CLASS LLOYD'S. 100.A.1.


SCALE 1/4" = 1 FOOT

For M.T. Stiffeners actually fitted see Hull Surveyor's letter of 21.1.25 + endorsement

No 5. W.T. BULKHEAD
 PLATING 26" TO RULES W/43132.
 STIFFENERS 6" x 3" x 30" & IN ACCORDANCE
 WITH LENGTHS. SPACED 30" APART.
 WITHOUT BRACKETS OR LUGS.


W.T. BULKHEAD No 32
 PLATING 26" & TO RULES 4813132.
 STIFFENERS 6" x 3" x 30" & IN ACCORDANCE
 WITH LENGTHS. 30" APART.
 WITHOUT BRACKETS OR LUGS.

W.T. BULKHEAD No 42
 PLATING 26" & TO RULES 4813132 as per Table 29.
 STIFFENERS 6" x 3" x 30" & IN ACCORDANCE WITH LENGTH.
 BRACKETED AT TOP & BOTTOM when practicable
 SPACED 24" APART.

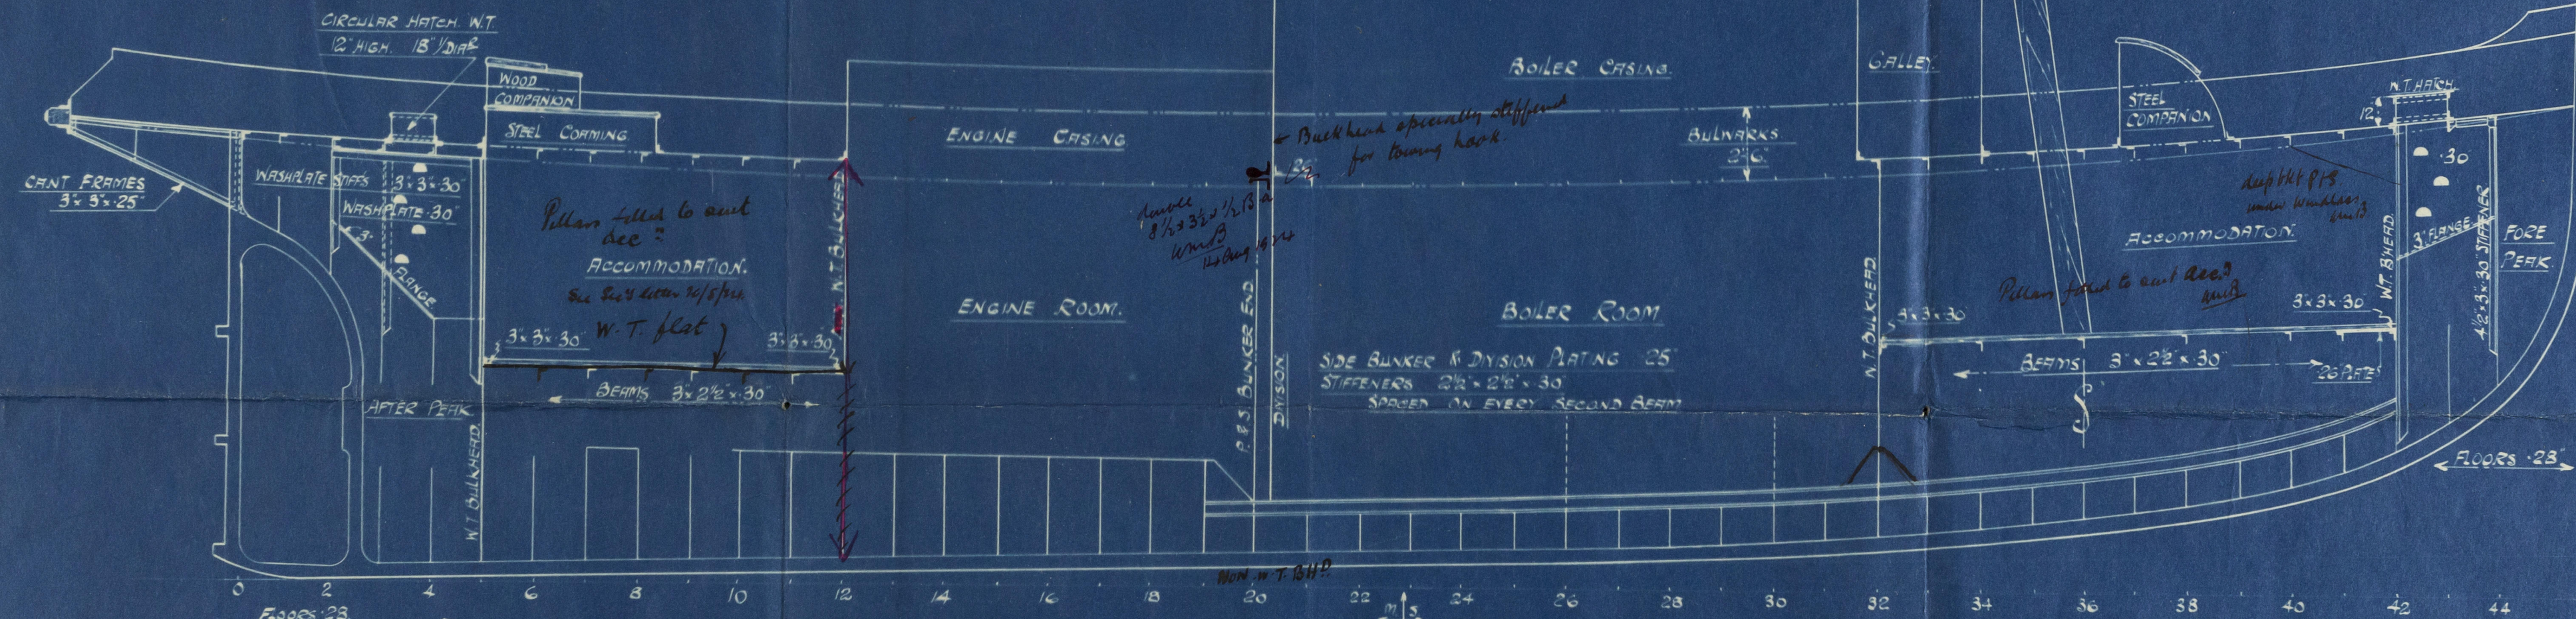

FRAMES SPACED 21" THROUGHOUT.

PILLARS THROUGHOUT TO SURVEYORS SATISFACTION.

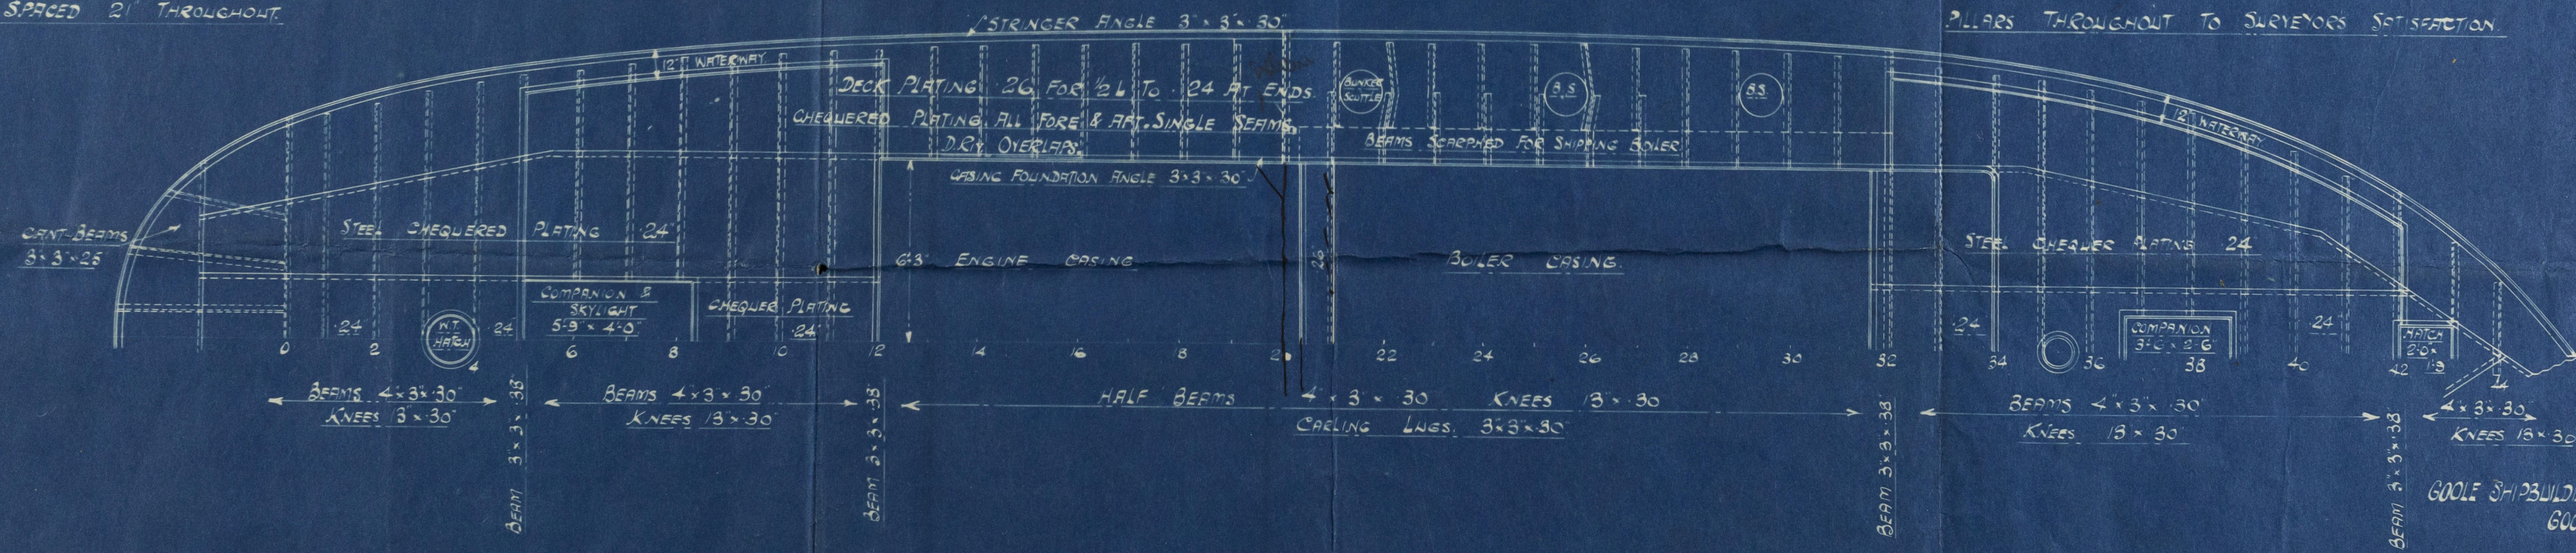

GOOLE SHIPBUILDING & REPAIRING CO. LTD.
 GOOLE,
 ENGLAND.



D02852-102301-0178

Lloyd's
Profile on Deck plan
For Yacht S.D. off. Boats

No. 256.

ABEILLE N° 19.
Hull Rpt No 35778
Approved and as fitted.



© 2020

Lloyd's Register
Foundation

002352-002361-0178