

16.7.12
22.7.12
28.8.12
21.9.12
2.10.12
11.10.12
12.11.12
18.2.13
24.2.13
1.3.13



LONGITUDINAL SECTION

N^{os} 529 & 30

SCALE 1/4" = 1 FOOT

1ST N^o. A.A.5

2ND N^o. 8677.5

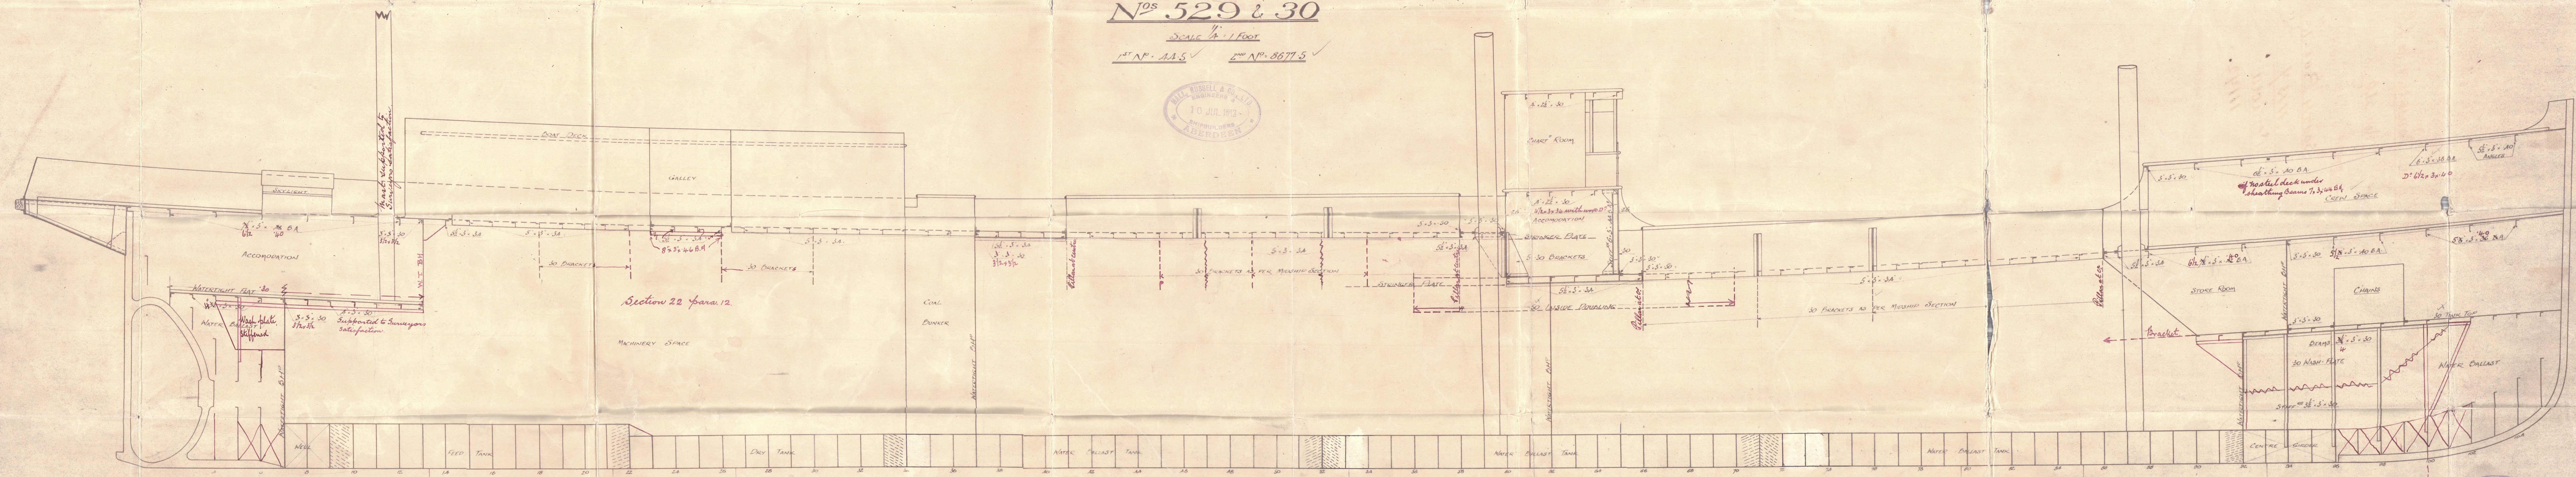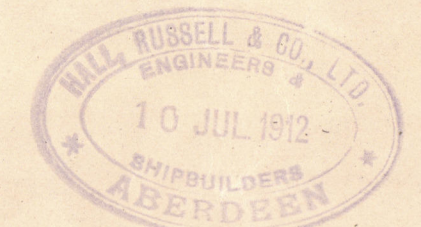

Pillaring throughout to Surveyors satisfaction.



Aberdeen

Hall Russell & Co. L^d

Nos. 529-30






- Longitudinal section -

529
S.S. "SOUTH BULLI."

Abn. Rpt. No. 11134

530
S.S. "Uronioka"

Abn. Rpt. No. 11142

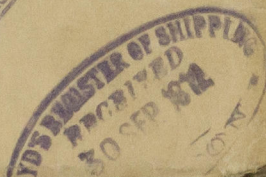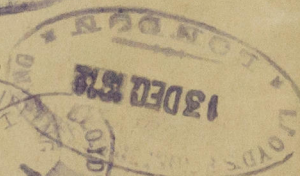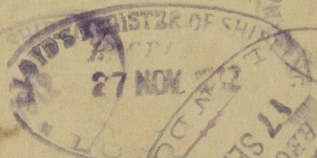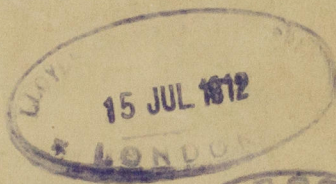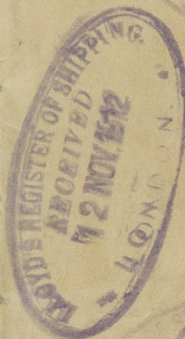

001362-001373-00137



© 2020

Lloyd's Register
Foundation