


Rule E, Tam. = 1640 (grade) lakes.

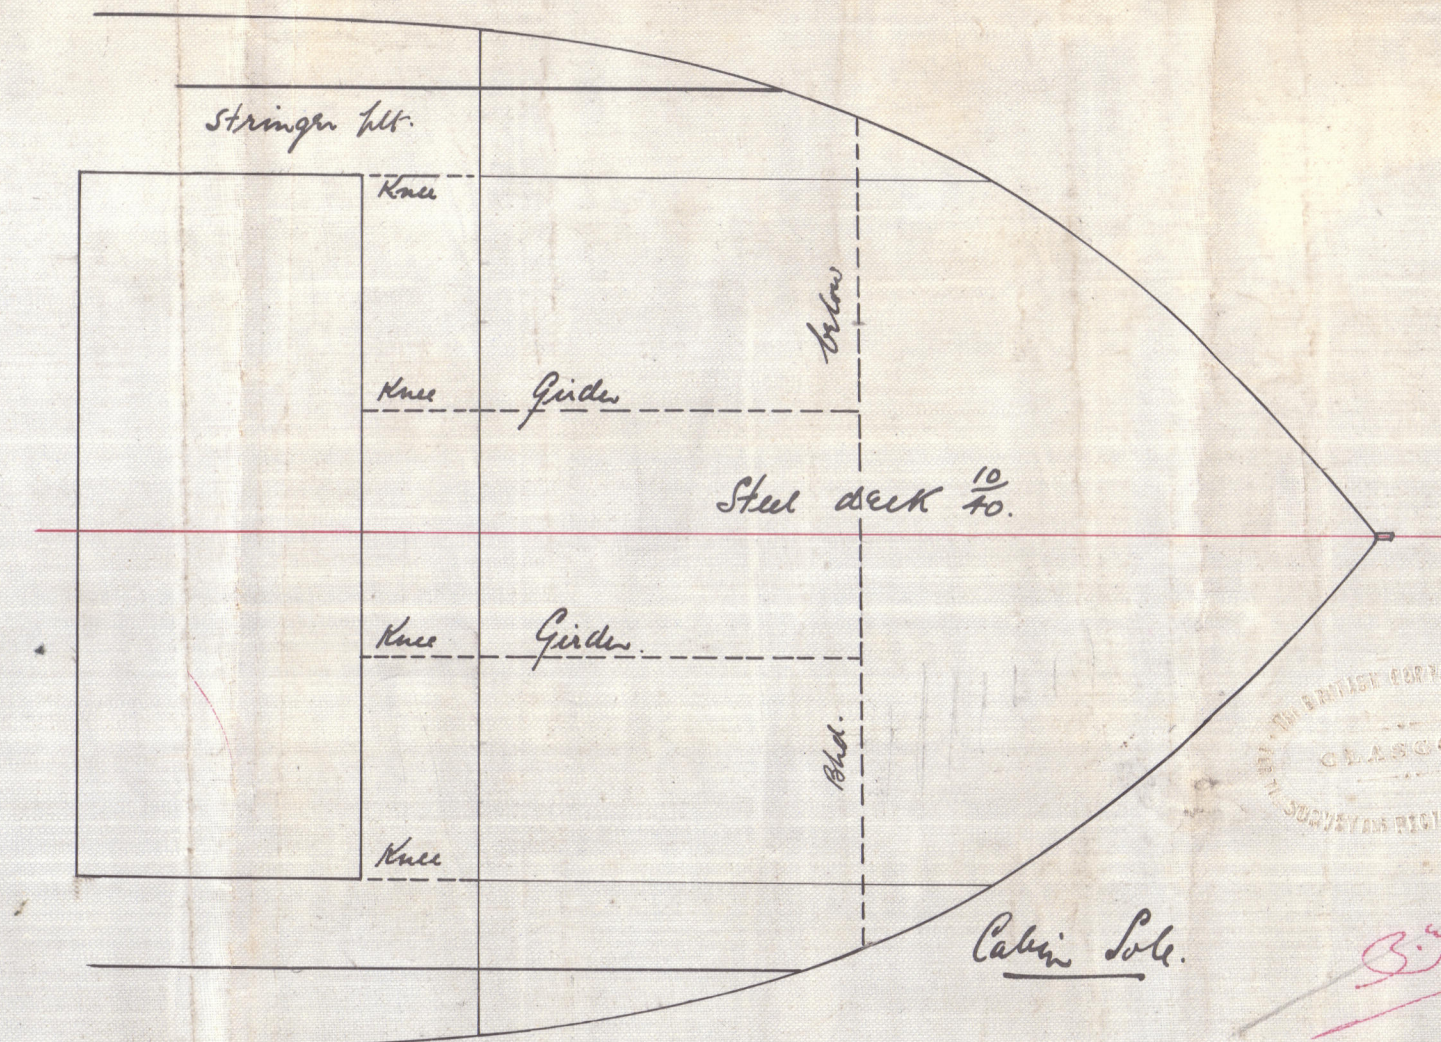


To Class B. S. *.
In service on the Great Lakes and the St. Lawrence Riv.

LAKE STEAMER—ARCH PRINCIPLE OF CONSTRUCTION.

— PATENT. —

250'-0" x 42'-6" EXT. x 16'-0" + 4'-0 ARCH.

SCALE $\frac{1}{8}'' = 1 \text{ FOOT.}$

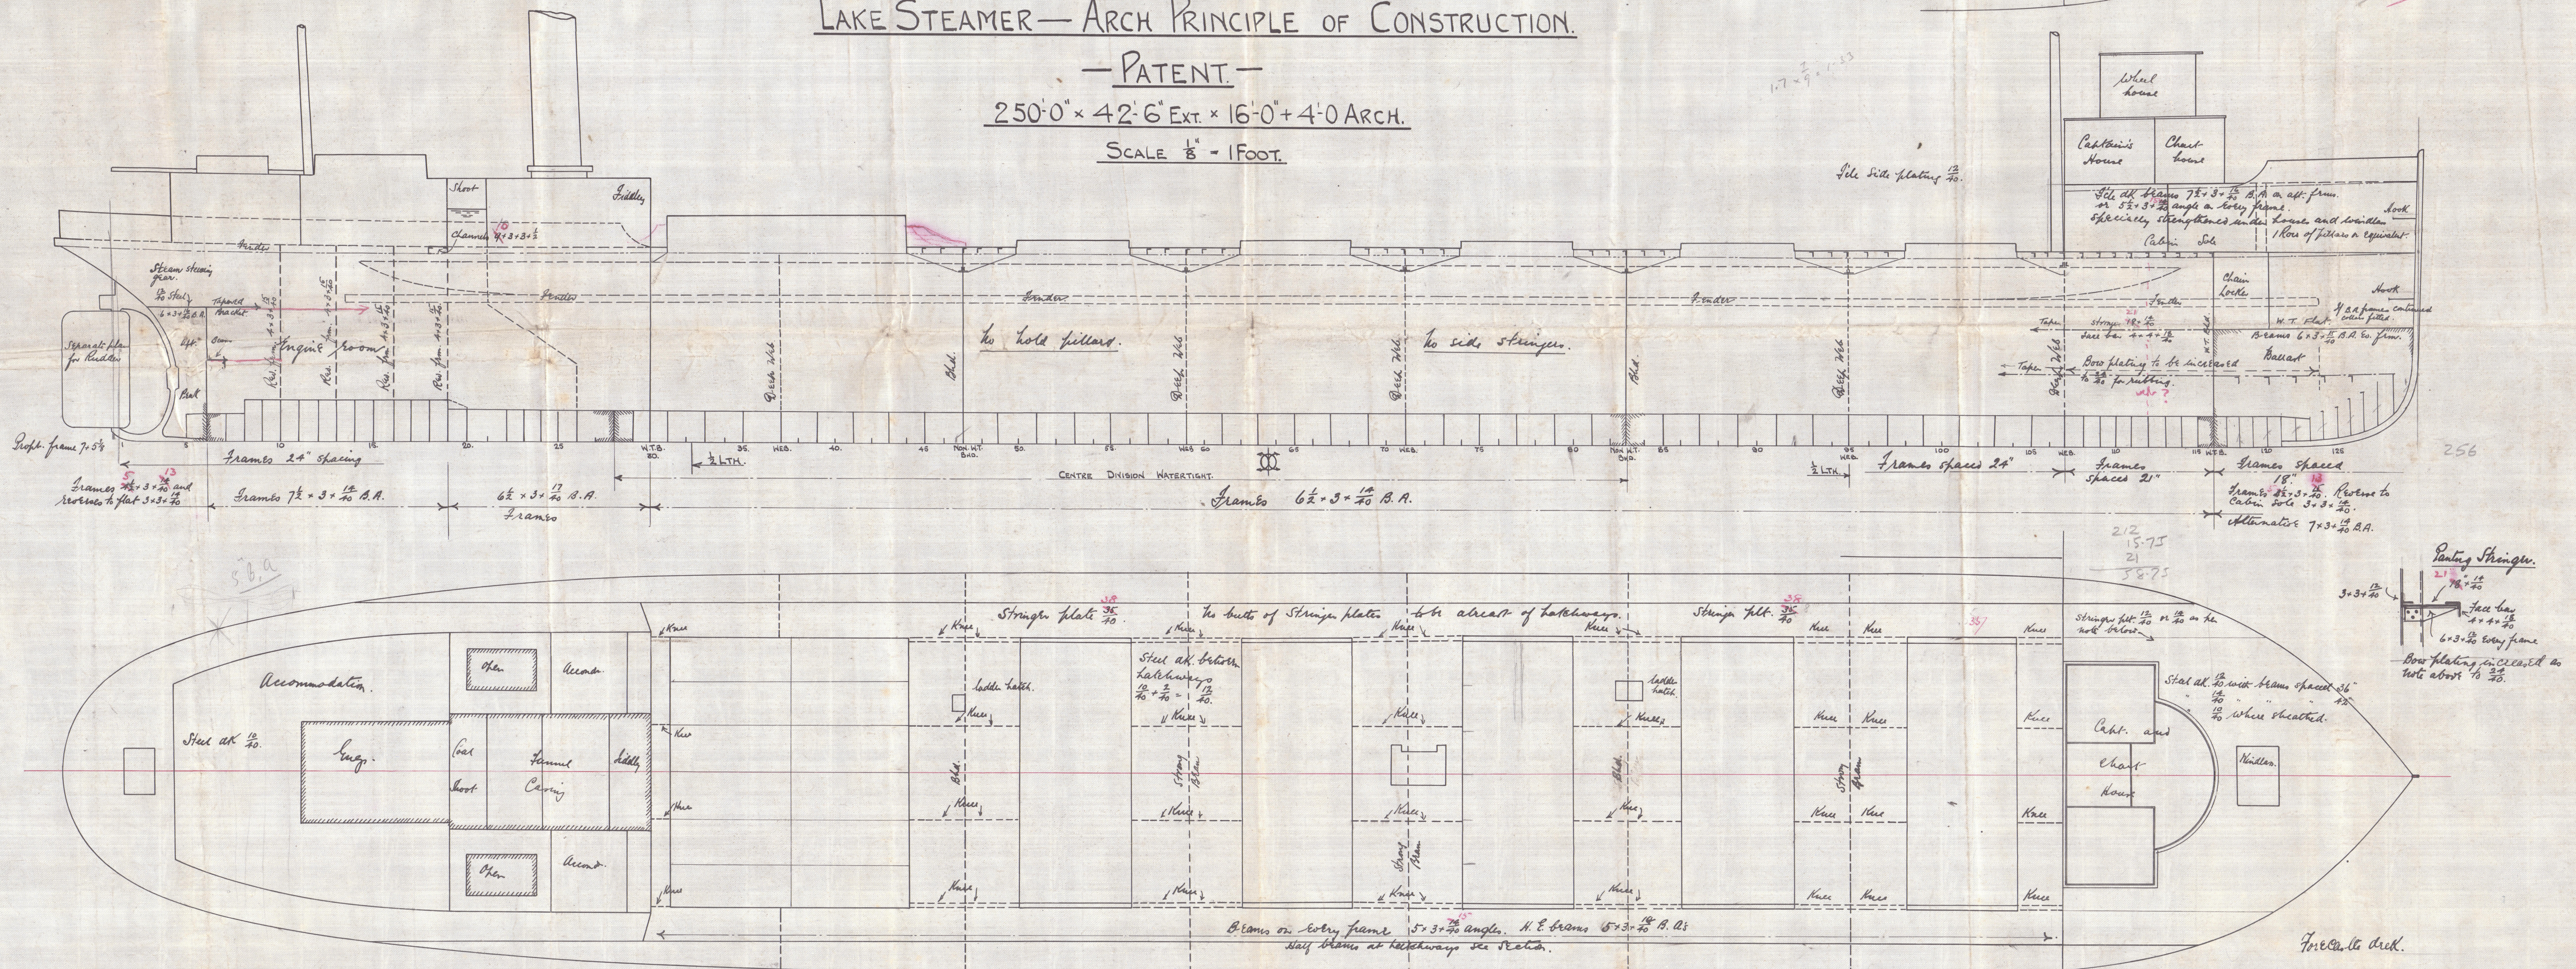

Saran Hunter's

Lake Steamer Arch.
Principal Construction

250' x 42'-6" x 16'-0"

Profile 2/8/12

Now North of Ireland 55-56

T.C. 28-8-12.

$\frac{8}{12}$ Glenmave's

$\frac{8}{12}$ Glenfoyle

See later plan



© 2020

Lloyd's Register
Foundation

002362 005373-0053