

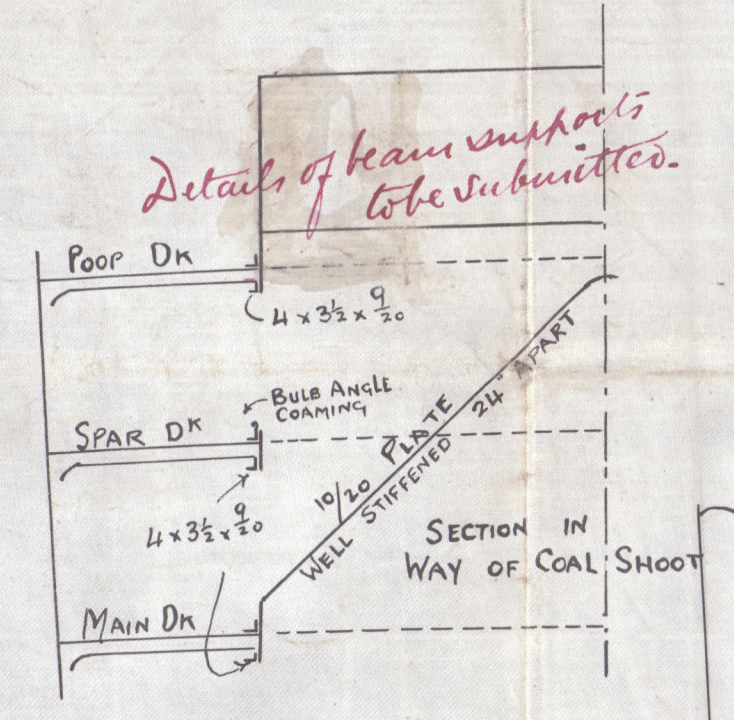
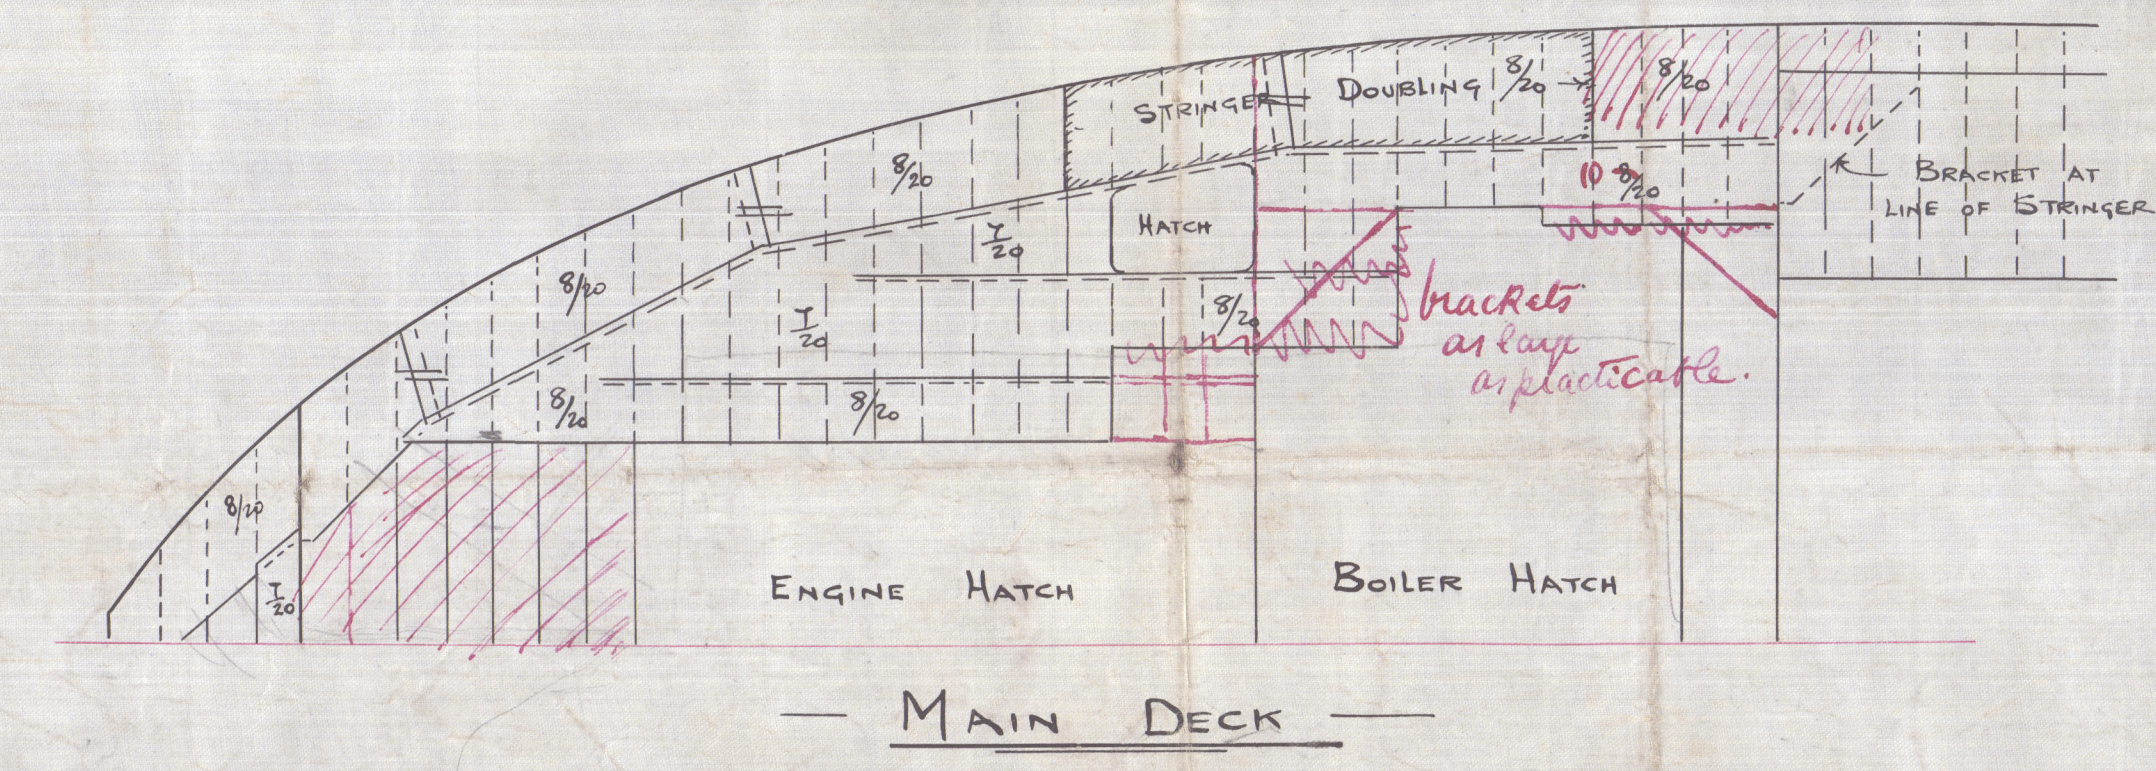


24.1.06
 14.5.06
 9.5.06
 12.6.06
 11.7.06
 8.8.06
 11.9.06
 18.9.06
 21.9.06
 30.1.07

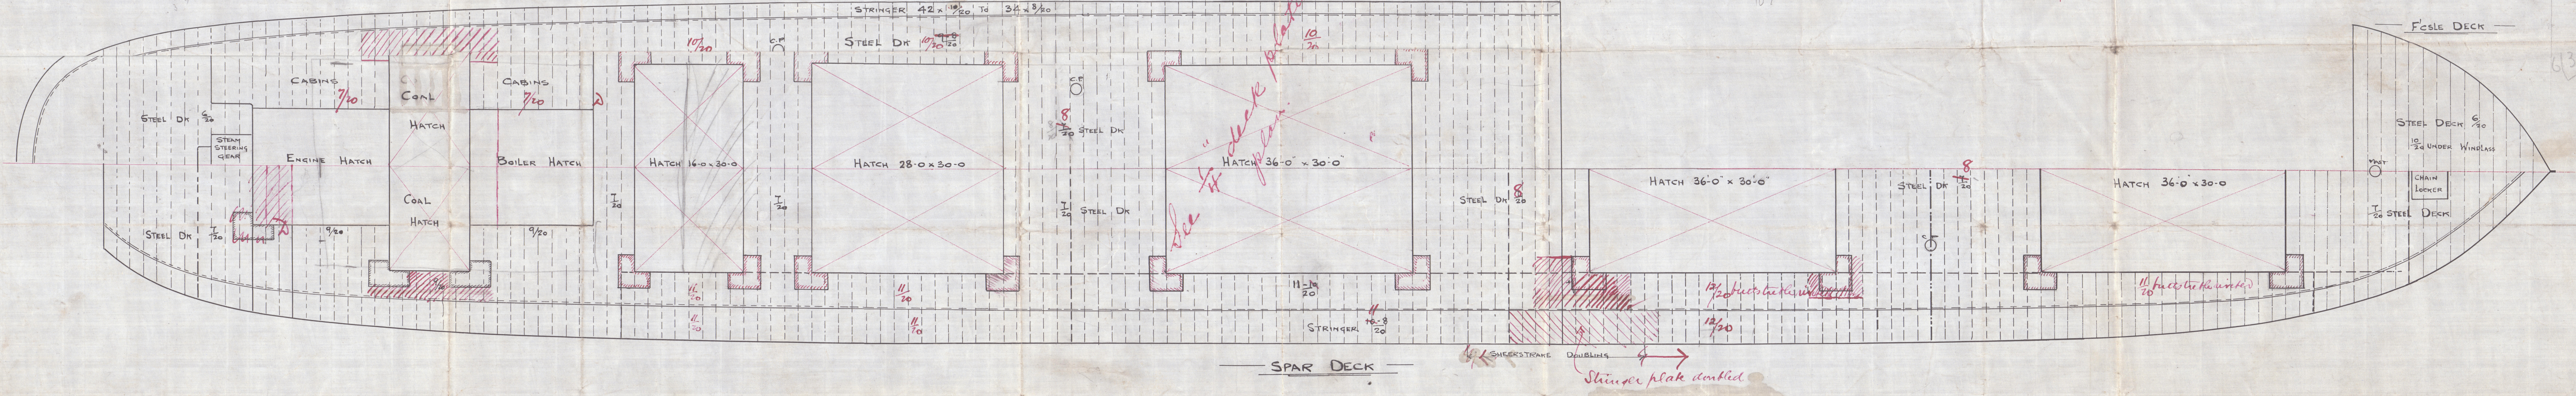


PROFILE & DECK PLANS
 No 525 SHIP
 SCALE 1/8" = 1 FOOT
 DIMENSIONS 360'-0" x 51'-9" x 26'-4" MLD
 CLASS 100A1, LLOYD'S SPAR DECK RULE
 HARROWAY & DIXON'S PATENT

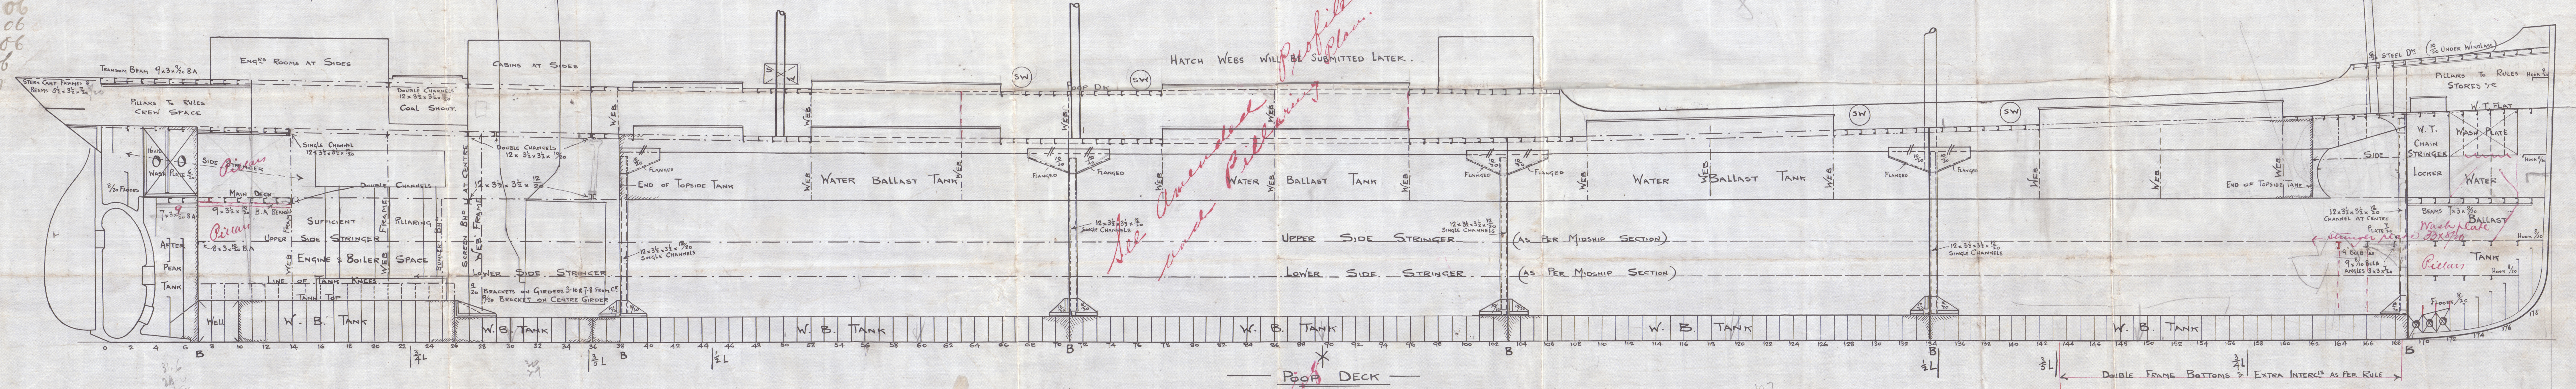

CB.
 29.1.06

19-1-06

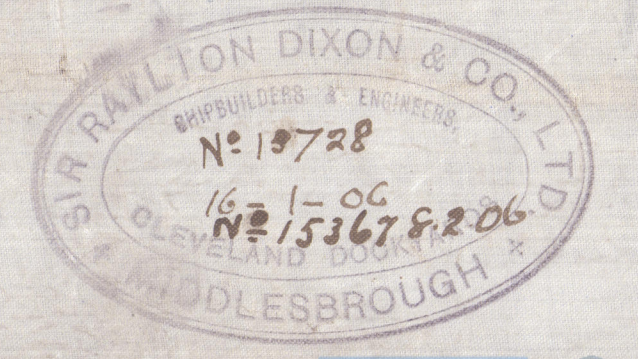

Sir Raylton Dixon & Co
G.S. No 525

Amended Profile

— G. Sygna

Nat Report No 4944

~~1244~~

DIS Sect 107



© 2020

Lloyd's Register
Foundation