



31. 8. 98
24. 1. 99

NUMERALS

2 BREADTH — 4'-6"
DEPTH — 13'-1 1/2"
2 GIRTH — 25'-8 1/2"
FL — 5'-2" = 57.7
PL — 7' x 5 1/2" = 263
LENGTH = 583 LENGTH = 1225
BREADTH DEPTH

PROFILE AND DECK PLAN OF SS NE 370

Scale 1/8" = 1 Foot


TO BE CLASSED LIGHTS + 100 A 1

DIMENSIONS

LENGTH — 171'-0"
BREADTH — 29'-0"
DEPTH — 13'-1 1/2"

RETAIN




LINDHOLMENS VERKSTADS AKTIEBOLAG, 24. 8. 1898.

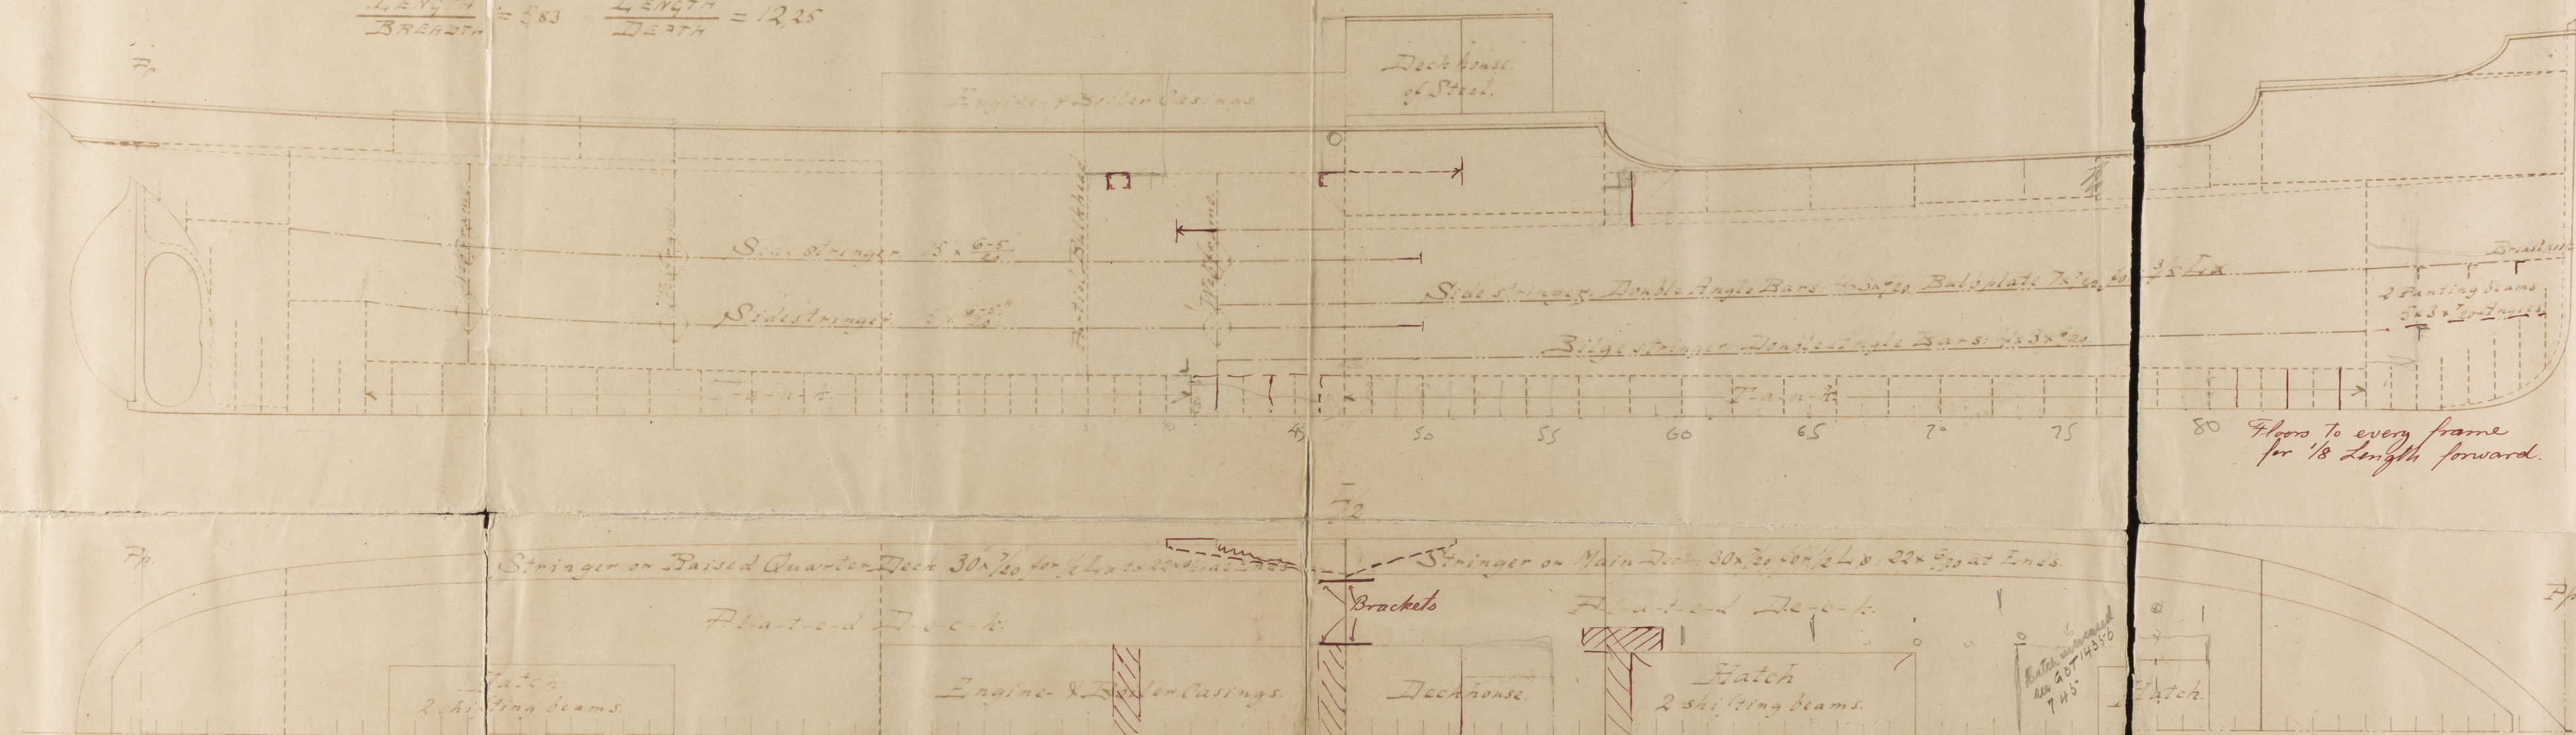

80 Floors to every frame for 18 length forward.

18/6
31/8/98

W/W 'Newburn.'
S.S. 'Erik' R & I
Est. 581^a

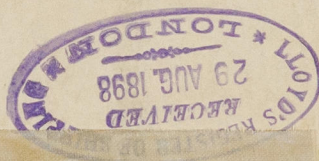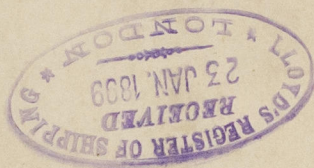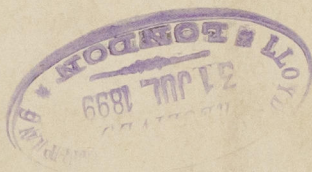

© 2020

Lloyd's Register
Foundation