

3 JAN 1950

Rpt. C. 11 (Contd.)


Index No. 29989

Lloyd's Register of Shipping.

Ship's Name "KAJSA CHRISTENSEN"

Official No. 3529

Memorandum of alterations reported since ship was surveyed for assignment of Load Lines in Stockholm, 1932.

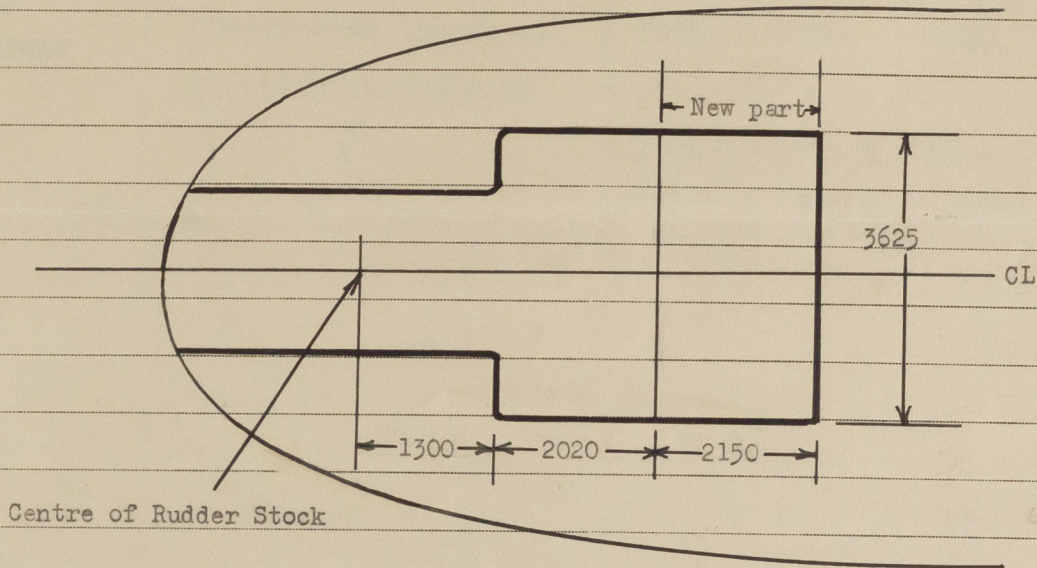

Centre of Rudder Stock

ALTERED POOP DECKHOUSE.

Deckhouse length forward of rudder stock	=	5470 mm.	=	17.94'
Deckhouse breadth	=	3625 mm.	=	11.89'
Deckhouse height	=	2115 mm.	=	6.93'

Bertil Lysen

GOTHENBURG.
31. 12. 1949.

G.H.W.
7 JAN 1950