

MIDSHIP SECTION OF TWIN SCREW STEAMER.

DIMENSIONS 230-0" BP. x 37-0" x 10-6" MLD


CLASS BS*

(COASTING.)

SCALE 1/2" = 1 FT.



10 SEP 1919

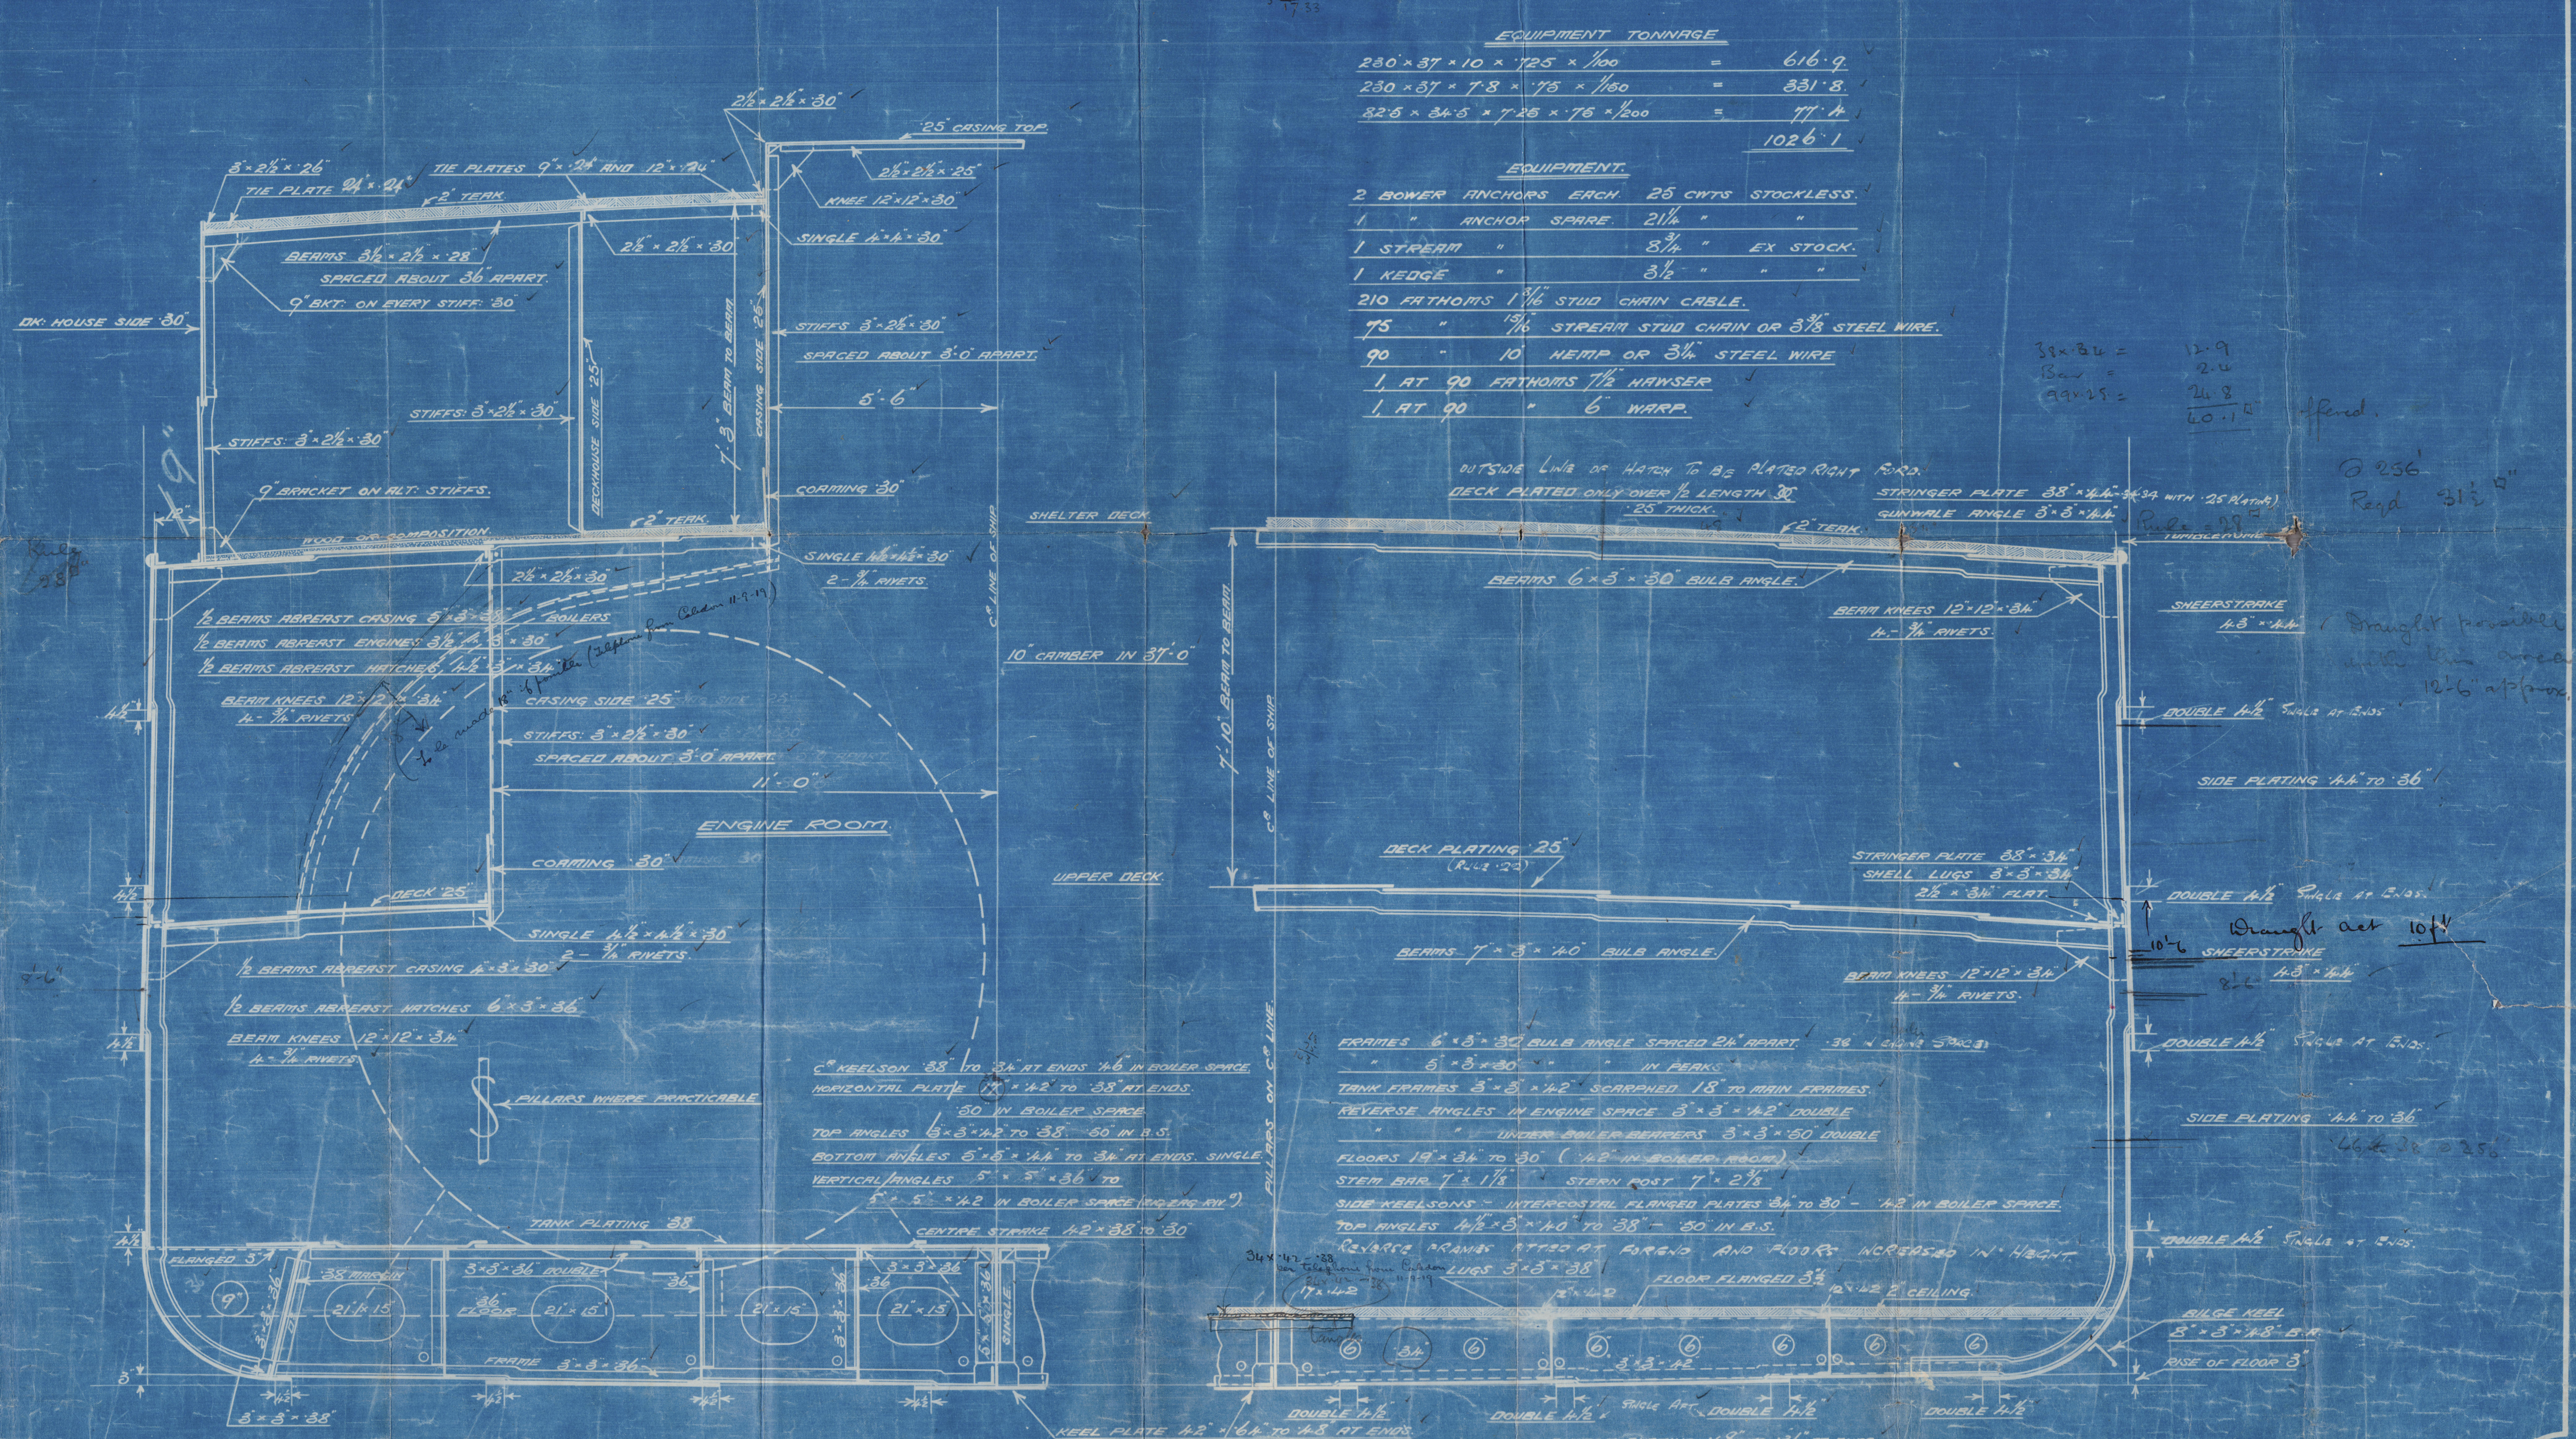

5

Caledon's 264

Amended Midship
Section

230' x 37' x 10' 6"

RETAINED
Bag

SS

KELANTAN

W.S. 592

Caledon S & E boy L^d

264

Amend Midship Section

230' x 37' x 10' 6"

© 2020



~~8~~ 5

Lloyd's Register
Foundation

002374-002384-0022