





DELETE WORDS WHICH DO NOT APPLY.

The Crew *are, are not*, berthed in the Bridge house.

The arrangements to enable them to get backwards and forwards from their quarters *are, are not*, satisfactory.

Length of Bulwarks in well

Area of Freeing Ports required by Para. 11 (e) each side of vessel				=	Sq. ft.
Ft.	Tenths.	Ft.	Tenths.	No.	Freeing Ports each side of vessel
×		×		×	
×		×		×	
Total excess deficiency					= Sq. ft.

If the sill of the lowest side scuttle would be less than 6 inches above the Indian Summer Load Line if assigned under the tables, state vertical distance from top of deck at side amidships to lower edge of lowest side scuttle.

Do all the Frames extend to the top height in the Poop?

Do.	do.	do.	Raised Quarter Deck?
Do.	do.	do.	Bridge House?
Do.	do.	do.	Forecastle?

*Gherwood long system of construction*

To what height do the Reverse Frames extend?

Has the Poop ~~or Raised Quarter Deck~~ an efficient Iron Bulkhead at the fore end?

How are the openings closed?

Is the Poop ~~or Raised Quarter Deck~~ connected with the Bridge House?

Are the Engine and Boiler openings covered by a ~~Bridge~~, Poop, ~~Raised Quarter Deck~~, & enclosed by a Strong Iron or Steel Deckhouse?

If the openings are not so protected, are the exposed parts of the Casings efficiently constructed?

What is their height?

Are suitable means provided for closing all openings in exposed Casings in bad weather?

Has the Bridge House an efficient Bulkhead at the fore end?

How are the openings closed?

Give thickness of Bridge Front plating  $\frac{1}{4}$  Coaming plate  $2\frac{1}{2} \times 4\frac{1}{2}$  Stiffeners  $1\frac{1}{2} \times 3\frac{1}{2} \times 6$  spaced 30" bracketted top & bottom

Has the Bridge House an efficient Iron Bulkhead at the after end?

How are the openings closed?

Is the Forecastle at least as high as the main or top-gallant rail?

Has the Forecastle an efficient Iron ~~or Wood~~ Bulkhead at its after end?

Are the Weather Deck Hatchways efficiently constructed and at least equal to the Rule requirements?

What is the thickness of the Hatches?


$3''$

State the height of the Coamings in Fore Well  $2\frac{1}{2}'$

In After Well

State any special features in the construction of the Vessel


*Bulk oil carrier, constructed on Gherwood long system.*

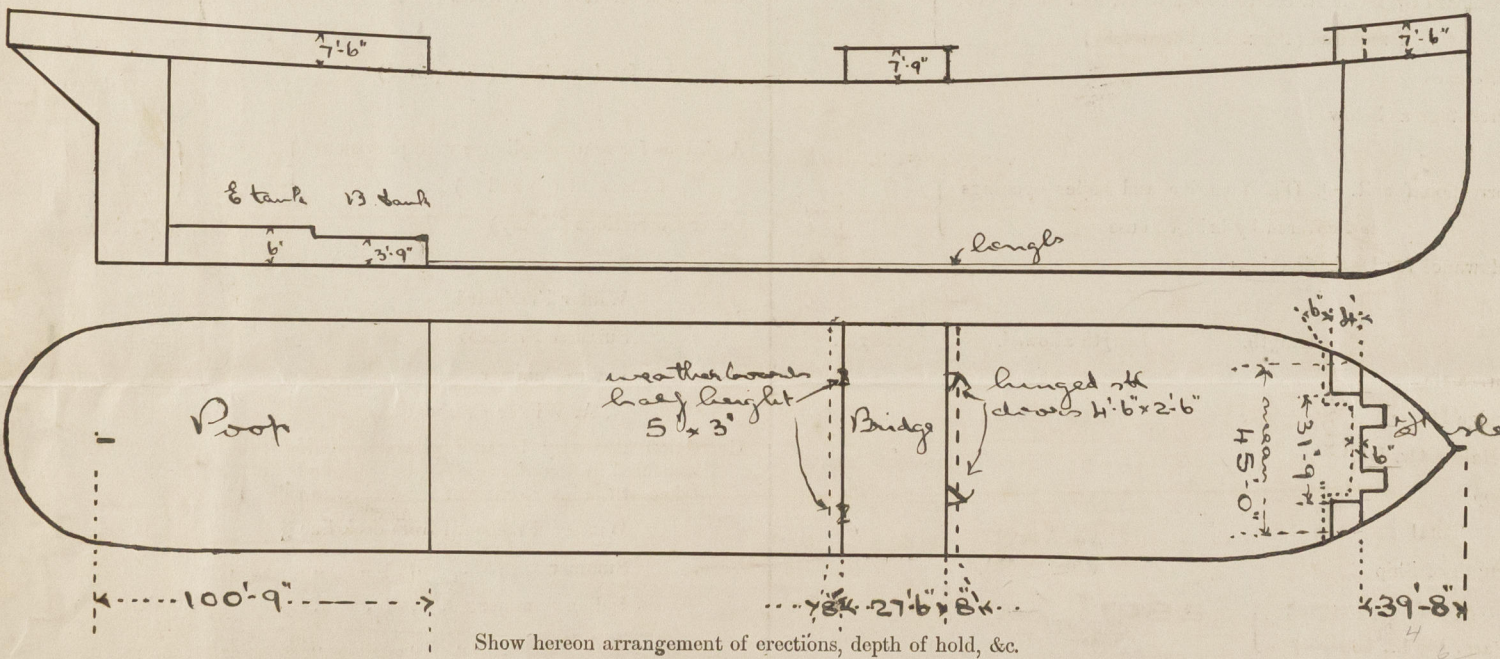

The Freeboards, as stated on the other side, being in accordance with the Tables, it is submitted that the same be assigned.

Chief Surveyor.

Passed at a meeting of the Committee of Management of the British Corporation for the Survey and Registry of Shipping on the

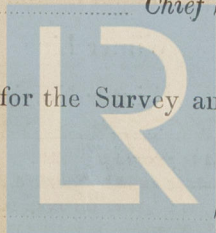

© 2020

Lloyd's Register Foundation