
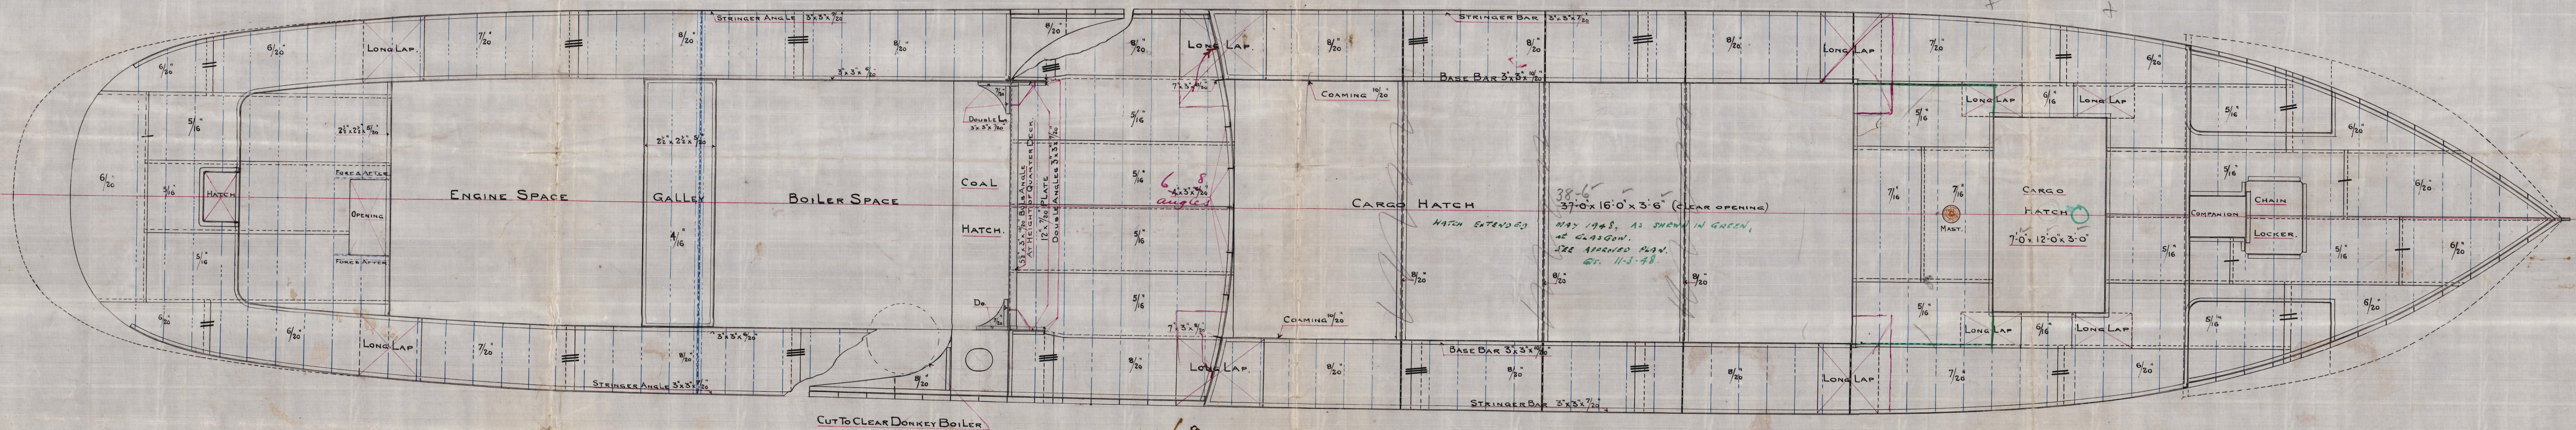


18-3-03
1934

S.S. N° 120.
SCALE 1/4" = 1 FOOT.

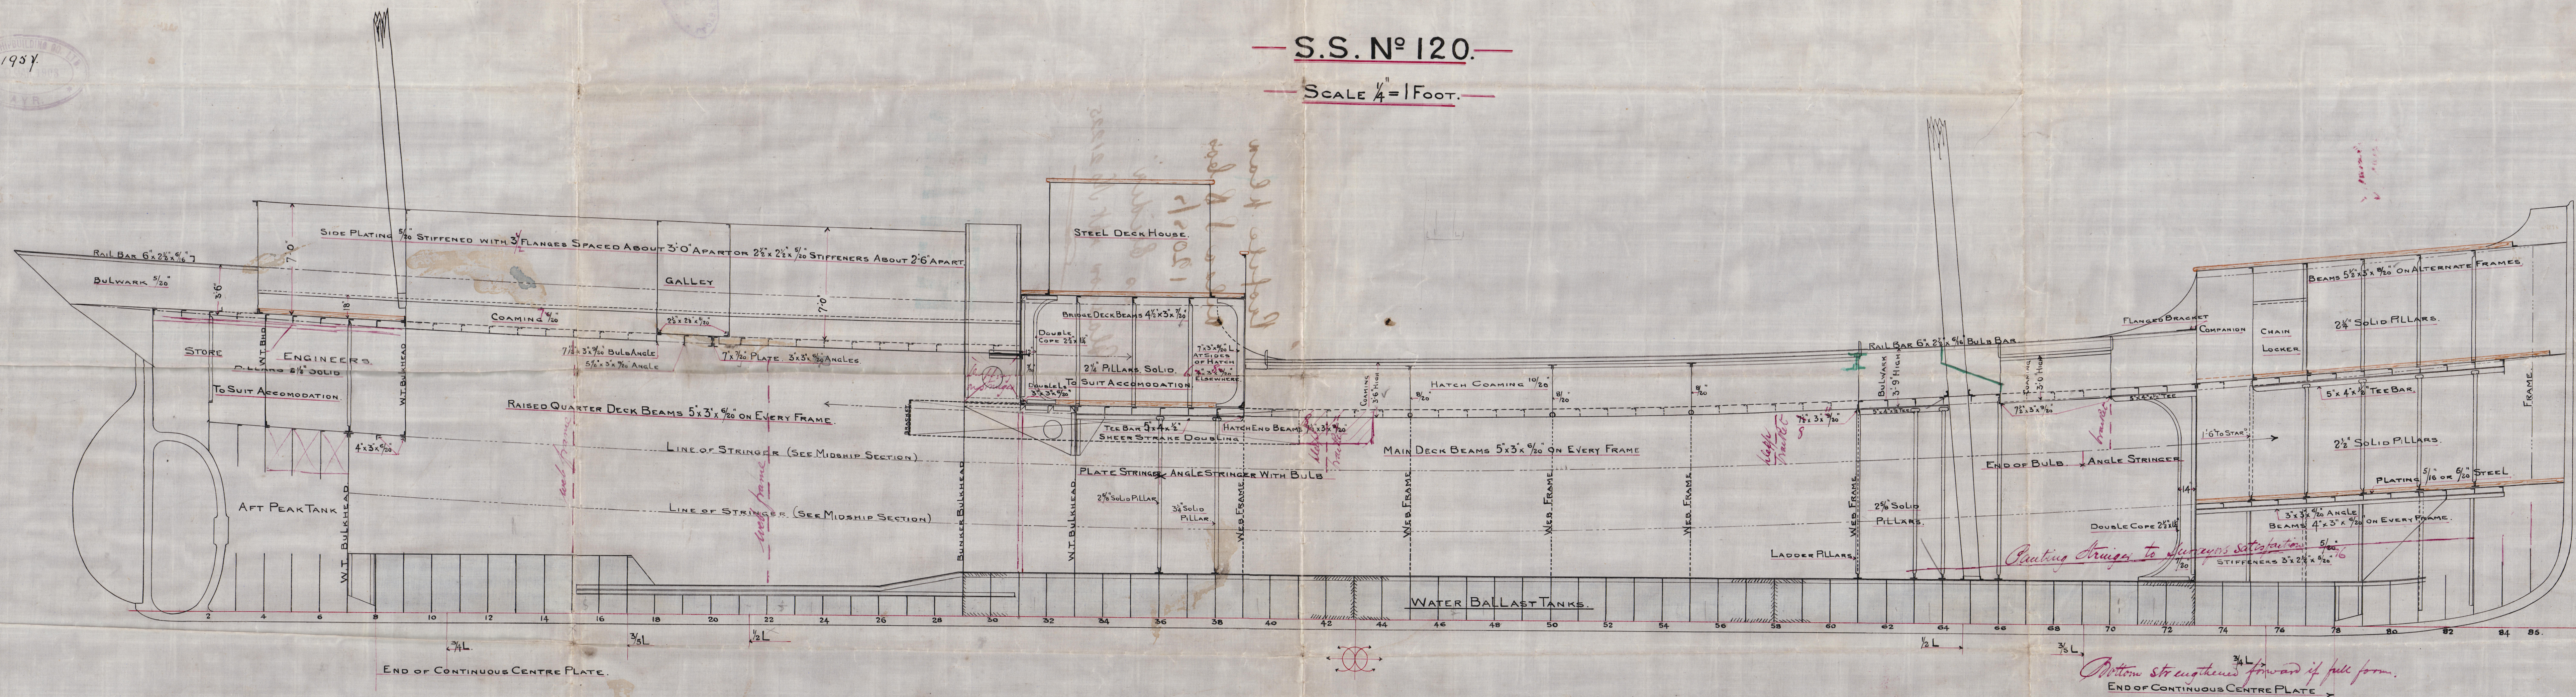

21/11/1934

C.B.
18.3.03

Profile plan

also S S box

120.5/s

so sliding

Glasgow apt No 21225



002374-002384-0150



© 2020

Lloyd's Register
Foundation

002374-002384-0150