

Rpt. C. 11 (Contd.)

Index No.


Lloyd's Register of Shipping.

15 MAY 1948

Ship's Name *ELIDIR.*

Official No. 118502.

Memorandum of alterations reported since ship was surveyed for assignment of Load Lines
in _____

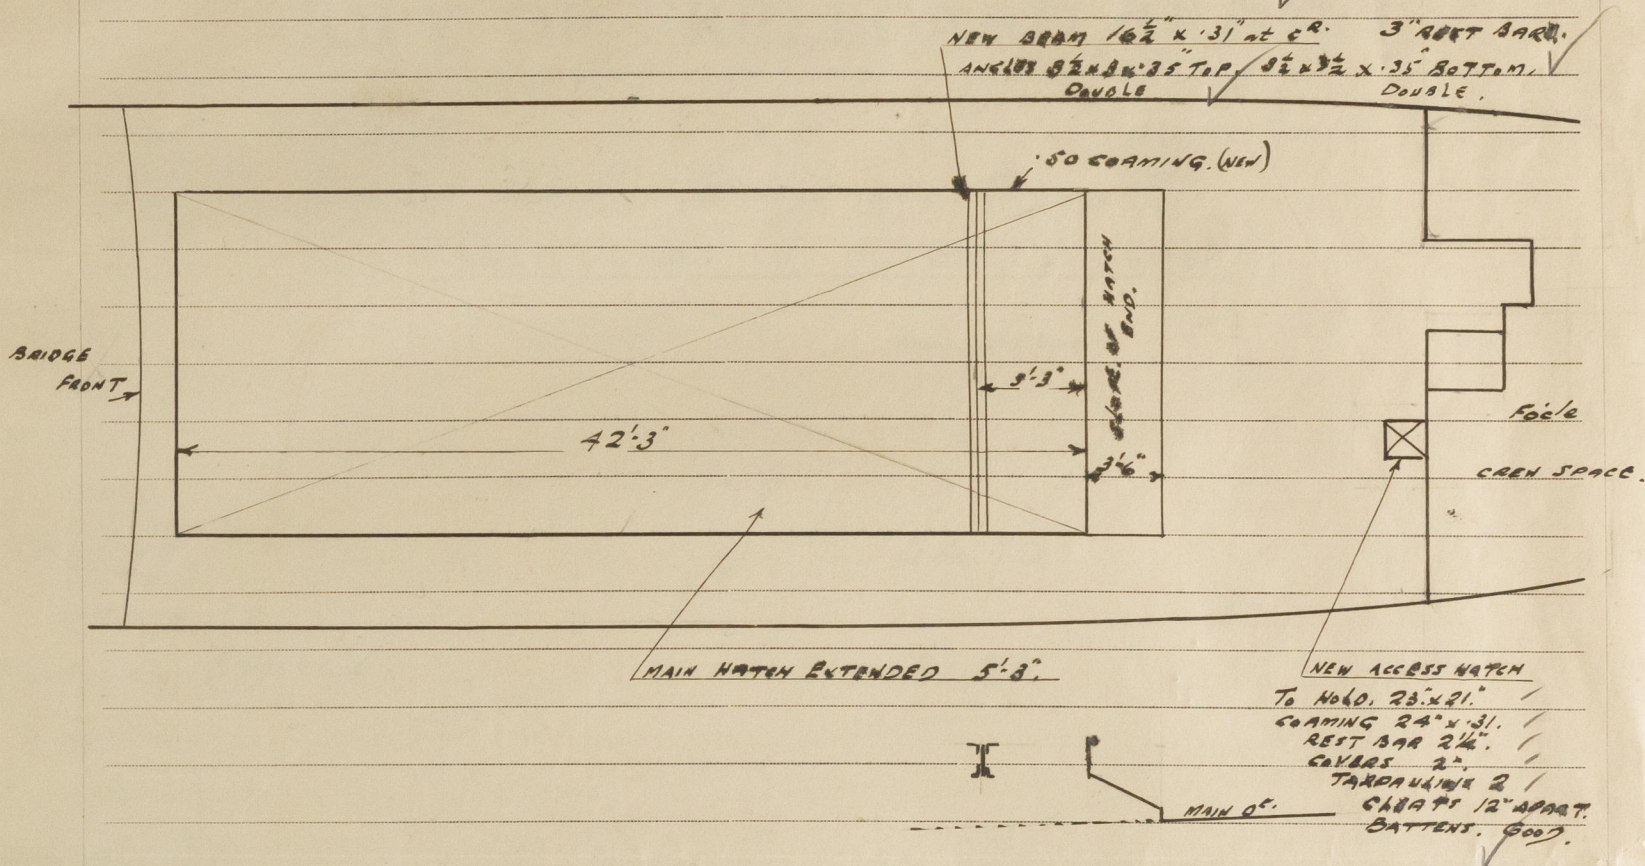

as. my. p. cit. l. r.
 14/5/48.

Nat'l
An.
18.5.48