


17.10.12  
8.1.13  
15.1.13  
25.1.13

# PROFILE & DECK PLAN.


S.S. No 82

LENGTH BP 192'6" BREADTH MLD 30'6" DEPTH MLD 14'9"

SCALE 1/8" = 1 FOOT.

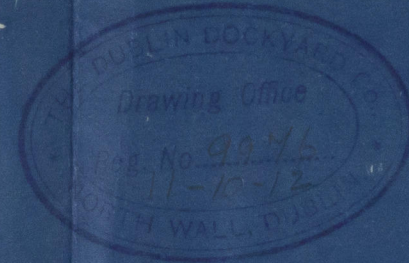

Approx. PARTICULARS FOR FREE-BOARD  
REGISTERED DIMENSIONS 192'6" x 30'6" x 14'9"  
UNDER DECK TONNAGE APPROX. 5 1/2 TONS  
SKEER AT STEW 6'3" 1/8" FROM STEW 3'6 1/2"  
SKEER AT STEW 3'6" 1/8" FROM STEW 1'11 1/2"  
BRIDGE COMPLETELY CLOSED, FORECASTLE OPEN.

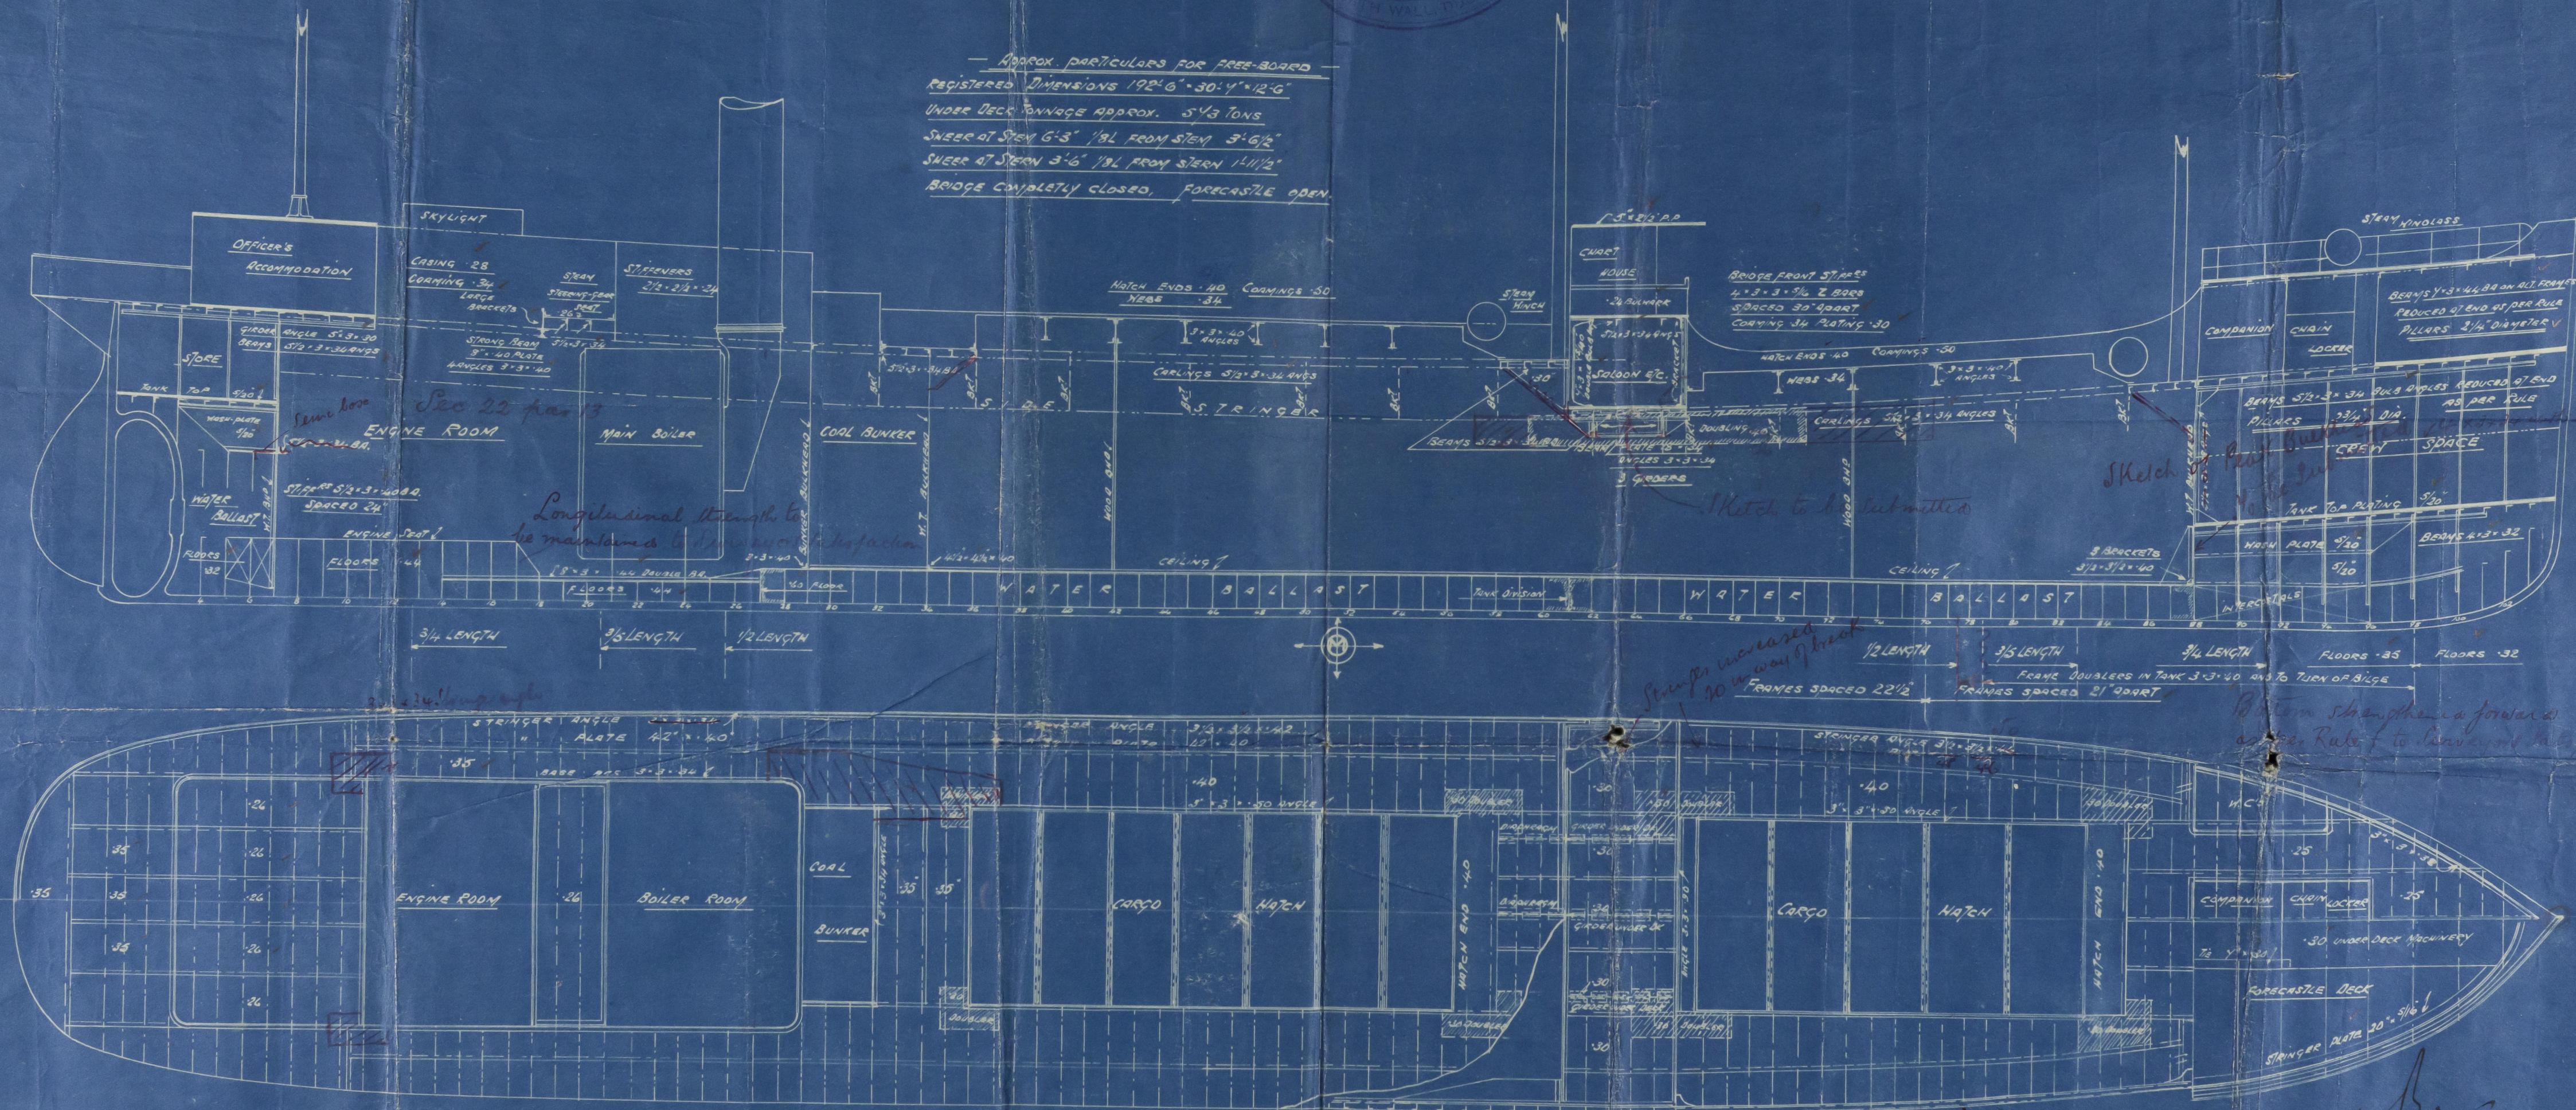

Longitudinal strength to be maintained by means of keelsons.

Sketch to be submitted

Sketch of Port Bunkers

Bottom strength as forward as per Rule 1 to Convention

C.B.  
17.10.12.







Profile & Deck  
Dublin Dockyard Co

82.

S.S. Patricia

Dub. 3200

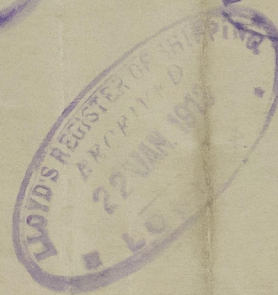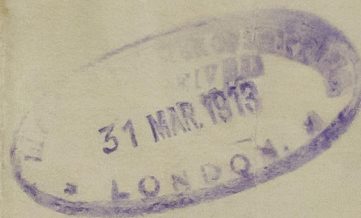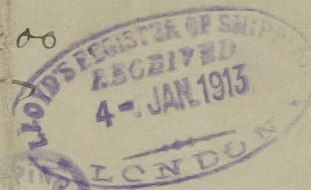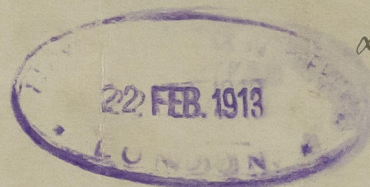

Dub  
12/10/12  
Mr

RETAIN



002385-002400- 0038



© 2020

Lloyd's Register  
Foundation



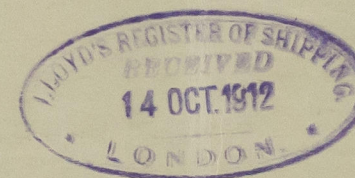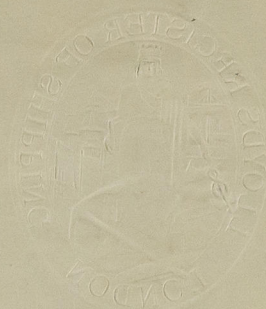

9



© 2020

Lloyd's Register  
Foundation

002385-002400-0038