

Abn. Rpt. 21357

## Lloyd's Register of Shipping.

Ship's Name "EILIAN HILL"


Official No. 132894

Memorandum of alterations reported since ship was surveyed for assignment of Load Lines in ABERDEEN.

Forecastle front starboard side, now closed with 2" wood door 3 frame spaces forward of forepeak bulkhead. Portside has been closed at sometime previously from the 6th frame space forward of Forepeak bulkhead, and is also closed with 2" wood doors fitted with locks operated from both sides. Sills below doors 11" high. Chain lockers removed to below Freeboard deck, remainder of space used for stores. Space on Freeboard Deck, now fitted out and used for crew accommodation.

Copy of this alteration has been placed on board the vessel.

E. E. Evanshaw

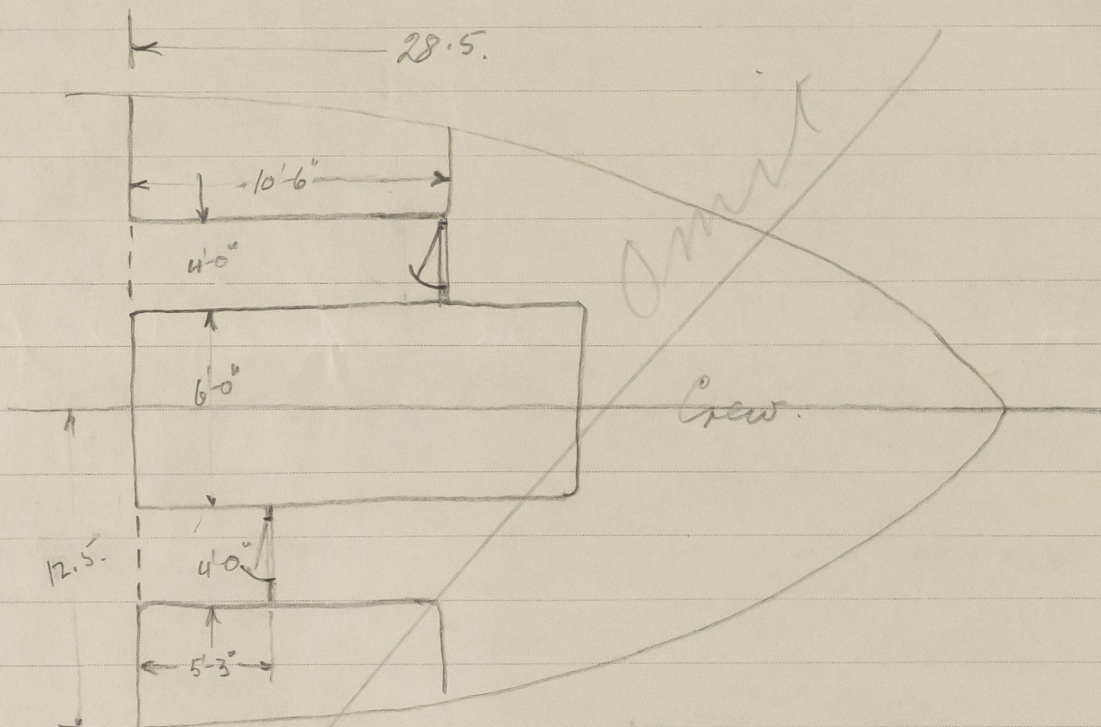

Above sketch compiled from information given above in conjunction with approved plan.

E.E.

18.5.44.