

Lloyd's Register of Shipping.


Ship's Name "FAIRFIELD". Official No. _____

Memorandum of alterations reported since ship was surveyed for assignment of Load Lines in _____

ALTERATIONS:


Breadth of No.1 Hatch on Freeboard Deck altered from 15'-0" wide to 20'-0".

Hatch beams fitted now.

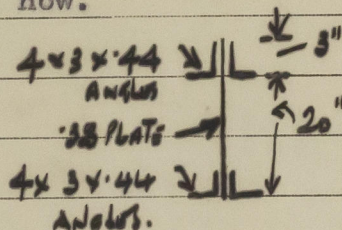

Breadth of No.2 Hatch on R.Q. Deck altered from 16'-0" wide to 22'-0".

Hatch beams fitted now.

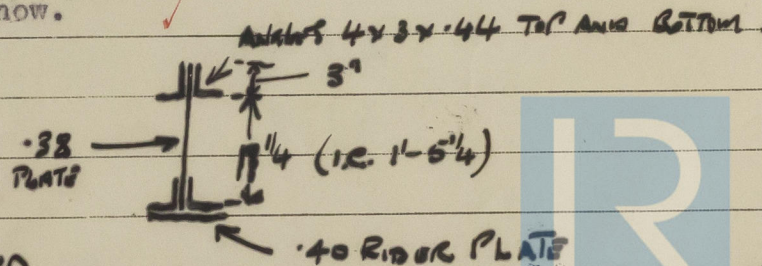

A. COPY HAS BEEN PLACED ON BOARD VESSEL.

© 2020

Lloyd's Register Foundation

20 SEP 1951

002305-002400-0069