
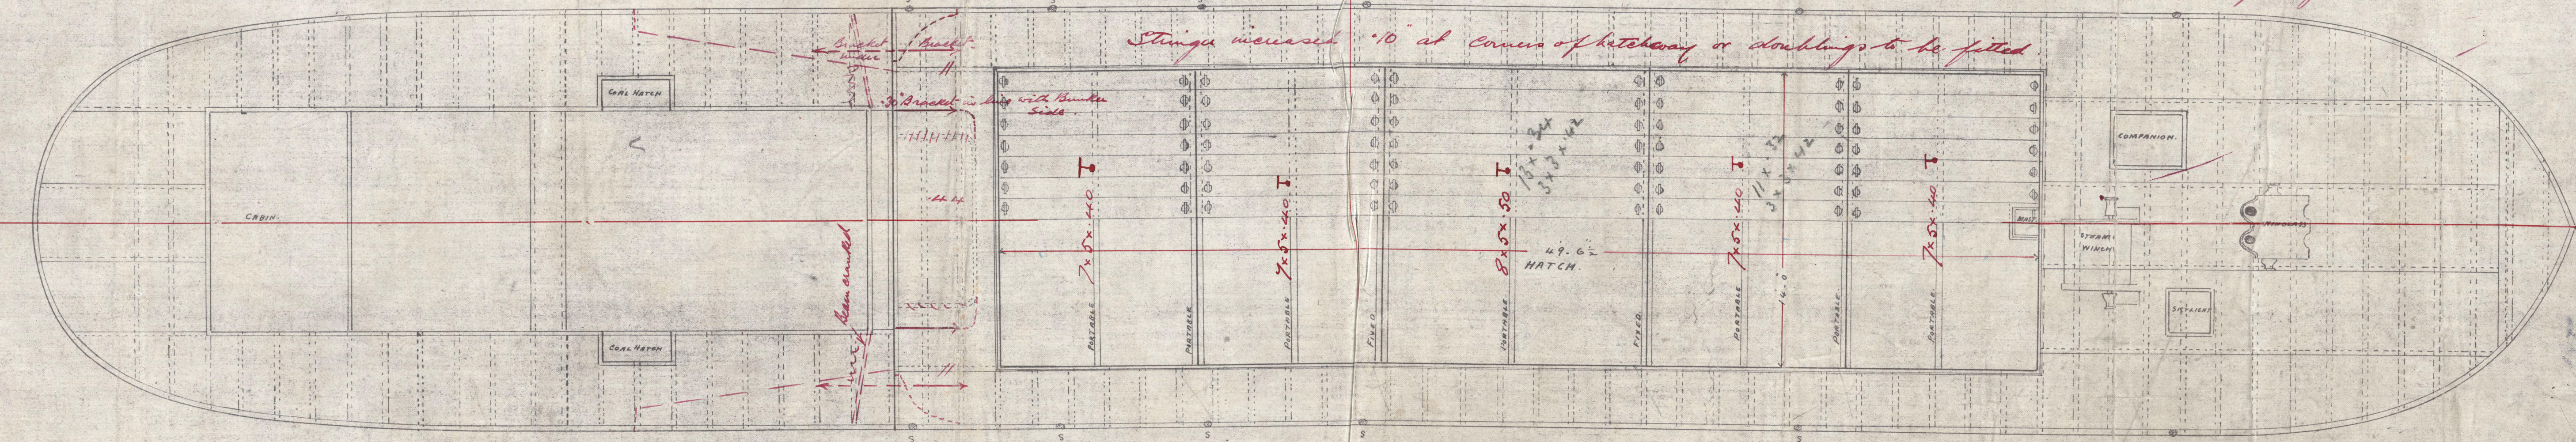


8-1-12
22-1-12

Transverse section
A.P. Tank
See enclosed plan
Attention A.P. Tank

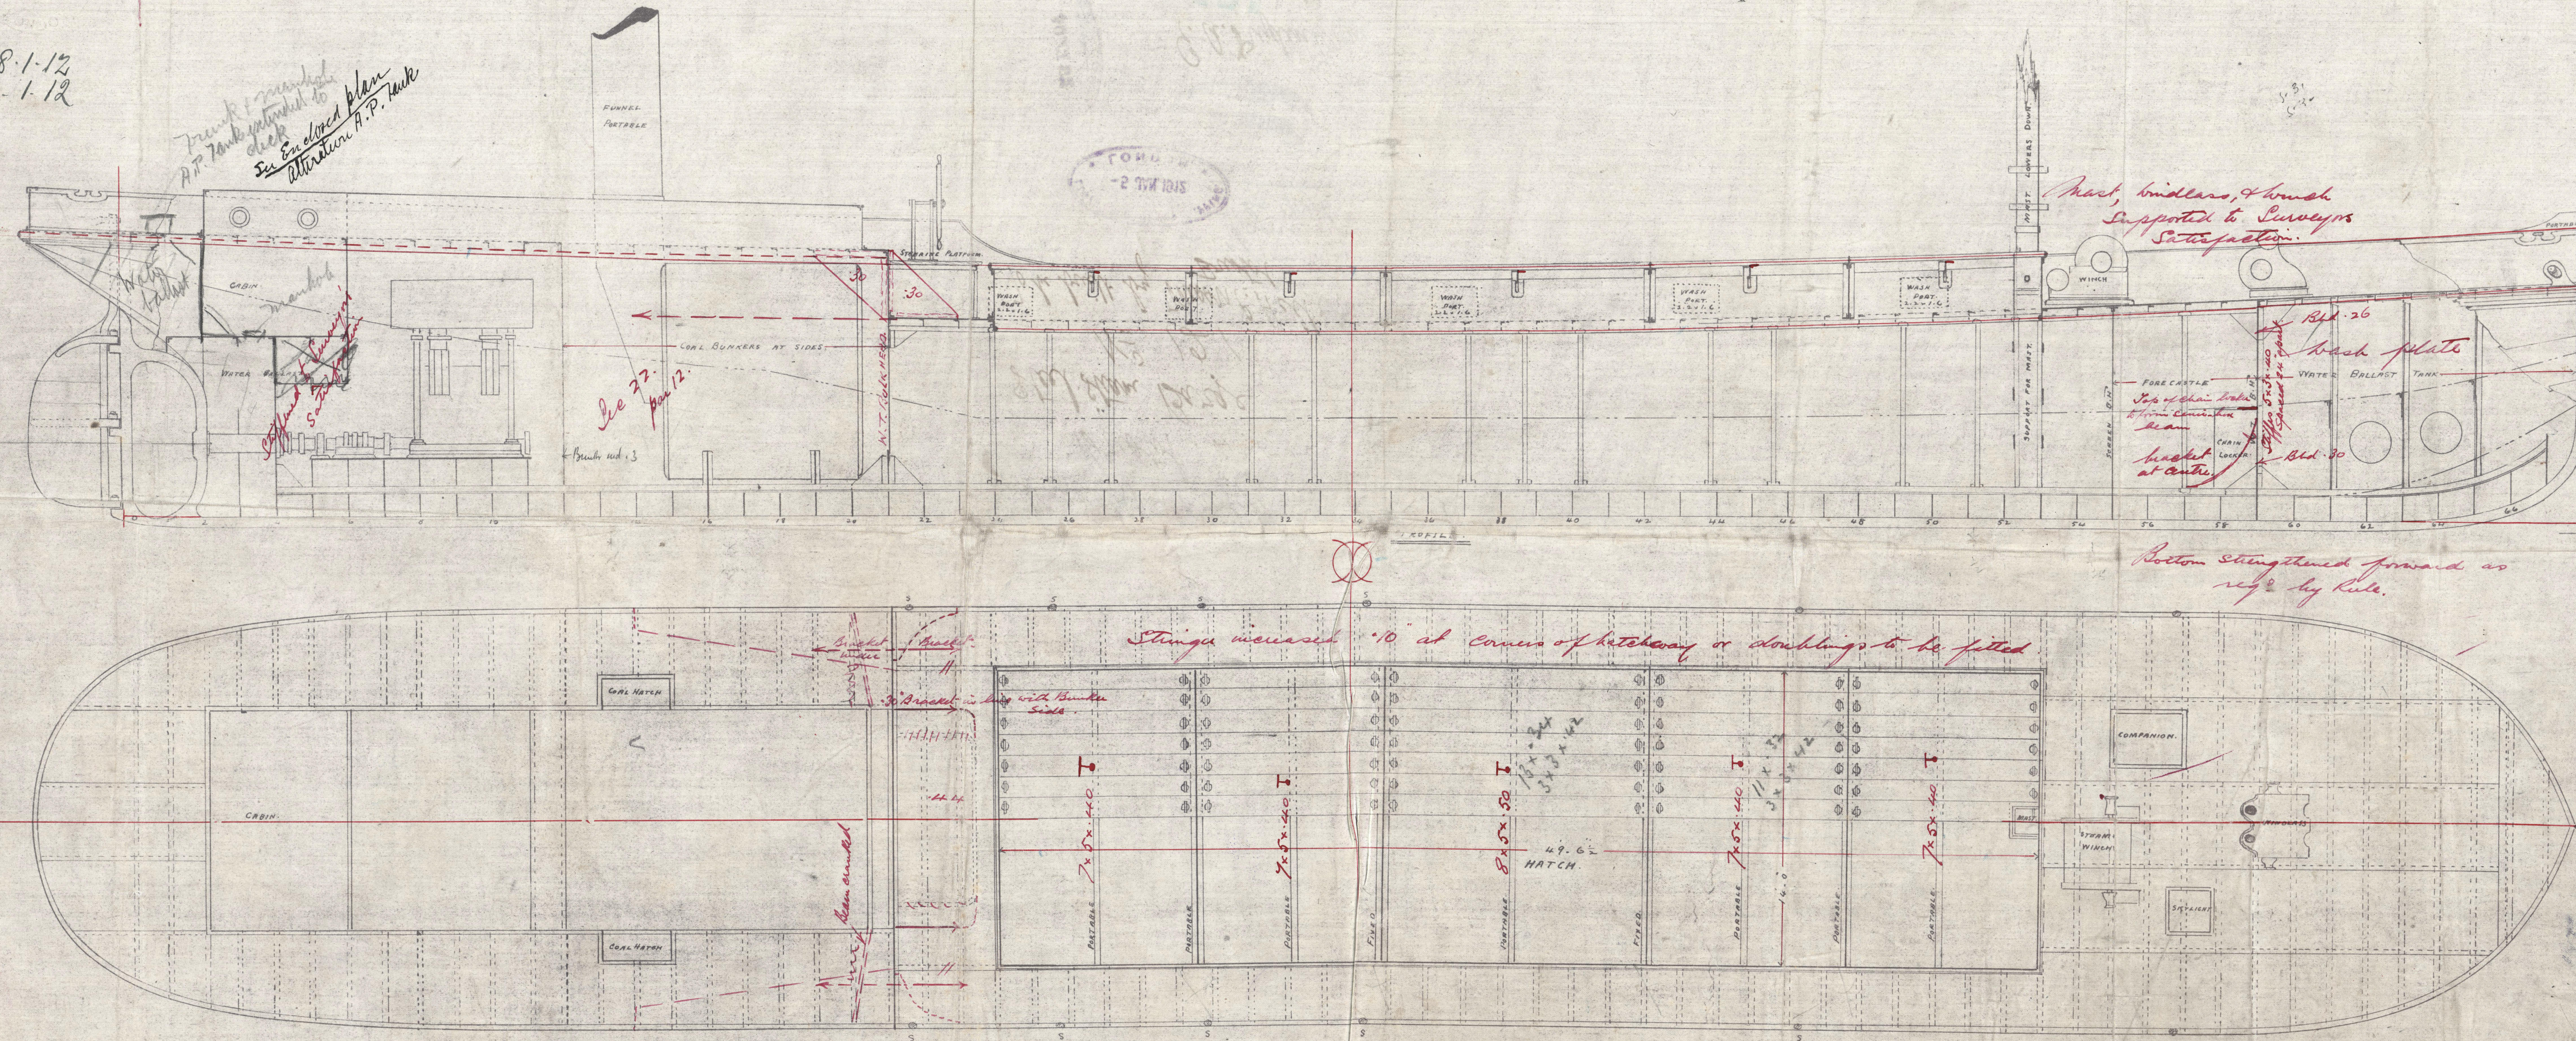

DECK PLAN.
Scale 1 inch per foot.

MIDSHIP SECTION. S.S. No 121.

CLASS.
TO CLASS 100A1st LLOYDS. FOR BRISTOL CHANNEL SERVICE.

Numerals.

Breadth	19.92
Depth	8.75
Length	116.75
36.35 x 3.15	118.07
3465.27	Equipment No.

Proportions.

116.75 ÷ 8.75	= 13.34 Depth.
116.75 ÷ 19.92	= 5.86 Breadth.


Depth 1.

To Main Deck	= 7.7
To R.O.D.	= 10.10

DIMENSIONS.

Length On all	121 ft.
Length B.P.	116 ft. 9 in.
Breadth Moulded	19 ft. 11 in.
Depth	8 ft. 9 in.

Round of Beam 5"

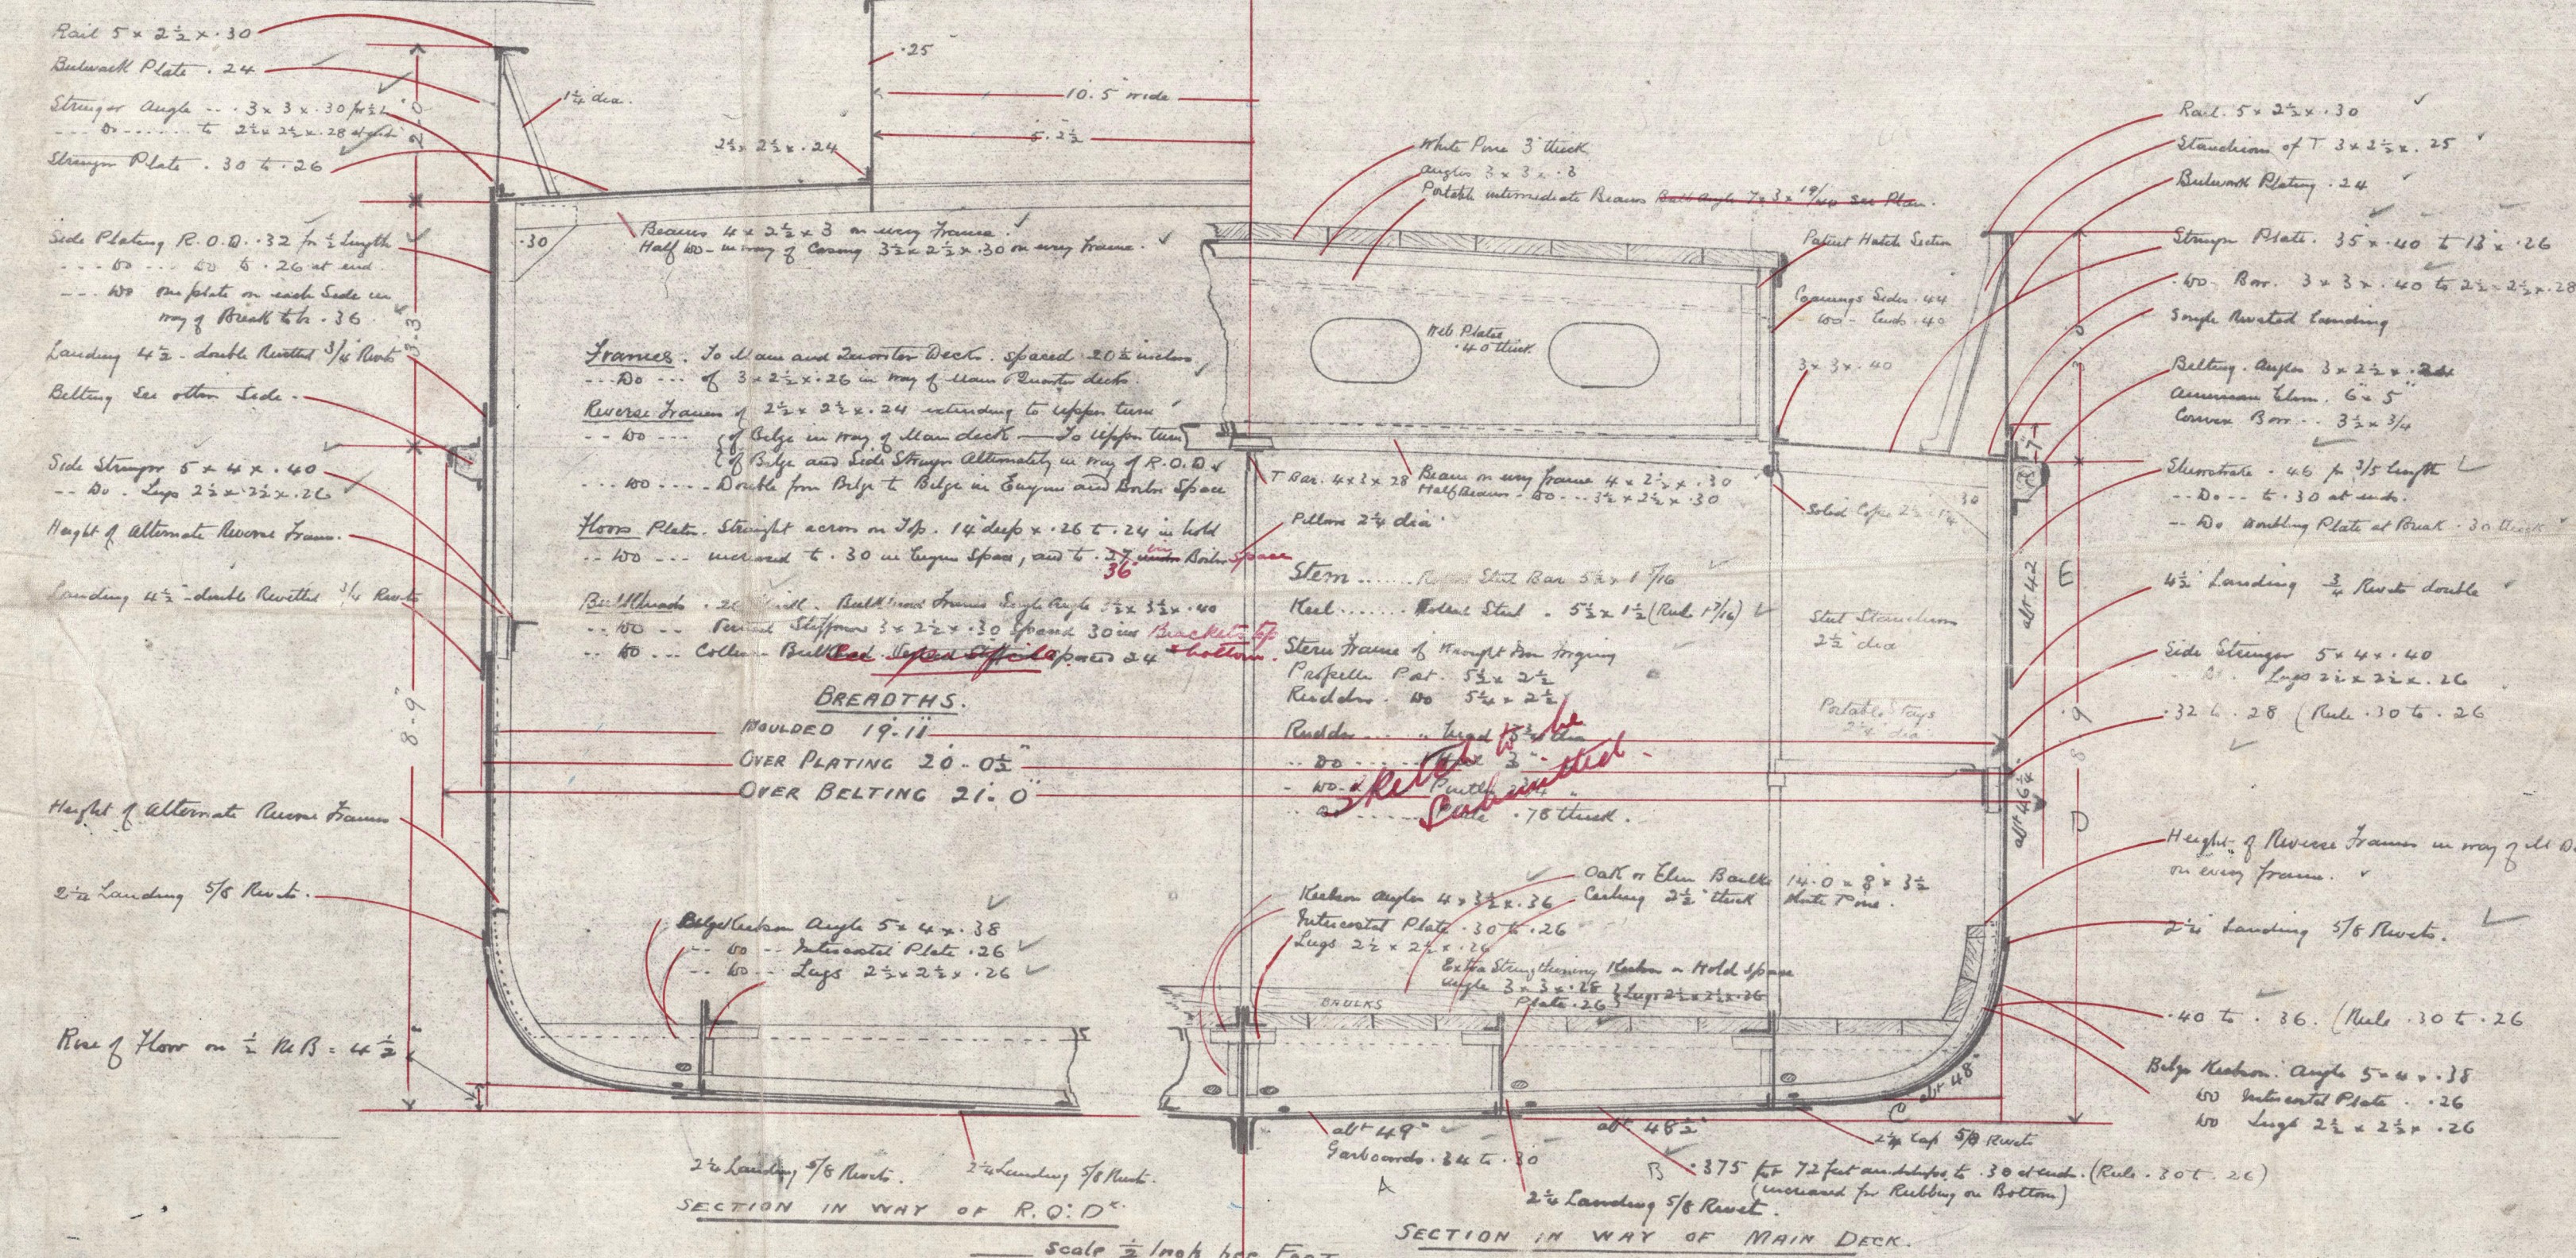

SECTION IN WAY OF MAIN DECK.
Scale 1/2 inch per foot.

CHARLES HILL & SONS.
ALBION DOCKYARD
BRISTOL.

Equipment.

1 Bow Anchor	5.0
1 Stem	5.0
1 Hinge	2.0
120 fathoms	1/2 inch Lead Chain Cable
45	1/4 inch Lead Chain Cable
75	1/4 inch Lead Chain Cable
100	1/4 inch Lead Chain Cable
100	1/4 inch Lead Chain Cable
30	1/4 inch Lead Chain Cable



SECTION IN WAY OF MAIN DECK.
Scale 1/2 inch per foot.

Swelling

Midship + Profile


Bristol. 4-1-12.

Steel steam Barge

N^o 121

To be built by Messrs. P. Hill & Sons,
Bristol

ss. "Fennic"
Br. 9076.

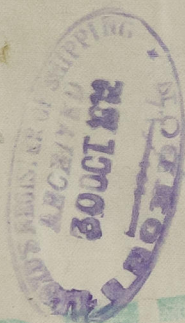

4 - NOV. 1911

G. A. Dryden Torque

4-1-12



002385-002400-0080



© 2020

Lloyd's Register
Foundation