

MIDSHIP SECTION.

SCALE $\frac{1}{2}$ " = 1 FOOT

1	STOCKLESS ANCHOR	8 ¹ / ₂ CWTs
1	"	8 "
1	RODGERS	3 ¹ / ₄ " EX STOCK
120	FATHOMS	1 ¹ / ₈ " STUD LINK CABLE
60	"	6" HAWSER
60	"	5" WARP


DIMENSIONS:- 14' 3" 4" BP x 24' 6" MLD x 14' 3" MLD

CLASS 100 A.1. STEEL STEAM TRAWLER

COOK, WELTON & GEMMELL LTD
SHIPBUILDERS
BEVERLEY.

LLOYDS NUMERALS.

$L \times D$	2042.45
$L \times (B + D)$	5554.04
D	14.25
$B + D$	38.75
$\frac{L}{B+D}$	10.01

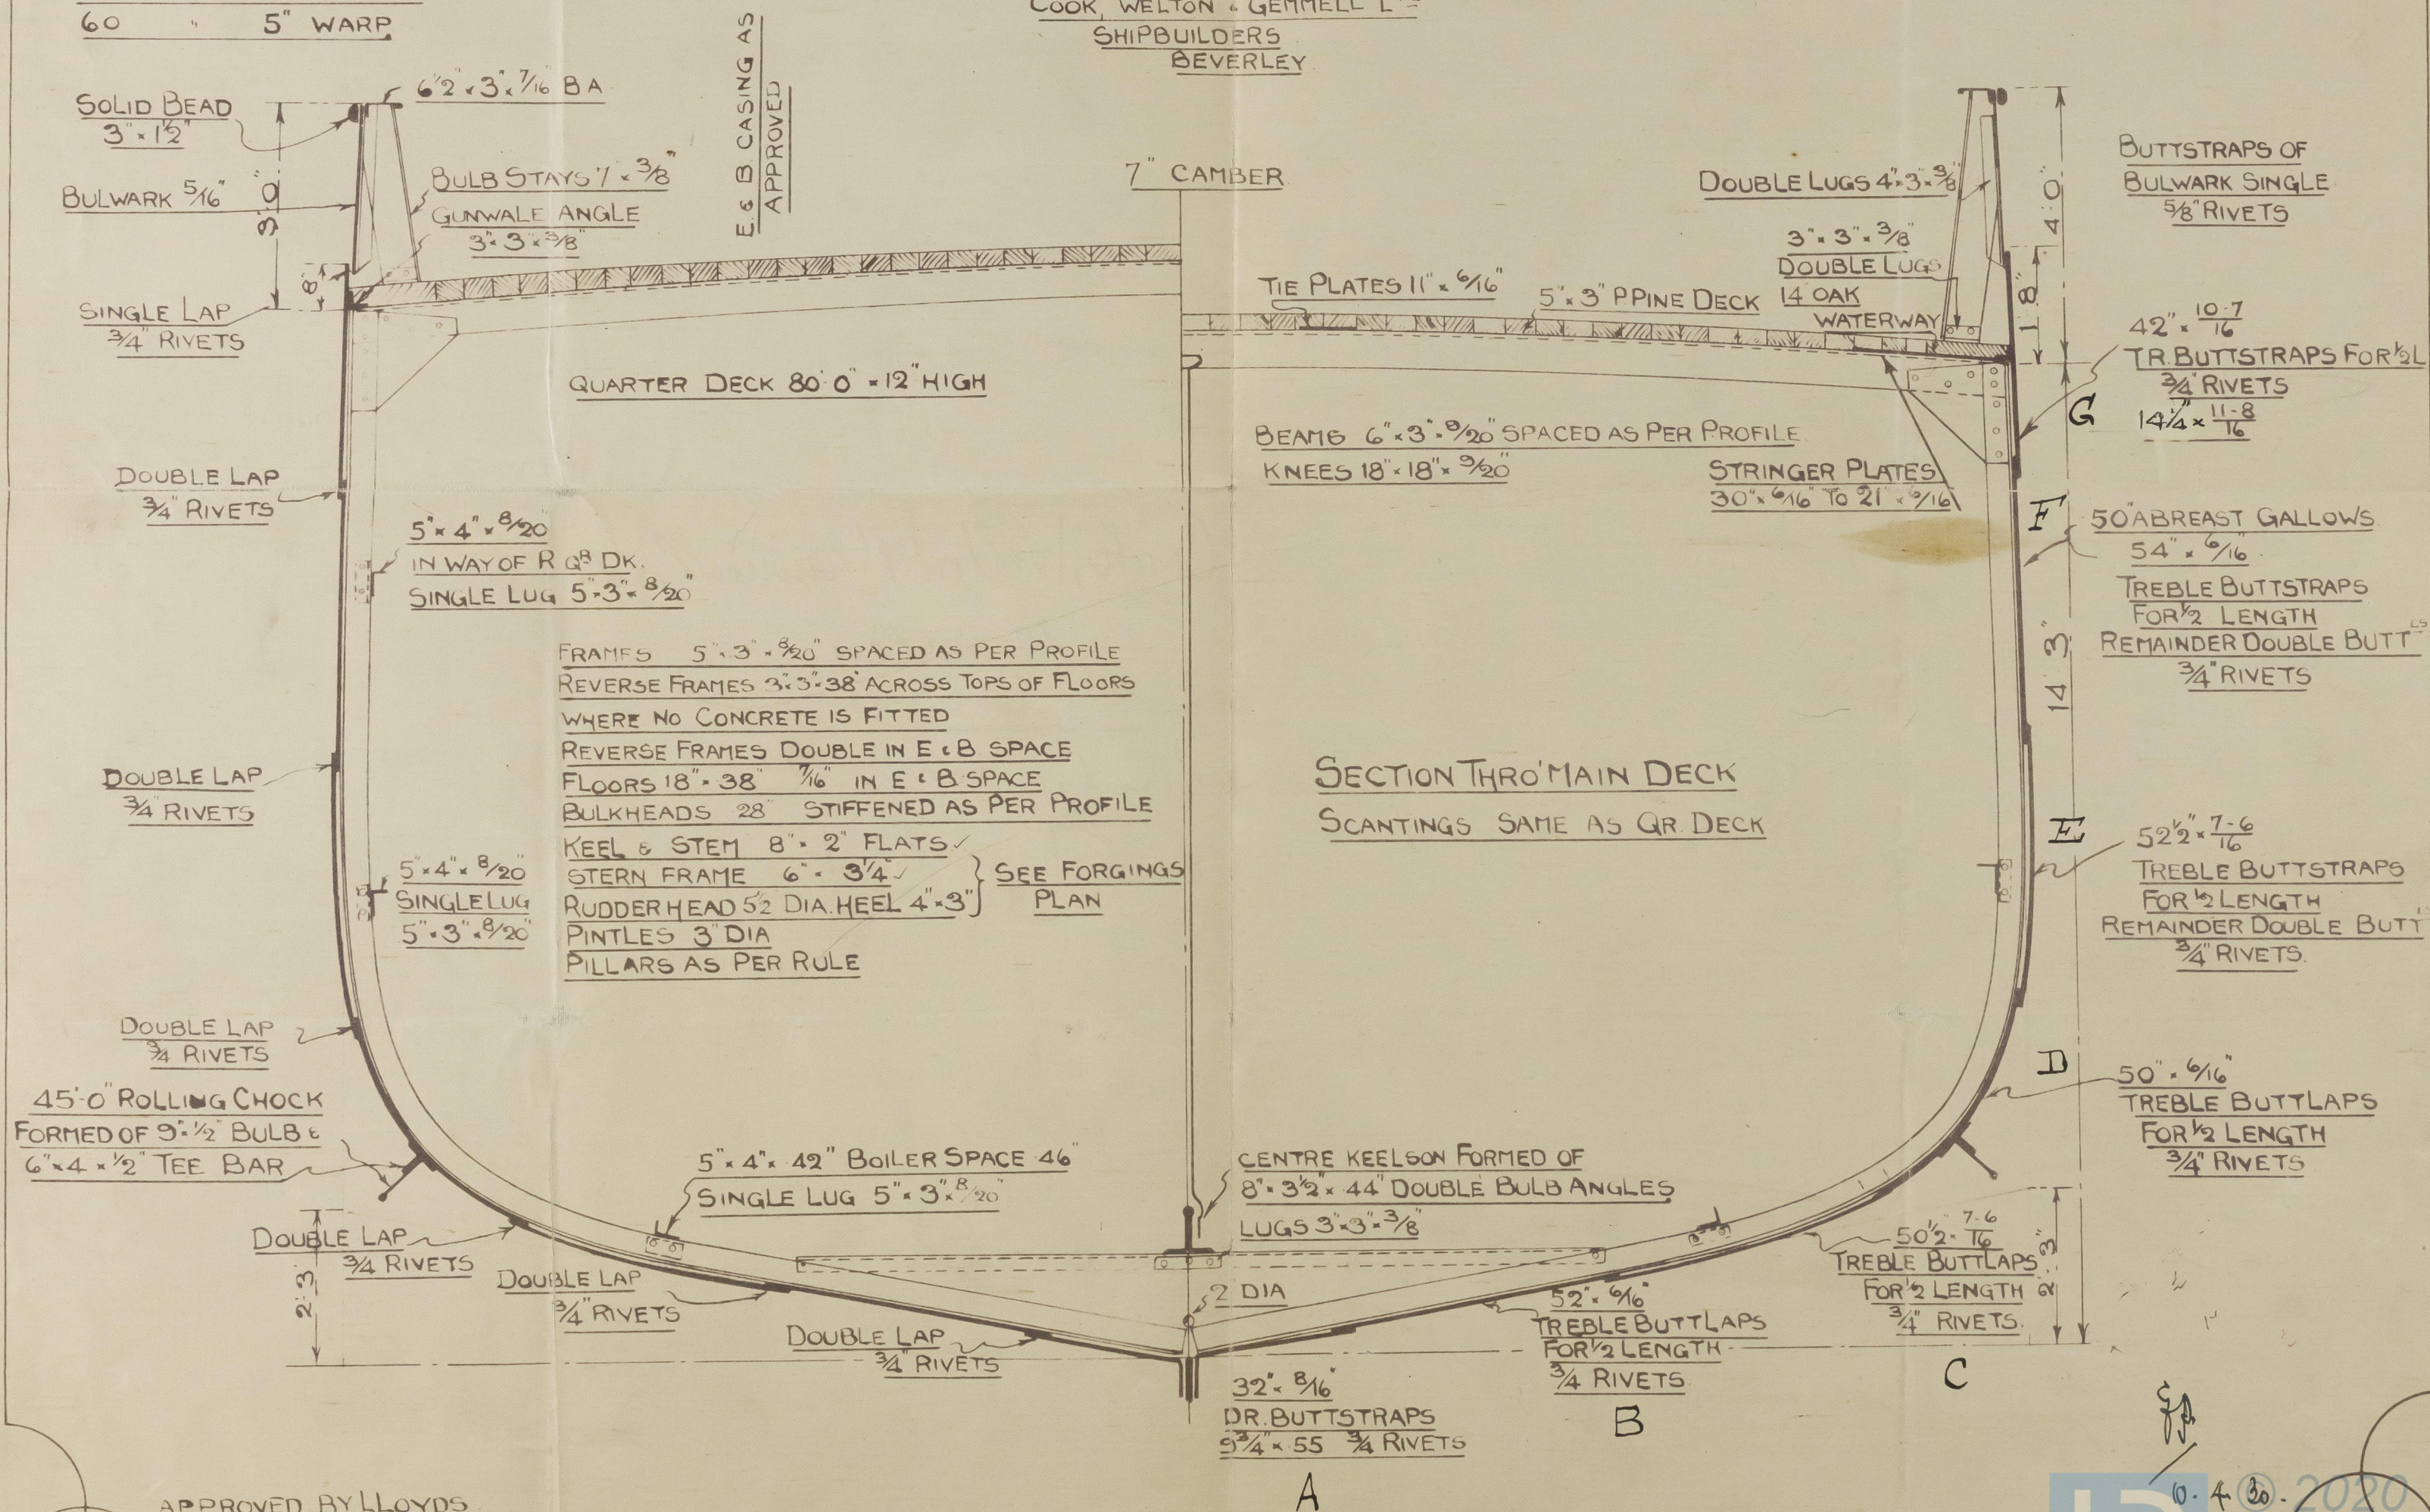

APPROVED BY LLOYDS

Cook, Welton & Gammell, Ltd..
Beverley

Midship Section
No. 551

"Etnusia"

ex.

S.S. "Lady Elsa"

HULL REPORT No. H1146

RETAIN

002385-002400-0120



© 2020

Lloyd's Register
Foundation