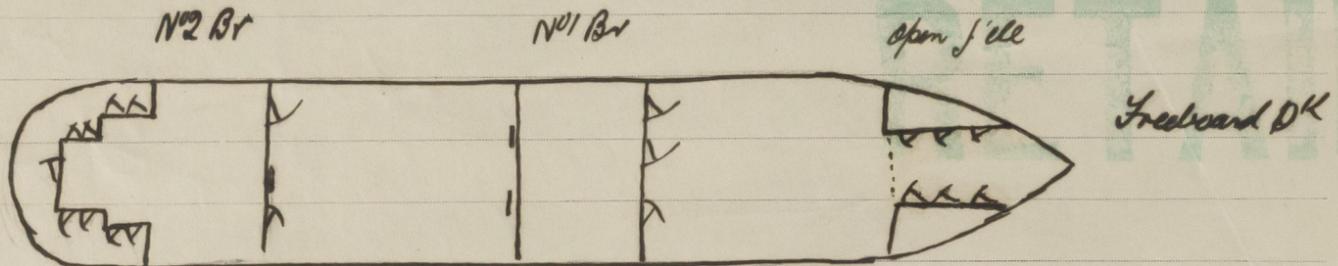


Lloyd's Register of Shipping.

Ship's Name *Geo W. McKnight*Official No. *166870*Memorandum of alterations reported since ship was surveyed for assignment of Load Lines
in *November 1932*

Forecastle *open*
 No 1 Br fore end *Hinged steel doors secured by turnbuckles operated both sides*
 No 1 Br after end *Two openings with portable steel plates and hook bolts*
 (Note:- One opening as originally rpt now permanently closed by riveted plate)
 No 2 Br fore end *two openings with hinged steel door* & &
one opening with steel plate secured with close spaced through bolts
 No 2 Br after end *9 hinged steel doors secured by turnbuckles operated both sides*

Flush scuttles :- *on freeboard deck aft of No 2 bridge, two flush scuttles to rope locker secured by rubber joint and toggles operated from under side.*

Companionways :- *Under open forecastle, within steel wing house, entrance to forward putup room, closed by hinged steel door secured by turnbuckles. operated both sides*
on No 2 bridge companionways steel, closed by hinged steel doors secured by turnbuckles operated both sides.

Hatchways :- *The hatchways, as originally reported, to fore peak and chain locker are within the open forecastle.*

Wm Salford
31st Oct 1939.