

23 MAY 1949

Index No. 24533
(For London Office only).


Lloyd's Register of Shipping.

SURVEYS FOR FREEBOARD.

(CONDITIONS OF ASSIGNMENT.)

Ship's Name S. S. EVERTONS Port of Survey BRERHAVEN.
 Official Number _____ Surveyor's Signature J. K. Katten
 Nationality and Port of Registry HONDURAN PUERTO CORTES Date of Survey 17th May 1949

Disposition and dimensions of superstructures, trunks, deckhouses and machinery casings to be inserted in the diagrams and tabular statement: --

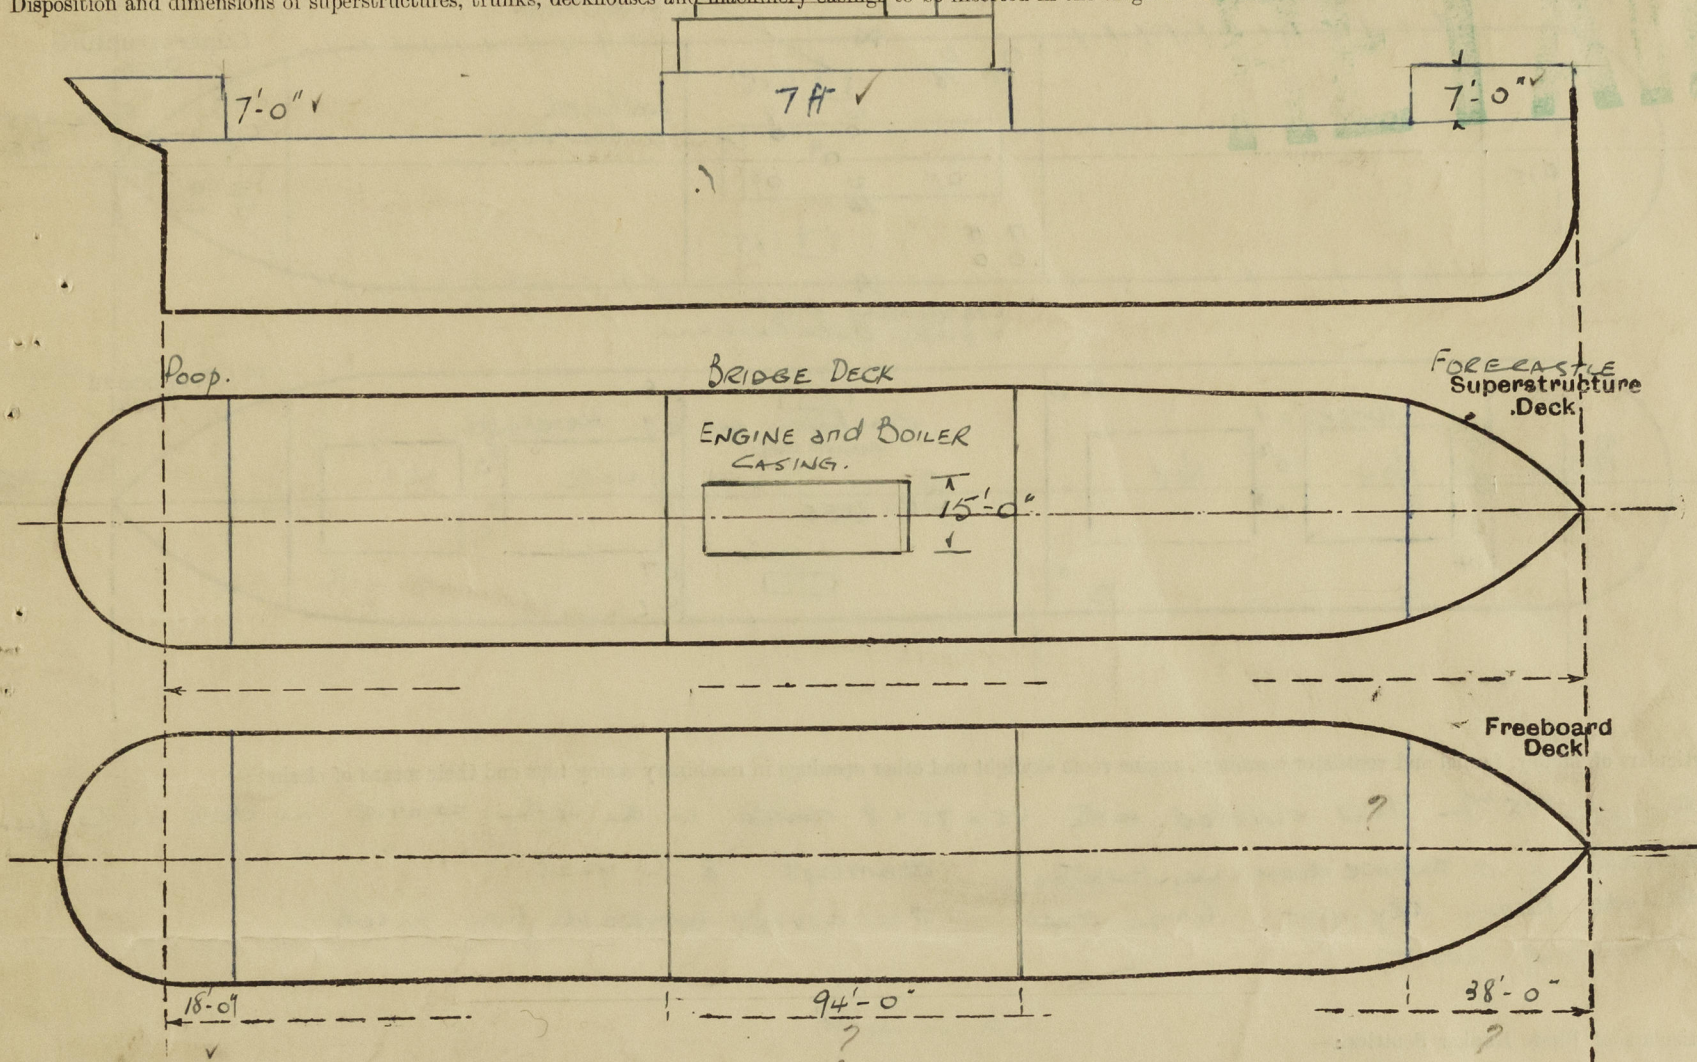

Particulars of Superstructures, Trunks, Casings, Deckhouses.


	Coaming	Plating	Stiffeners	Spacing	End Attachments of Stiffeners	Size of Openings	Height of Sills	Height of Casings
Poop Bulkhead ...	10 7/8"	10 7/8"	4 150 x 75 x 10	760 7/8"	None	1. 1700 x 660	380 1/2"	
Raised Quarter Deck Bulkhead ...	—							
Bridge, After Bulkhead ...	8 7/8"	8 7/8"	4 100 x 75 x 10	660 - 820 7/8"	None	4. 1500 x 660	380 7/8"	
Bridge, Forward Bulkhead ...	11 7/8"	11 7/8"	2 250 x 100 x 12	760 7/8"	brackets 450 x 12 7/8"	2. 1500 x 970	380 7/8"	
Forecastle Bulkhead ...	8 7/8"	8 7/8"	4 100 x 75 x 10	760 7/8"	None		380 1/2"	
Trunk, Aft ...								
Trunk, Forward ...								
Exposed Machinery Casings on Freeboard or Raised Quarter Decks ...								
Exposed Machinery Casings on Superstructure Decks ...	8 7/8"	8 7/8"	4 75 x 50 x 6		brackets on alternate frames	—	150 7/8"	
Machinery Casings within Superstructures not fitted with Class I Closing Appliances ...	8 7/8"	6 3/4"	4 75 x 75 x 6	650 7/8"	brackets	1. 1700 x 660 each side.	380 7/8"	
Deckhouses on Flush Deck Ships ...								

Particulars of Closing Appliances (state if capable of being manipulated from both sides).

Poop Bulkhead ...	1 wood door manipulated from both sides	X
Raised Quarter Deck Bulkhead ...	—	
Bridge, After Bulkhead ...	4 wood doors manipulated from both sides	X
Bridge, Forward Bulkhead ...	2 portable steel plates secured by bolts	X
Forecastle Bulkhead ...	4 wood doors manipulated from both sides	X
Exposed Machinery Casings on Freeboard or Raised Quarter Decks ...	—	
Exposed Machinery Casings on Superstructure Decks ...	Steel skylight with covers workable from inside	
Machinery Casings within Superstructures not fitted with Class I Closing Appliances ...		
Deckhouses on Flush Deck Ships ...		

PARTICULARS OF PROTECTION TO OPENINGS, ETC.

The following diagrams should be used to indicate the positions of cargo and coaling hatchways, gangway, cargo and coaling ports, ventilators, companionways, etc., which would affect the seaworthiness of the ship :—

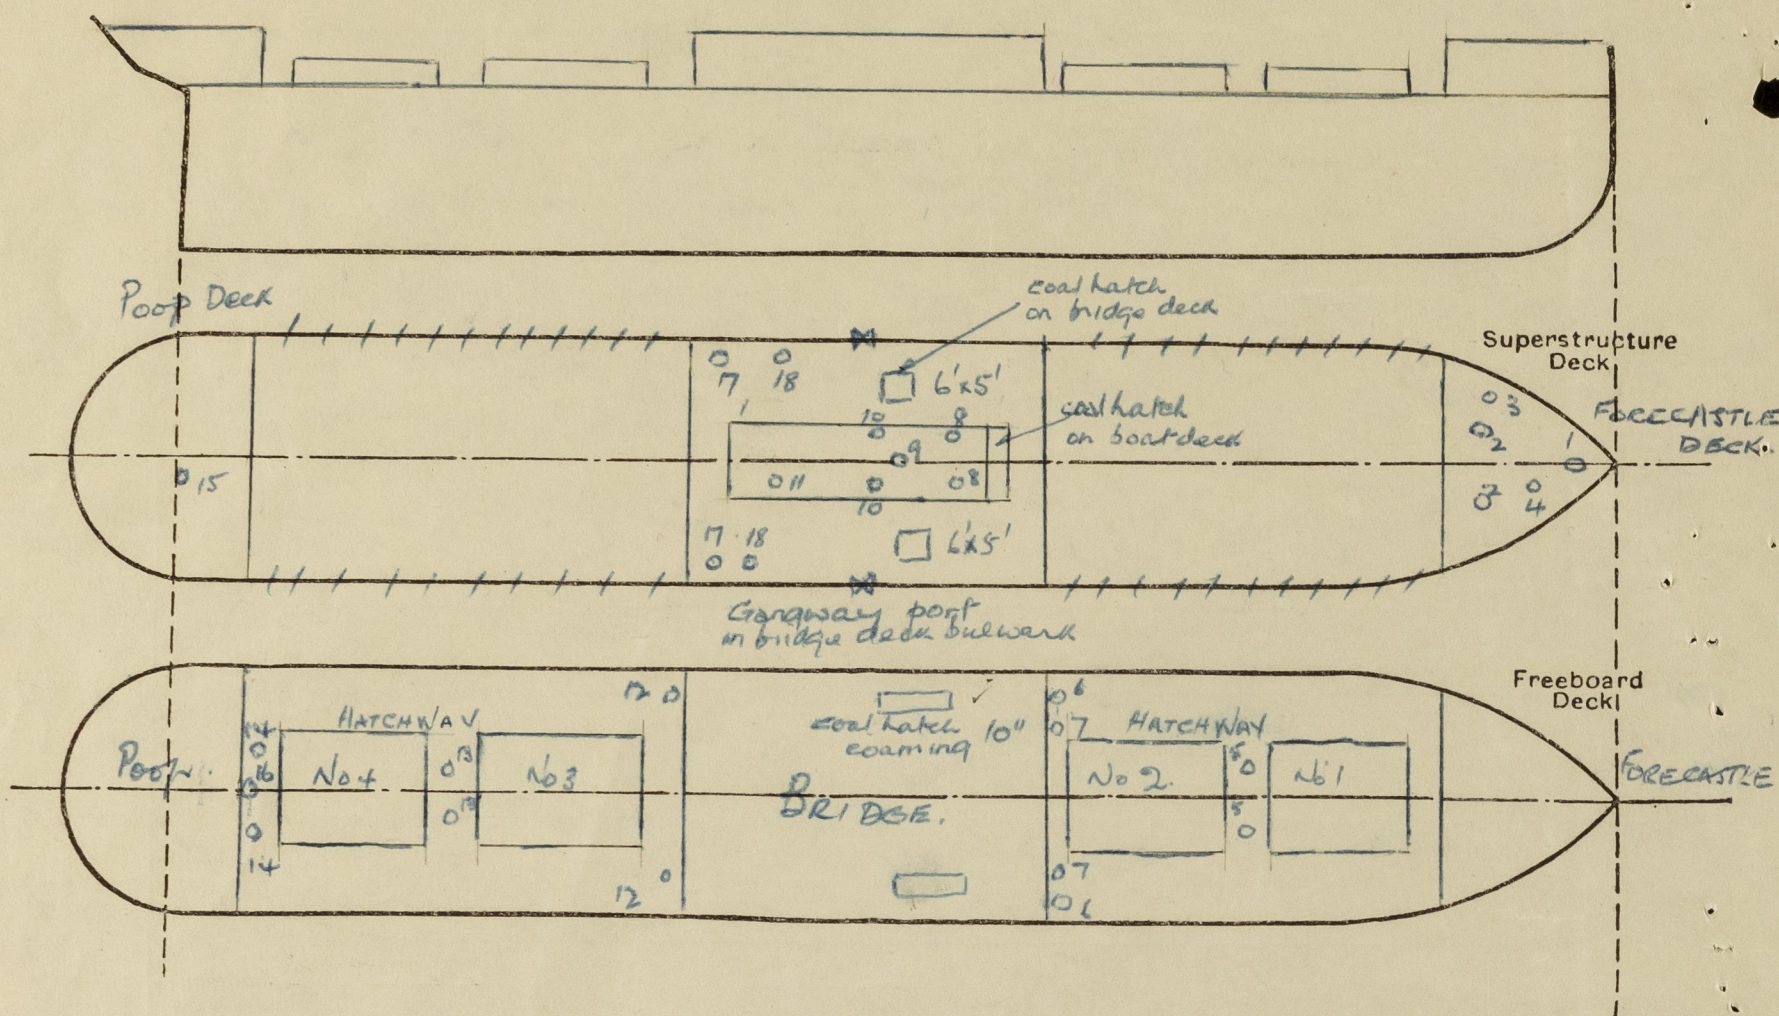

Particulars of fiddley, funnel and ventilator coamings, engine room skylight and other openings in machinery casing tops and their means of closing :—

Funnel 15" ϕ m steel riveted with 75 x 75 x 8 angle on the boiler casing no door in the funnel ✓
 Boiler and engine room ventilators: coamings 8" ϕ m steel ✓
 Engine Room SKYLIGHT 6' x 6' steel steel covers workable from inside ✓
 coaming 800 ϕ m ✓

Particulars of Flush Bunker Scuttles :—

Particulars of Companionways :—

Particulars of Ventilators in exposed positions on freeboard and superstructure decks :—

No	Particulars of ventilators	exposed positions on	treeboard and superstructure decks :-
1	1	ventilator	200
2	2		400
3	1		250
4	1		200
5	2		400
6	2		400
7	2		400
8	2		750
9	1		200
10	2		200
11	1		400
12	2		400
13	2		400
14	2		400
15	1		300

Particulars of Air Pipes in exposed positions on freeboard, raised quarter, or superstructure decks:—

Air pipes in the wells 1200 ft above freeboard deck
Air pipes on superstructures deck 1000 ft above deck

Particulars of Gangway Cargo and Coaling Ports:—

1 gangway port in the bridge deck bulwork
1000 x 1000 mm

no coaling posts. ✓

Particulars of Scuppers and Sanitary Discharge Pipes :—

his side scuttles below the freeboard deck,
In way of superfluous (excess space)
portable dead lights.

Particulars of Side Scuttles:—

Vertical distance of Sill of lowest Side Scuttle above top of keel

9.4 метр.

Particulars of Guard Rails :—

In way of the freeboard deck steel bulwark 1350 mm in height.
On fore-castle boat and poop deck handrails 1000 mm in height ✓
with 3 rails on Navigation bridge 1200 mm in height ✓

Particulars of Gangways, Lifelines, etc. :—

1. Gangway to be handled on both ship sides from bridge deck with davit on each side.

Particulars of Freeing Arrangements.						
	Length of Bulwark	Height of Bulwark	Size of Freeing Ports	Number each side	Area each side	Rule area each side
After Well	33.8 ✓	13.50 ✓	900 x 600 ✓	4 ✓	2.15 m ²	2.07 ✓
Forward Well	30.5 ✓	13.50 ✓	900 x 600 ✓	4 ✓	2.15 m ²	1.83 ✓

State position of each freeing port (After Well :—

(F. and A. position and height above deck edge) } Forward Well :— } $\frac{1}{3}$ of the area in the midship half of the well ✓

State whether the freeing ports are fitted with shutters, bars, or rails, and give particulars of such:— *hinged shutters*

Additional area where sheer is less than standard.

© 2020

Lloyd's Register
Foundation

002401-002409-0024 $\frac{2}{2}$

PARTICULARS OF PROTECTION TO OPENINGS, ETC.

HATCHWAYS ON FREEBOARD AND SUPERSTRUCTURE DECKS.										
Description of Hatchway			No 1	No 2	No 3	No 4				
Dimensions of Hatchway			9800 x 5500	10250 x 5500	10250 x 5500	9800 x 5500				
COAMINGS	{	Height above Deck	800 mm	800 mm	800 mm	800 mm				
		Thickness	12 mm	12	12	12				
		Sides								
		Ends								
Stiffeners			200 x 75 x 12							
Brackets, Stays			50 mm dia	brackets		3 each side				
HATCH BEAMS	{	Number	6	6	6	6				
		Spacing	1400	1460	1460	1400				
		Scantling and Sketch	Doubling in way of the bearing							
		Bearing Surface	100 x 32	100 x 32	100 x 32	100 x 32				
FORE AND AFTERS	{	Number								
		Spacing								
		Unsupported Lengths								
		Scantling* and Sketch	None							
Bearing Surface										
HATCH COVERS	{	Material		PINE						
		Thickness	75 mm	75 mm	75 mm	75 mm				
		How fitted		Steel sheathed						
		Bearing Surface	100 mm	100 mm	100 mm	100 mm				
Spacing of Cleats			500	500	500	500				
Number of Tarpaulins			2	2	2	2				
<p>*Are wood fore and afters steel shod at all bearing surfaces? — ?</p> <p>Are battens and wedges efficient and in good condition? — ?</p> <p>Are tarpaulins in good condition and in accordance with rule requirements? — ?</p> <p>Are lashings provided in accordance with rule requirements? — ?</p>										

Particulars of any special features :—

Endorsement at first survey and at surveys for renewal of Certificate :—

The fittings and appliances are in accordance with the particulars shown on this form (or as now modified) and are in good condition.

