


Lloyd's Register of Shipping.

Ship's Name **EVERTONS**

Official No.

Memorandum of alterations reported since ship was surveyed for assignment of Load Lines
in **JULY 1932**

Forecastle bulkhead & overhang modified to ✓

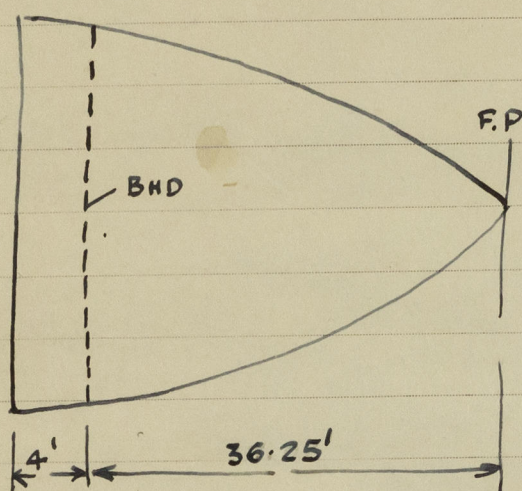

Closing appliances in superstructure and bulkheads as follows:-

- Pooh :- Hinged wood door - operated both sides. ✓
- Bridge aft end :- Hinged wood doors - operated both sides. ✓
- Bridge fore end :- Hinged steel doors - with clips operated from outside only. ✓
- Forecastle :- Hinged wood doors - operated from both sides. ✓

Companionways :- one each on pooh & forecastle decks removed
& openings plated over. X


Ventilator couplings fitted with steel and canvas covers.

Air pipes fitted with wood plugs & canvas covers. X

Extracted from Bremerhaven Surveyor's letter 4-6-49. ✓

21

16.6.49 2020

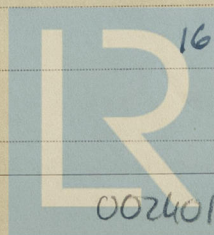

Lloyd's Register
Foundation