


VESSEL No 143.

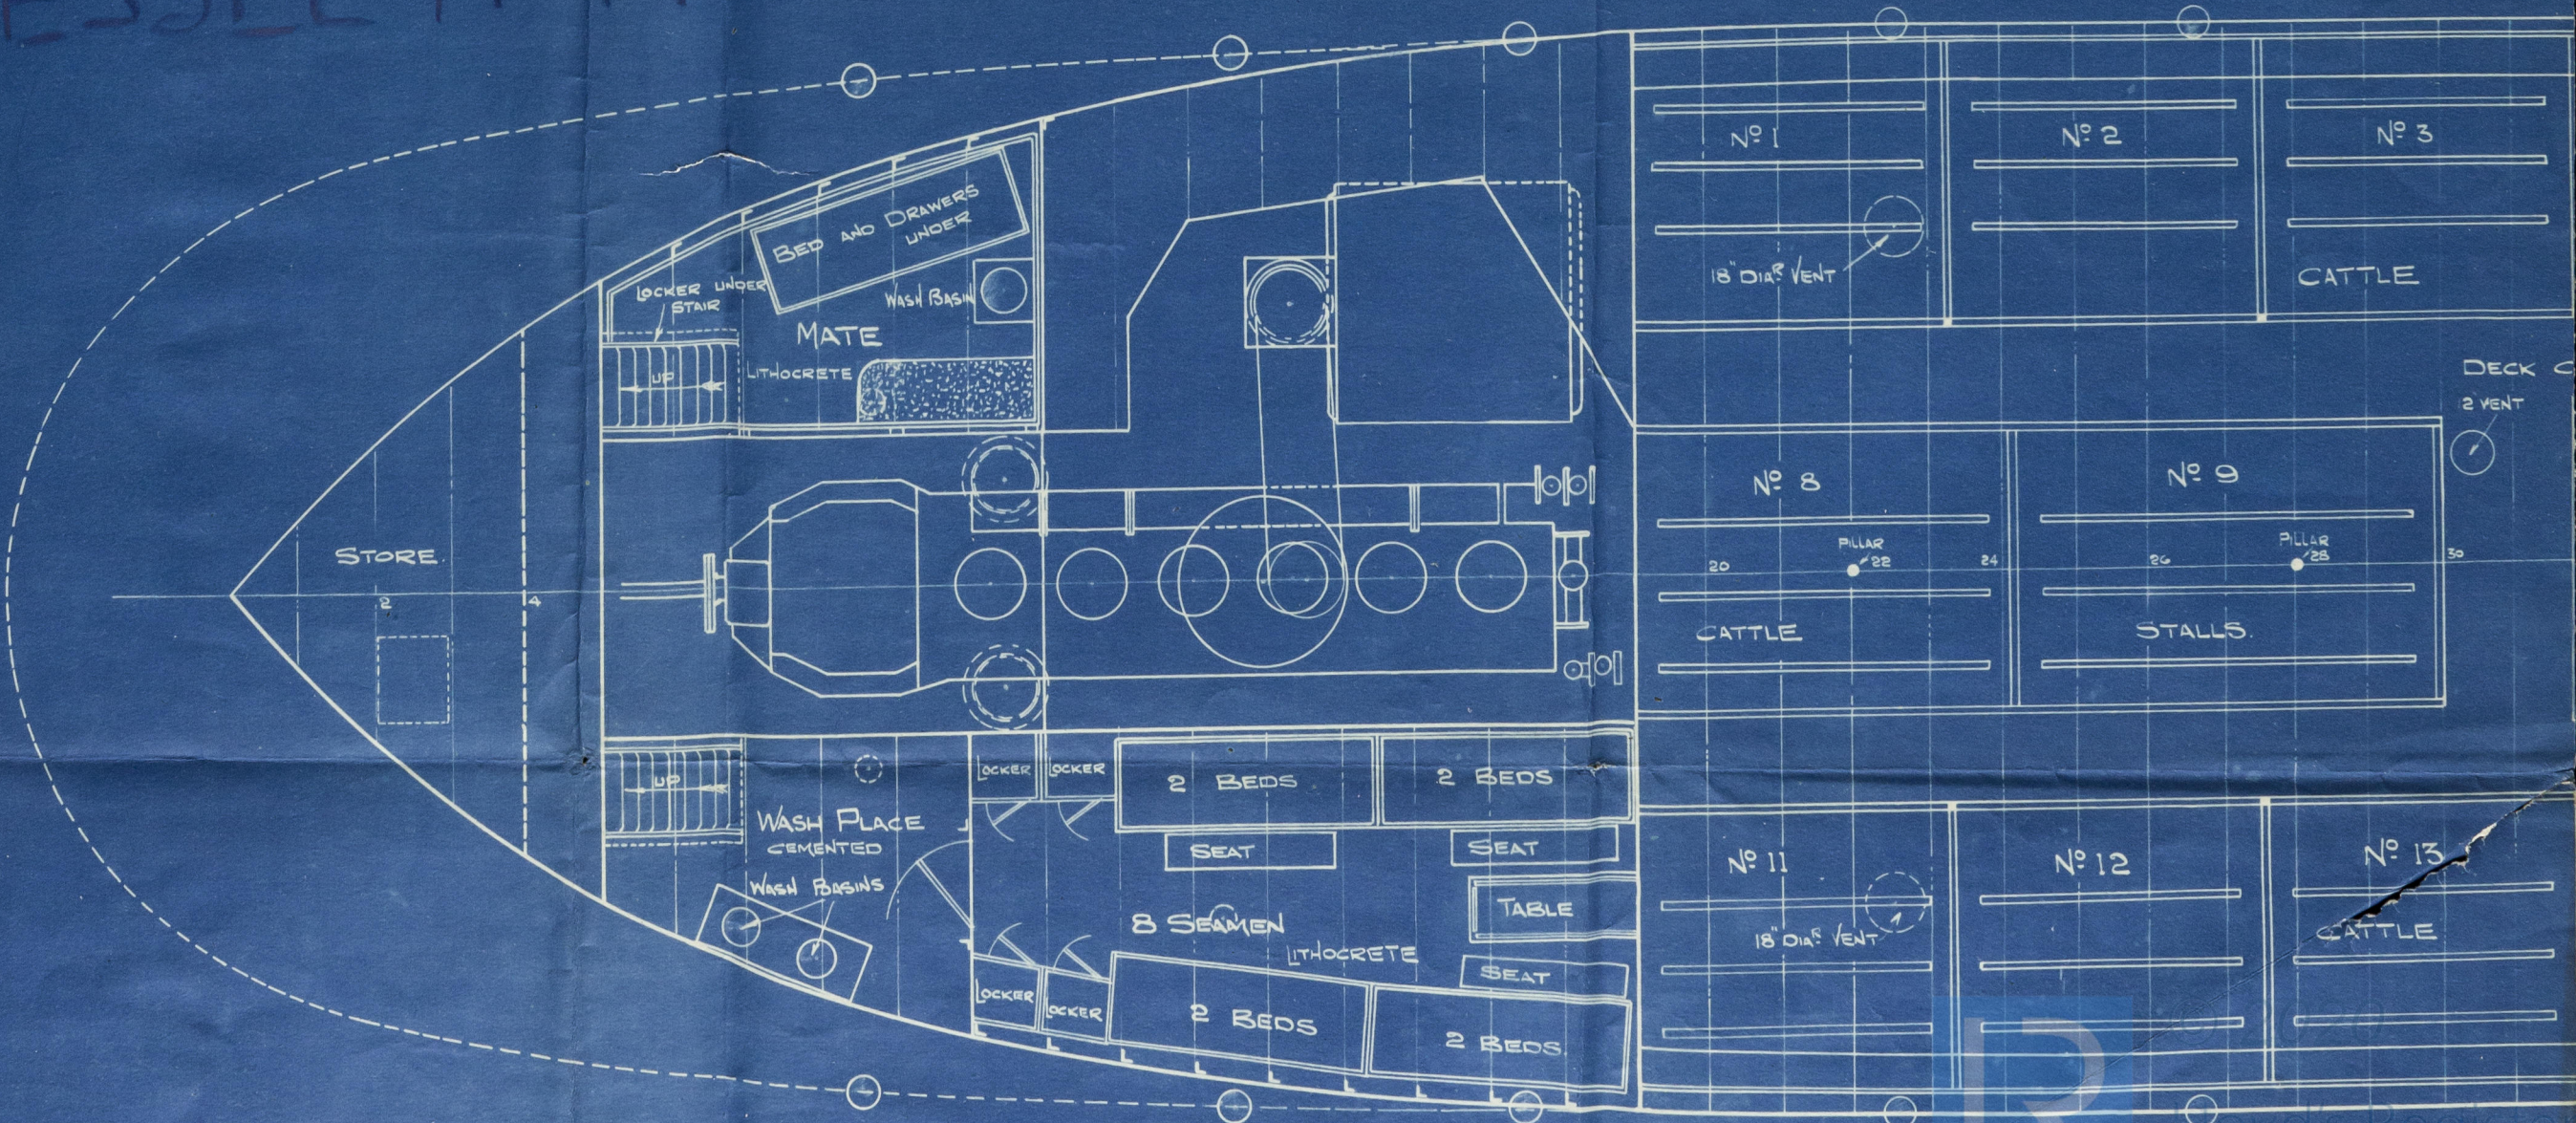

10

Aft. and General Arrgt.

Henry Robb, Ltd.

N^o 143.

Reference.

~~"Grenda"~~

S/o. "LOCHSHIEL"

RETAIN



© 2020

Lloyd's Register
Foundation

002401-002409-0088

14/8

Gen. Argt. - Aft.

Hobb 143

Hull bag



© 2020

Lloyd's Register
Foundation